
# RECORD OF SURVEY PART OF THE NORTHWEST QUARTER OF SECTION 9, TOWNSHIP 5 NORTH, RANGE 1 WEST, SALT LAKE BASE & MERIDIAN, U.S. SURVEY SOUTH OGDEN CITY, WEBER COUNTY, UTAH JUNE, 2022 LINE TABLE C. CENTERLINE MONUMENT C. 

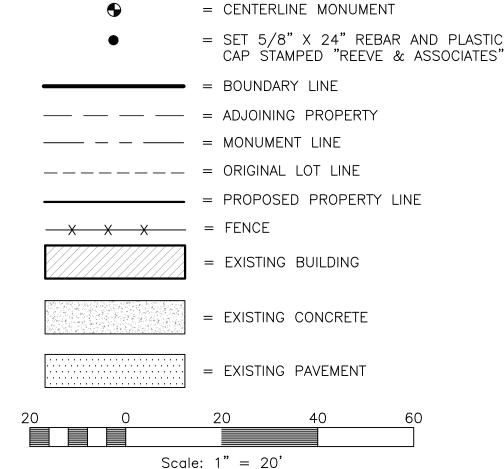

# **BASIS OF BEARINGS**

THE BASIS OF BEARINGS FOR THIS PLAT IS THE MONUMENT LINE BETWEEN TWO MONUMENTS FOUND IN THE CENTERLINE OF THE INTERSECTION OF 4ND STREET AND MADISON AVENUE AND 42ND STREET AND JEFFERSON AVENUE LOCATED IN NORTHWEST CORNER OF SECTION 9, TOWNSHIP 5 NORTH, RANGE 1 WEST, SALT LAKE BASE & MERIDIAN, U.S. SURVEY. SHOWN HEREON AS: N89°02'00"W.

# **NARRATIVE**

THE PURPOSE OF THIS SURVEY IS TO ESTABLISH THE PROPERTY ON THE GROUND AND TO PREPARE A BOUNDARY LINE AGREEMENT BETWEEN PARCELS 06-051-0027 AND 06-051-0013. THE BOUNDARY WAS DETERMINED BY RETRACING GOODSELL ADDITION USING THE MONUMENTS SHOWN HEREON, WHICH MATCHES OCCUPATION VERY WELL.

## PARCEL A LEGAL DESCRIPTION

PART OF LOT 11, GOODSELL ADDITION, AS PER THE OFFICIAL PLAT THEREOF, BEING LOCATED IN THE NORTHWEST QUARTER OF SECTION 9, TOWNSHIP 5 NORTH, RANGE 1 WEST, SALT LAKE BASE AND MERIDIAN, U.S. SURVEY, MORE PARTICULARLY DESCRIBED AS FOLLOWS:

BEGINNING AT A POINT ON THE WESTERLY RIGHT—OF—WAY LINE OF LIBERTY AVENUE, SAID POINT BEING \$89°02'00"E 393.54 FEET AND N00°58'00"E 583.00 FEET FROM A FOUND CENTERLINE MONUMENT IN THE INTERSECTION OF 42ND STREET AND MADISON AVENUE (SAID CENTERLINE MONUMENT BEING \$89°02'00"E 760.64 FEET FROM A FOUND CENTERLINE MONUMENT IN THE INTERSECTION OF 42ND STREET AND JEFFERSON AVENUE); THENCE N89°02'00"W 200.97 FEET TO A POINT IN AN EXISTING FENCE LINE; THENCE N00°58'38"E ALONG SAID FENCE LINE 54.52 FEET; THENCE \$88°43'54"E 82.27 FEET; THENCE \$89°17'49"E 46.13 FEET; THENCE \$88°43'54"E 82.27 FEET; THENCE \$88°51'03"E 66.36 FEET TO A POINT ON THE WESTERLY RIGHT—OF—WAY LINE OF LIBERTY AVENUE; THENCE \$00°58'00"W ALONG SAID RIGHT—OF—WAY LINE 56.16 FEET TO THE POINT OF BEGINNING.

CONTAINING 11,045 SQUARE FEET OR 0.254 ACRES MORE OR LESS.

# PARCEL B LEGAL DESCRIPTION

ALL OF LOT 10 AND A PORTION OF LOT 11, GOODSELL ADDITION, AS PER THE OFFICIAL PLAT THEREOF, BEING LOCATED IN THE NORTHWEST QUARTER OF SECTION 9, TOWNSHIP 5 NORTH, RANGE 1 WEST, SALT LAKE BASE AND MERIDIAN, U.S. SURVEY, MORE PARTICULARLY DESCRIBED AS FOLLOWS:

BEGINNING AT A POINT ON THE WESTERLY RIGHT-OF-WAY LINE OF LIBERTY AVENUE, SAID POINT BEING S89°02'00"E 393.54 FEET AND N00°58'00"E 639.16 FEET FROM A FOUND CENTERLINE MONUMENT IN THE INTERSECTION OF 42ND STREET AND MADISON AVENUE (SAID CENTERLINE MONUMENT BEING S89°02'00"E 760.64 FEET FROM A FOUND CENTERLINE MONUMENT IN THE INTERSECTION OF 42ND STREET AND JEFFERSON AVENUE); THENCE N88°51'03"W 66.36 FEET; THENCE S72°27'31"W 6.53 FEET; THENCE N89°17'49"W 46.13 FEET; THENCE N88°43'54"W 82.27 FEET; THENCE N00°58'38"E 78.48 FEET; THENCE S89°02'00"E 200.95 FEET; THENCE S00°58'00"W 76.84 FEET TO THE POINT OF BEGINNING.

CONTAINING 15,682 SQUARE FEET OR 0.360 ACRES MORE OR LESS.

# SURVEYOR'S CERTIFICATE


I, TREVOR HATCH, DO HEREBY CERTIFY THAT I AM A PROFESSIONAL LAND SURVEYOR IN THE STATE OF UTAH IN ACCORDANCE WITH TITLE 58, CHAPTER 22, PROFESSIONAL ENGINEERS AND PROFESSIONAL LAND SURVEYORS ACT; AND THAT I HAVE COMPLETED A SURVEY OF THE PROPERTY DESCRIBED ON THIS PLAT IN ACCORDANCE WITH SECTION 17-23-17 AND HAVE VERIFIED ALL MEASUREMENTS, AND HAVE PLACED MONUMENTS AS REPRESENTED ON THIS PLAT. I FURTHER CERTIFY THAT THIS PLAT IS A CORRECT REPRESENTATION OF THE LAND SURVEYED AND HAS BEEN PREPARED IN CONFORMITY WITH THE MINIMUM STANDARDS AND REQUIREMENTS OF THE LAW.

SIGNED THIS 17th DAY OF \_\_\_\_\_May ,20 23 .

9031945

UTAH LICENSE NUMBER



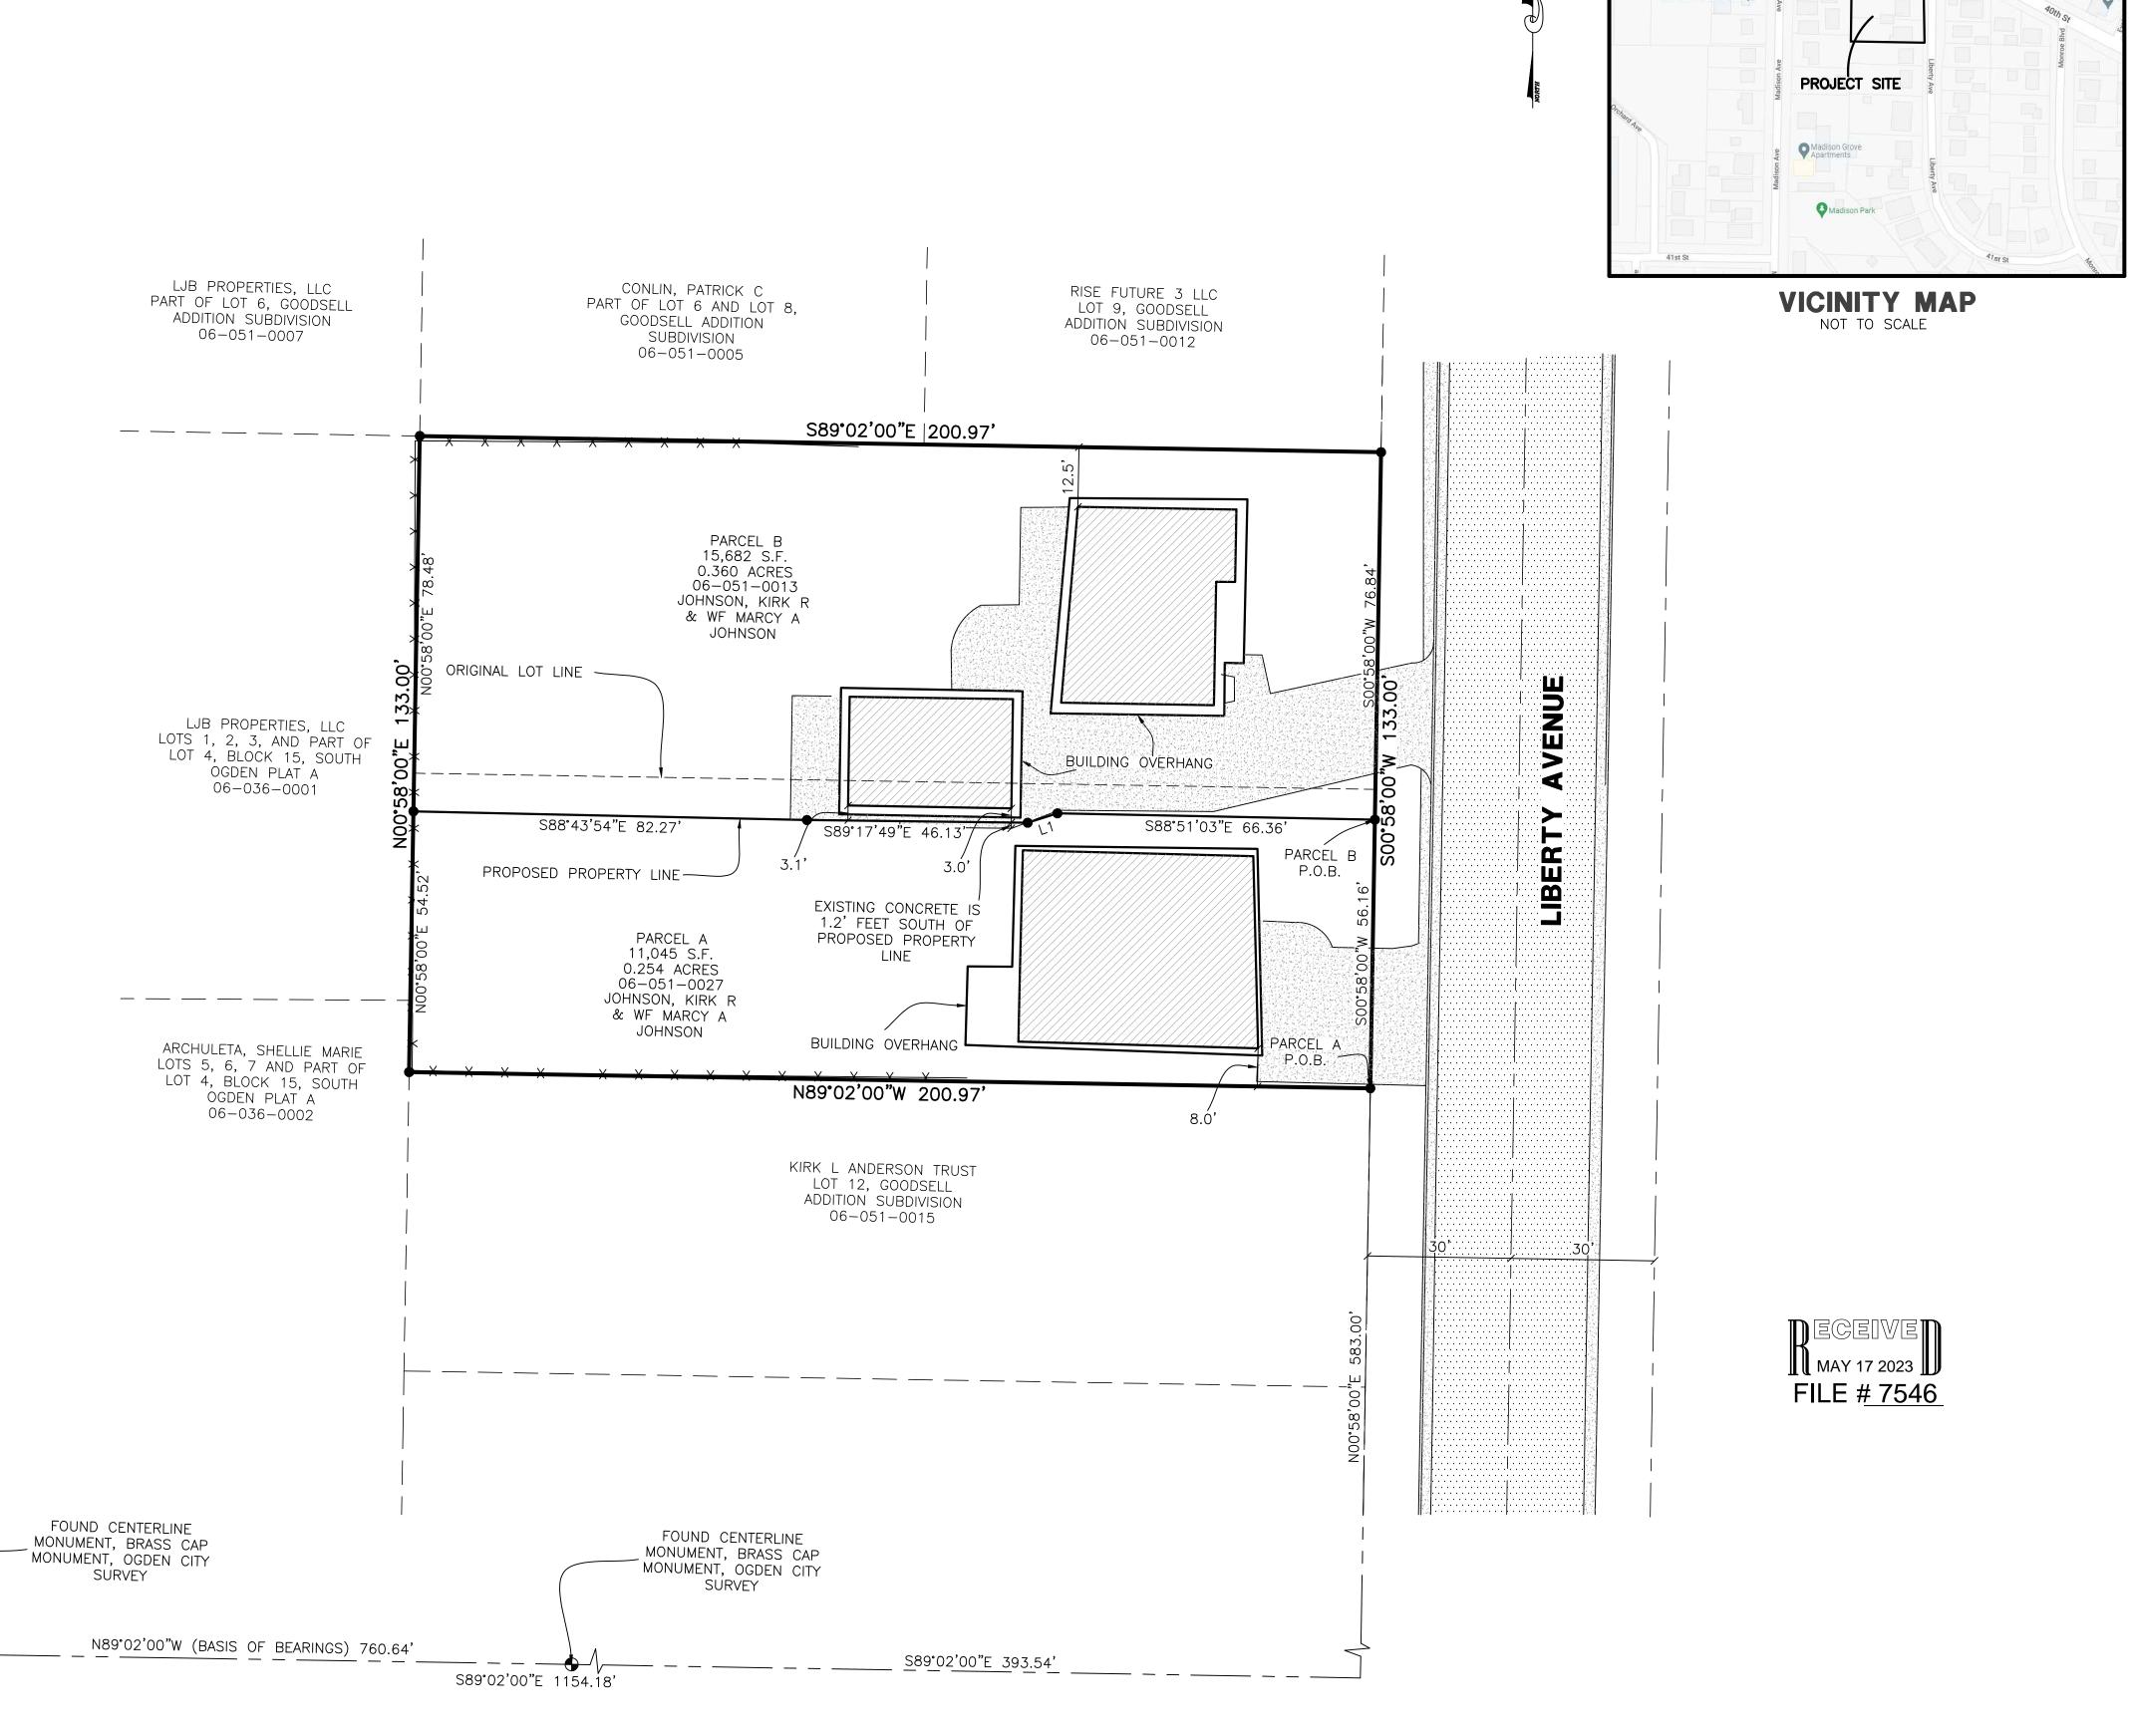

Reeve & Associates, Inc. - Solutions You Can Build On

75

0

4

CO

RE

Project Info.

A. MULLINS

6-1-2022

Name: KIRK JOHNSON

RECORD OF SURVEY

Number: <u>7979-01</u>

1"=20'

Sheets

Designer:

Scale: \_\_\_

Checked:

Sheet

Begin Date:

0