

T6N, R1W, S.L.B.&M.


AS SURVEYED COMBE ADJUSTMENT PARCEL BOUNDARY DESCRIPTION

A PART OF PARCEL 121020075 AND 121020076 LOCATED IN THE SOUTHWEST QUARTER OF SECTION 19, TOWNSHIP 6 NORTH, RANGE 1 WEST, OF THE SALT LAKE BASE AND MERIDIAN. BEGINNING AT A POINT ON THE NORTH RIGHT-OF-WAY LINE OF 17TH STREET BEING LOCATED NORTH 01°18'01" EAST 63.98 FEET ALONG THE MONUMENTED CENTERLINE OF GIBSON AVENUE AND NORTH 90°00'00" WEST 3920.75 FEET FROM THE OGDEN CITY CENTERLINE MONUMENT AT THE INTERSECTION OF 17TH STREET AND GIBSON AVENUE SAID POINT ALSO BEING NORTH 02°22'02" EAST 1002.67 FEET ALONG THE WEST LINE OF SAID SOUTHWEST QUARTER AND NORTH 90°00'00" EAST 1998.53 FEET FROM THE SOUTH WEST CORNER OF SAID SOUTHWEST QUARTER; RUNNING THENCE NORTH 01°25'25" EAST 473.94 FEET; THENCE SOUTH 89°47'32" EAST 214.85 FEET; THENCE SOUTH 01°18'09" EAST 287.31 FEET; THENCE NORTH 89°01'55" WEST 121.09 FEET;THENCE SOUTH 01°11'48" EAST 189.82 FEET TO SAID NORTH RIGHT-OF-WAY LINE; THENCE ALONG SAID NORTH RIGHT-OF-WAY LINE NORTH 89°01'56" WEST 116.07 FEET TO THE POINT OF BEGINNING. CONTAINING

AS SURVEYED POST ADJUSTMENT PARCEL BOUNDARY DESCRIPTION

A PART OF PARCEL 121020075, 121020076, AND ALL OF PARCEL 121020074 LOCATED IN THE SOUTHWEST QUARTER OF SECTION 19, TOWNSHIP 6 NORTH, RANGE 1 WEST, OF THE SALT LAKE BASE AND MERIDIAN. BEGINNING AT A POINT ON THE NORTH RIGHT-OF-WAY LINE OF 17TH STREET BEING LOCATED NORTH 02°22'02" EAST 1002.67 FEET ALONG THE WEST LINE OF SAID SOUTHWEST QUARTER AND NORTH 90°00'00" EAST 1998.53 FEET FROM THE SOUTH WEST CORNER OF SAID SOUTHWEST QUARTER; RUNNING THENCE ALONG SAID NORTH RIGHT-OF-WAY LINE NORTH 89°01'57" WEST 399.84 FEET TO THE BOUNDARY LINE OF THE COMBE 17TH STREET SUBDIVISION PHASE 2; THENCE ALONG THE BOUNDARY OF THE COMBE 17TH STREET SUBDIVISION PHASE 2 THE FOLLOWING THREE (3) COURSES: (1) NORTH 00°02'34" WEST 581.36 FEET; (2) SOUTH 89°54'54" WEST 225.70 FEET; (3) SOUTH 00°00'00" EAST 577.20 FEET TO SAID NORTH RIGHT-OF-WAY LINE; THENCE ALONG SAID NORTH RIGHT-OF-WAY LINE NORTH 89°01'56" WEST 66.01 FEET; THENCE NORTH 00°00'00" EAST 658.39 FEET; THENCE NORTH 77°28'12" WEST 186.44 FEET; THENCE NORTH 03°25'17" EAST 226.52 FEET; THENCE NORTH 40°13'21" EAST 420.05 FEET TO THE SOUTH LINE OF THE UNION PACIFIC RAILROAD; THENCE ALONG SAID SOUTH LINE THE FOLLOWING TWO (2) COURSES: (1) SOUTH 78°15'17" EAST 745.42 FEET; (2) ALONG THE ARC OF A 5783.41 FOOT RADIUS CURVE TO THE RIGHT 73.29 FEET, HAVING A CENTRAL ANGLE OF 00°43'34", CHORD BEARS SOUTH 78°49'56" EAST 73.29 FEET; THENCE SOUTH 01°18'09" EAST 618.58 FEET; THENCE NORTH 89°47'32" WEST 214.85 FEET; THENCE SOUTH 01°25'25" WEST 473.94 FEET TO THE POINT OF BEGINNING. CONTAINING 895,909 SQUARE FEET.

FILE # 7580

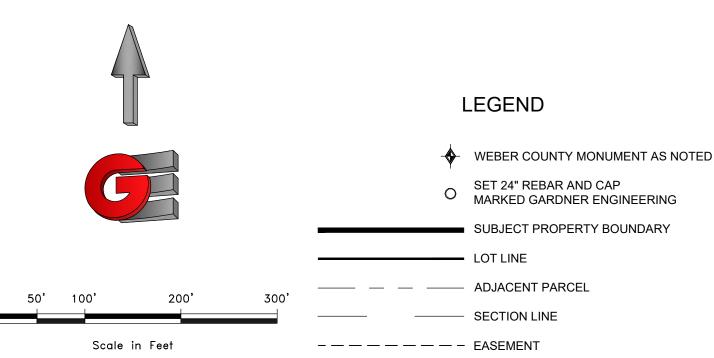


NARRATIVE

THE PURPOSE OF THIS SURVEY WAS TO ESTABLISH AND SET THE PROPERTY CORNERS OF THE PARCEL AS SHOWN AND DESCRIBED HEREON. THE SURVEY WAS ORDERED BY COREY COMBE. THE BASIS OF BEARING IS THE CENTERLINE LINE OF THE GIBSON AVENUE BETWEEN THE INTERSECTION OF 17TH STREET AND 13TH STREET, WHICH BEARS NORTH 01°18'01" EAST, WEBER COUNTY, UTAH NORTH, NAD 83 STATE PLANE GRID BEARING. THE BOUNDARY WAS DETERMINED BUY WARRANTY DEED RECORDED AS ENTRY NUMBER 2776983, AND DEEDS OF ADJOINING PROPERTY OWNERS. RECORD OF SURVEY NUMBERS 2670, 5027, 2001, AND THE DEDICATED PLATS OF COMBE 17TH STREET SUBDIVISION, COMBE 17TH STREET SUBDIVISION AMENDED, AND THE COREY WEST SUBDIVISION WERE ALSO USED TO DETERMINE BOUNDARY LOCATION ALONG WITH THE FOUND MONUMENTS AS SHOWN AND DESCRIBED

SURVEYOR'S CERTIFICATE

I, KLINT H. WHITNEY, DO HEREBY CERTIFY THAT I AM A LICENSED PROFESSIONAL LAND SURVEYOR IN THE STATE OF UTAH AND THAT I HOLD CERTIFICATE NO. 8227228 IN ACCORDANCE WITH TITLE 58, CHAPTER 22, OF THE PROFESSIONAL ENGINEERS AND LAND SURVEYORS ACT; I FURTHER CERTIFY THAT BY AUTHORITY OF THE OWNERS I HAVE COMPLETED A SURVEY OF THE PROPERTY DESCRIBED ON THIS RECORD OF SURVEY PLAT IN ACCORDANCE WITH SECTION 17-23-20 AND HAVE VERIFIED ALL MEASUREMENTS; THAT THE REFERENCE MONUMENTS SHOWN ON THIS RECORD OF SURVEY PLAT ARE LOCATED AS INDICATED AND ARE SUFFICIENT TO RETRACE OR REESTABLISH THIS SURVEY; AND THAT THE INFORMATION SHOWN HEREIN IS SUFFICIENT TO ACCURATELY ESTABLISH THE LATERAL BOUNDARIES OF THE HEREIN DESCRIBED TRACT OF REAL PROPERTY.

SIGNED THIS 31st DAY OF _

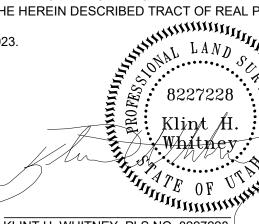

EXISTING FENCE LINE

S2

SLATERVILL

MARRIO

DRAWIN

EXHIBIT

900

KLINT H. WHITNEY, PLS NO. 8227228