


PROPERTY SURVEY

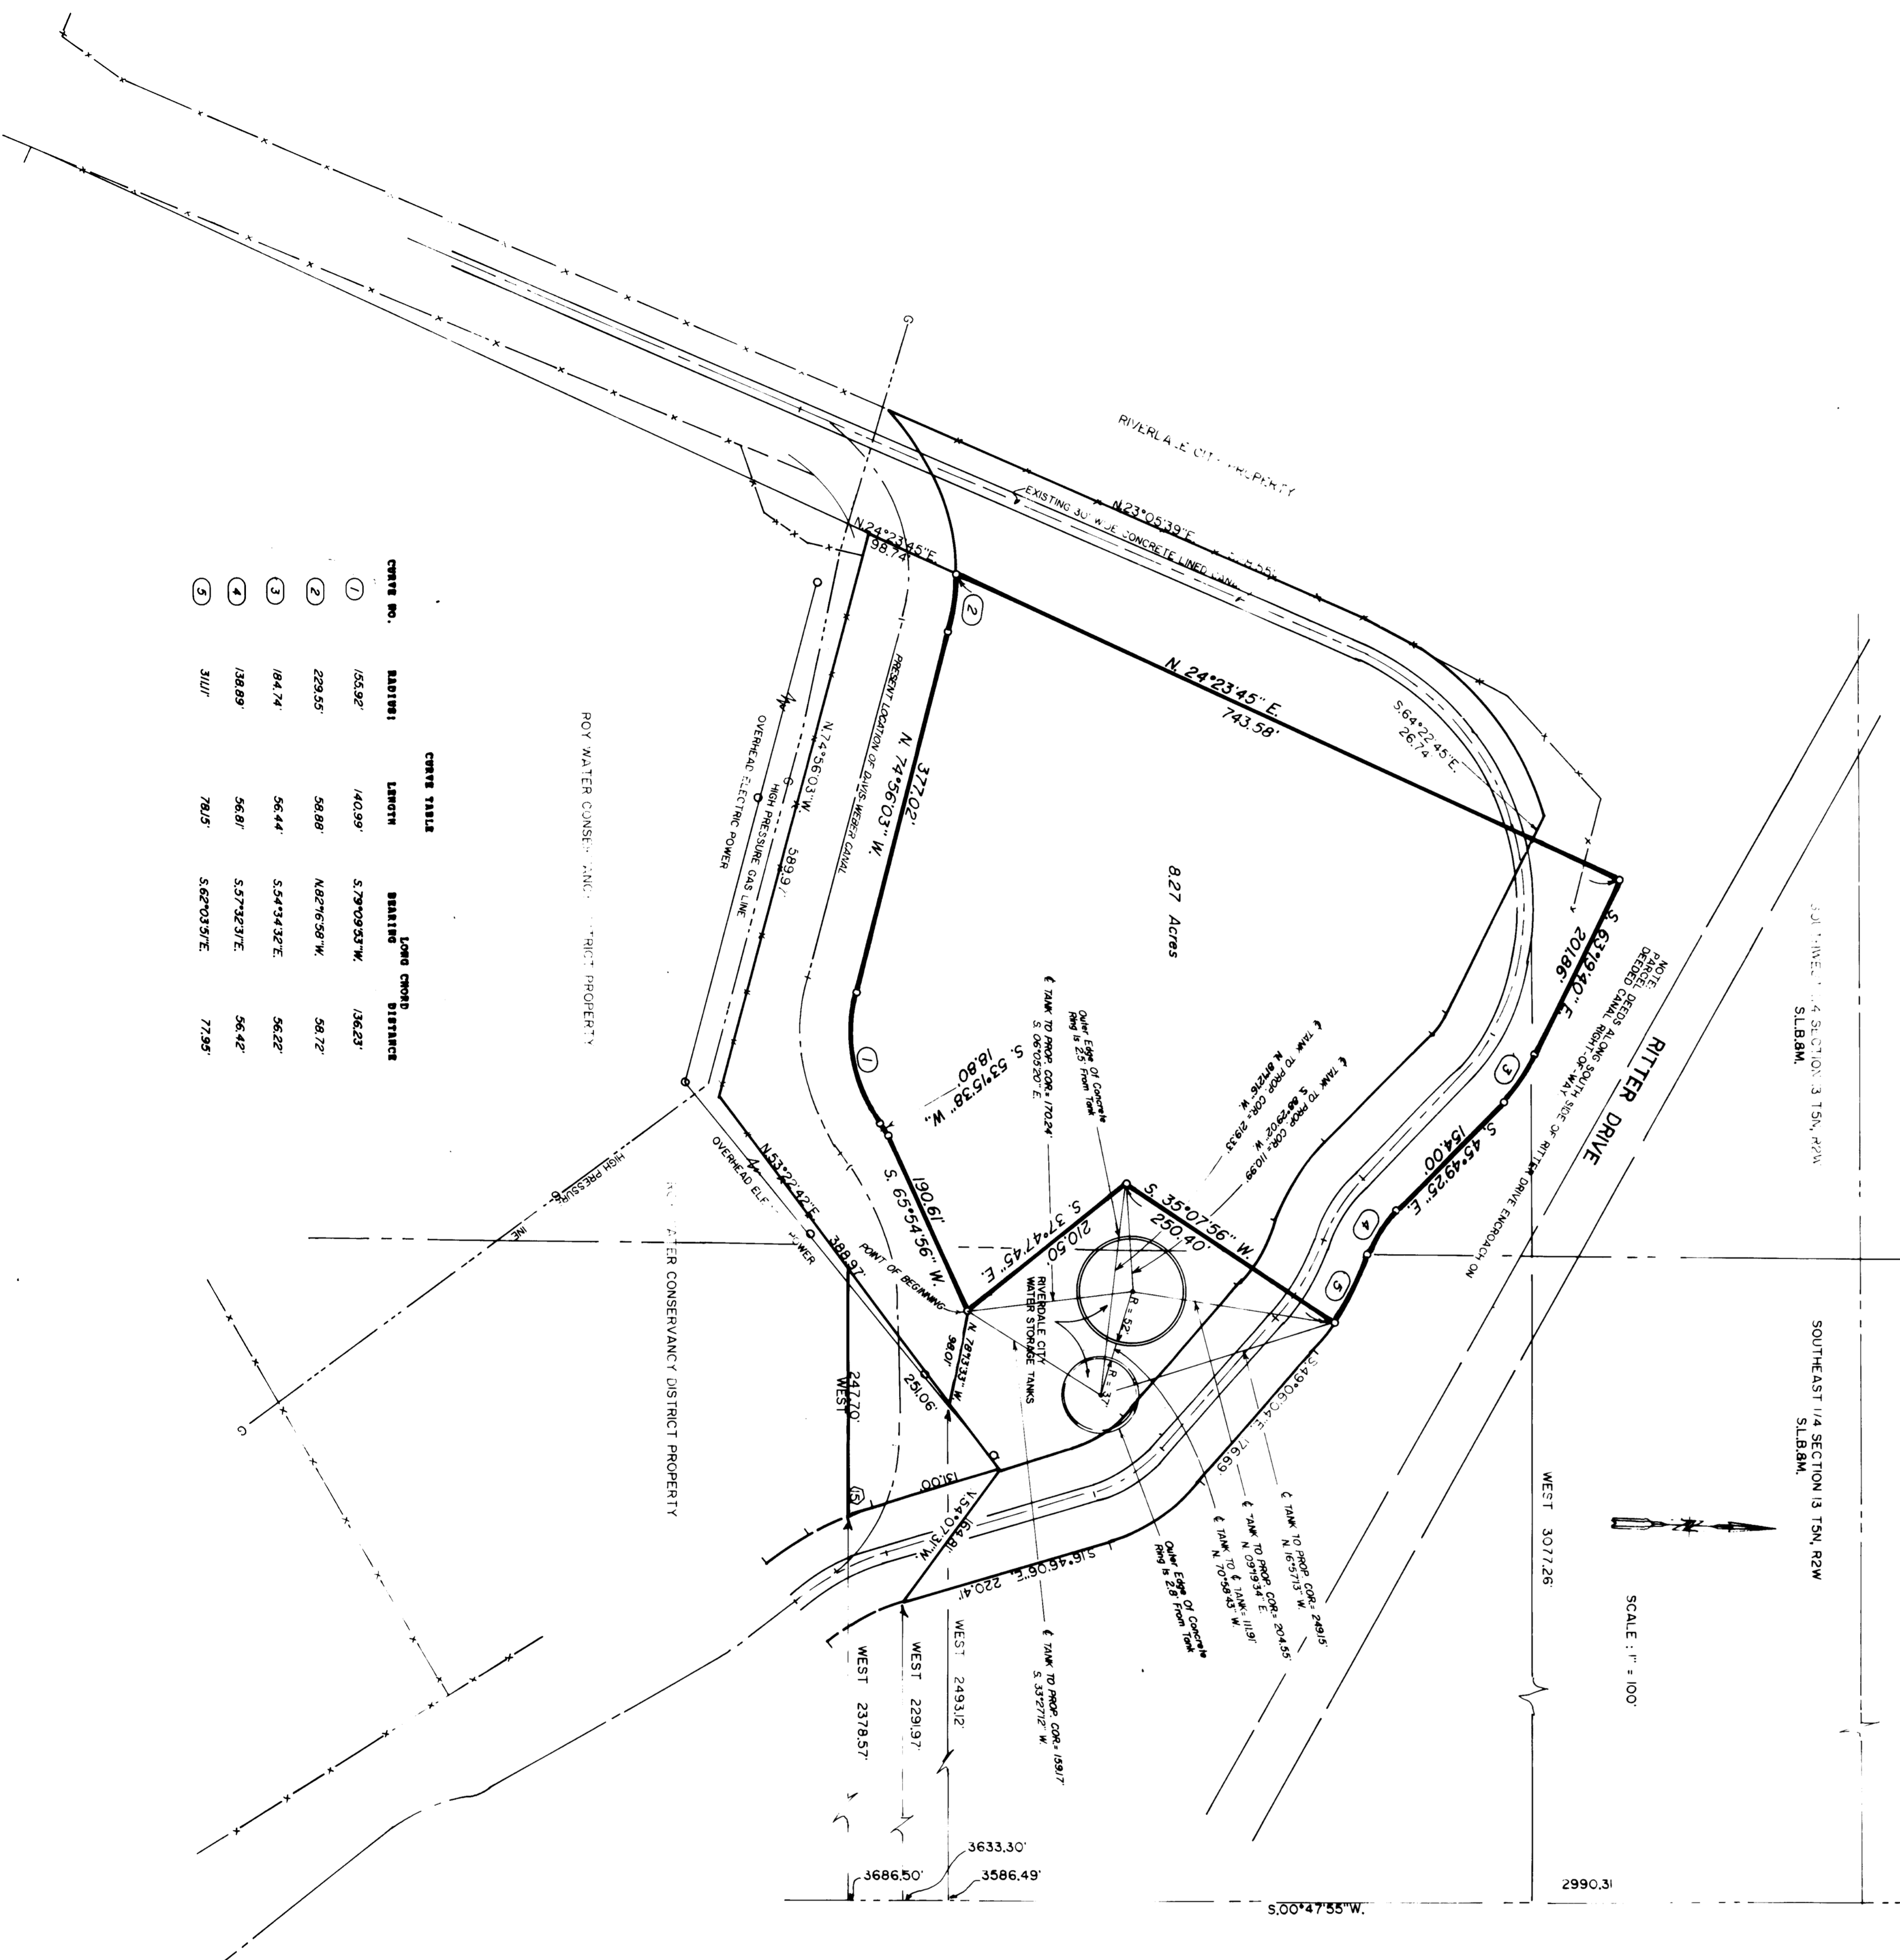





PROPERTY DESCRIPTION
 BEING A PART OF THE SOUTH ONE-HALF OF SECTION 13, TOWNSHIP 5 NORTH, RANGE 2 WEST, SALT LAKE BASE AND MERIDIAN AND DESCRIBED AS FOLLOWS: BEGINNING AT A POINT WHICH IS S. 00° 47' 55\"/>

NARRATIVE OF SURVEY


I, MARTIN B. MOORE JR., UTAH REGISTERED LAND SURVEYOR NO. 3964 DO HEREBY CERTIFY THAT THIS PLAT WAS PREPARED FROM A SURVEY MADE BY ME OR UNDER MY CLOSE PERSONAL SUPERVISION AND THAT I AM A LAND SURVEYOR P.C. AND IS TRUE AND CORRECT TO THE BEST OF MY KNOWLEDGE AND BELIEF.

MARTIN B. MOORE JR., S.L.S.



RECEIVED
 SEP 28 892
 Weber-Cody Surveyors

RECORD OF SURVEY
 for
 WEBBER BASIN WATER CONSERVANCY DISTRICT

 DATE: 5/18/92
 BY: M.B.M.
 CHECKED: M.B.M.
 MOUNTAIN WEST PROFESSIONAL LAND SURVEYORS, P.C.
 RAY, UTAH