

**REFERENCE TABLE**

NO.	DESCRIPTION	DATE	BY
R1	Warranty Deed		
R2	Warranty Deed		
R3	Special Warranty Deed		
R4	Special Warranty Deed		
R5	Special Warranty Deed		
R6	Release of Mortgage		
R7	Quit-Claim Deed		
R8	Quit-Claim Deed		
R9	Quit-Claim Deed		
R10	Quit-Claim Deed		
R11	Quit-Claim Deed		
R12	Quit-Claim Deed		
R13	Quit-Claim Deed		
R14	Quit-Claim Deed		
R15	Quit-Claim Deed		
R16	Quit-Claim Deed		
R17	Record of County Court		
R18	Special Warranty Deed		
R19	Quit-Claim Deed		
R20	Quit-Claim Deed		
R21	Quit-Claim Deed		
R22	Warranty Deed		
R23	Easement		
R24	Warranty Deed		
R25	Warranty Deed		
R26	Warranty Deed		
R27	Warranty Deed		
R28	Warranty Deed		
R29	Quit-Claim Deed		
R30	Quit-Claim Deed		
R31	Bearing Sheet		
R32	Tie Sheet		
R33	Tie Sheet		
R34	Tie Sheet		
R35	Tie Sheet		
R36	Tie Sheet		
R37	Tie Sheet		
R38	Tie Sheet		
R39	Original Township Survey		
R40	Original Township Survey		
R41	Tie Sheet		
R42	Tie Sheet		
R43	Tie Sheet		
R44	Tie Sheet		
R45	Record of Survey		
R46	Subdivision		
R47	Record of Survey		
R48	Ran & Profile		
R49	Ran & Profile		
R50	Ran & Profile		
R51	Subdivision		
R52	Record of Survey		
R53	Subdivision		
R54	Record of Survey		
R55	Record of Survey		
R56	Record of Survey		
R57	Historical Aerial Photograph		
R58	Historical Aerial Photograph		
R59	Recent Aerial Photograph		

**NARRATIVE**

A. This Survey was requested by Steve Waldrip to retracive the boundaries of Middlefork Ranch. B. The basis of bearing for this Survey is South 03°08'13" West measured between Reference Monuments to the Northwest Corner of Section 5 and the East Quarter Corner of Section 5, Township 6 North, Range 2 East, Salt Lake Base and Meridian, U.S. Survey.

B.A. The letters within parenthesis shown in this this corresponds to the letters of the narrative explaining the controlling evidence that the surveyor used in the retracement of the boundary shown here on. Reference table for deeds contain the type of document, Grantee, and Entry No. or Book and page. For Record of surveys and or Subdivision plots, contain the name and filing number or Book and Page Respectively.

C. Holding the record calls to be along the Section line. Deviations in the location of the fence from the section line are not significant in unwritten claims as land dedicated owned by the Federal and State Governments, and land dedicated for public use are immune from such doctrines.

D. Subject deeds Less and Expecting the Canal. Line segments labeled as D were deeded to the United States of America through Stations 2304-45.4 through 2404-67.0 at that certain Warranty Deed found at Entry No. 411543 in Book 755, Page 154-155. Said deed was retraced using Bureau of Reclamation Ogden Valley Canal Plan and Profile Sheet 526-D-2373 obtained from Weber Basin Water. Measurements for the Ogden Valley Canal were to the nearest 0.10th of a foot. Retracement of all of the following Canal data placed this error in the calculations of the arcs. Discrepancies between the Plan and Profile and the Right of Way widths were resolved by holding calls in the deeded.

E. Boundary retracement relied on Quit-Claim Deed found at Entry No. 397699 Book 736 Page 89-91 and Entry No. 411543 Book 755 Page 154 rather than Plan and Profile mentioned in Section D. Boundary was retraced from Said deeds were adjusted to match the rotation of the canal at the call for stations.

F. Subject Deeds Less and Expecting the Canal. Line segments labeled as "F" were deeded to the United States of America through Stations 206-42.3 through 224-85.5 at that certain Warranty Deed found at Entry No. 397699 in Book 736 Page 89-90. Said deed was retraced using Bureau of Reclamation Ogden Valley Canal Plan and Profile Sheet 526-D-2373 obtained from Weber Basin Water.

G. Additional Right of Way deeded in fee title by said Warranty Deed mentioned in Section F.

H. Subject Deeds Less and Expecting the Canal. Line segments labeled as H were deeded to the United States of America through Stations 113+20.0 through 206-42.3 at that certain Warranty Deed found at Entry No. 397699 in Book 736 Page 89-90. Said deed was retraced using Bureau of Reclamation Ogden Valley Canal Plan and Profile Sheet 526-D-2373 obtained from Weber Basin Water.

I. Deed found at Entry No. 1624812 Claims up to the Section line. Old survey plats completed by Great Basin Engineering show and "approximate" Location of the Section line. An Old rebar found monumenting this location was not honored for the following reasons: 1) No evidence of its acceptance by the surrounding landowners. The actual Survey of the Section line is 17 feet North of the found rebar and cap.

J. Subject deed found at Entry No. 1624812 calls Southeasterly along this line with bounds calls to the Mountain Canal. Adjoining deed Deeds found at Entry No. 2582877 call bearing and distance along Mountain Creek. Evidence from Surveyor regarding the existing conditions of the site show fences and a ditch flowing along said deed. Due to the evidence of the intent of the deeds and with the record bearing and distances measured matching the deed found at Entry No. 2582877 this position was held for retracement.

K. Subject deed found at Entry No. 1624812 calls Bearing, and Distance with no bounds calls. Adjoining deed found at Entry No. 2067674 calls to, "Mountain Creek." Adjoining deed found at Entry No. 1835108 calls to the Canal. From the analysis explained in Section J and with the historical fence lines along the west bank of the Mountain Canal, "Mountain Creek," and "The Canal" Surveyor believes the intent of the subject deeds and the adjoining deeds to be up and along the measured location of the same. Surveyor held the measured centerline of the Canal. However, a convincing argument could be made that the West bank of the "Mountain Canal" could actually be the boundary.

L. As explained in Sections "J" and "K" Surveyor believes the intent of the deeds to follow the "Mountain Canal." However, along this segment, it was found that the finding no

**NARRATIVE**

longer follows the "Mountain Canal." A measurement from the "Center of Section" as relied upon by land owners to the location of the fence tie matches all most exactly. Due to this Surveyor believes that the intent was to be South 2.61 Chains and West 18.57 Chains from the Center of Section as called in Entry No 1624812 because it is clear that landowners acted on this call rather than along the Mountain Canal. Historical Photographs from 1946 obtained by Surveyor from the Utah Geological Survey clearly show the mountain canal and this fence location to be the same.

M. Record distance along the segment labeled as M is 90 feet due to discrepancies in the record and the physical location between the Mountain canal and other occupational evidence Surveyor held a measured distance rather than the record.

N. Measurement and positions from the original Surveyor hold no matter despite the error in the record, even if the land owner is acting as the Surveyor. In retracement of line segment labeled as "N" it was found when measuring 10 chains "South" and 20 Chains "East" that when measured in relation to the road, it matched the current locations of the fences. However, the rotation between these lines was not consistent between the record. The same scenario was found with a ditch along the south line of Entry No 1835108 strengthening the evidence that these lines were lined out and relied upon as the boundary. Surveyor held the position of the fences as original monuments for the reasons explained above.

O. A roadway was established by court order found at Book 4 Page 363. Upon Survey, it was found that this court order did not follow the actual location of the road. Surveyor is of the opinion that the requirements of Right of Way dedication by Right of Use has occurred as defined in Utah State Code 72-51-104. The establishment of this has been held up to the measured occupation of the roadway as shown.

P. Holding the Record of Quit-Claim Deed found at Entry No. 2938188 that has junior rights over subject property.

Q. By said Court order found at Book 4, Page 363 a roadway was described as being along the Section line. With this document, Surveyor could not find the location of the roadway. Looking at evidence on the ground it appears the intent is a 33-foot half-width roadway. Due to this, the said court order was retraced as 33 feet from the described line, being along the section line.

R. Along the Section line as calculated using The Sanctuaries record of Survey found at filing No. 4793.

S. Along the West bounds of The Sanctuary. Surveyor found Hansen Rebar and Cap agreeing with the calculated position.

T. Along the East line of the West Half of the Southwest Quarter of Section 4. As retraced on the ground from found monuments of past surveys, rather than calculated Section positions.

U. Surveyor Located rebars and caps along line segments labeled as "U" unless otherwise noted. Along with these rebars and caps were tie posts with signs stating "No Tie Passing." Despite differing Section positions due to additional data regarding the Section lines than that of the original Survey these rebars and caps still must hold and were considered "without error" in following the footsteps of the original Surveyor. Line segments labeled as "U" that did not have a found rebar and cap monumenting its position were calculated from the record.

V. As mentioned in Section "I" regarding the Great Basin Rebar's and caps placed monumenting the approximate Section line. Evidence in the field suggested that these positions should be held without error and explained in Section "U". In applying this theory, a line between the two Rebars and caps was held as the "approximate" Section Line and was used to fulfill the call in the deed along the Section to the Green Hill development.

W. Less and Excepting Quit Claim Deed found at Entry No 2938193 having Junior rights over the subject property.

X. Along Lot line adjustment Survey completed in 8th of May 2014 on file with Weber County Surveyor under File No. 5025.

**LEGAL DESCRIPTION**

**Parcel 21-002-0001**

All of the Northwest Quarter and part of the Northwest Quarter of Section 5, and part of the Southwest Quarter of Section 6, Township 6 North, Range 2 East, Salt Lake Base and Meridian, U.S. Survey;

Beginning at a point which is 1000.00 feet South 1°43'48" West along the Section line, being the centerline of 7900 East Street, from the Northwest Corner of said Section 5, and running thence South 88°16'12" East 1185.37 feet; thence South 53°19'48" West 254.33 feet; thence South 75°03'48" West 605.23 feet (629.36 feet record); thence North 89°42'41" West (North 88°46'12" West Record) 163.26 feet; thence North 26°55'45" East 213.52 feet; thence North 61°20'48" West 130.48 feet; thence South 66°20'45" West 202.99 feet; thence North 88°16'12" West 33.00 feet to said centerline and Section line; thence North 1°43'48" East 169.54 feet along said centerline and Section line to the point of beginning.

Contains 5.333 acres.

**Parcel 21-003-0013**

Part of the Southwest Quarter of Section 5, Township 6 North, Range 2 East, Salt Lake Base and Meridian, U.S. Survey;

Beginning at the Northwest Corner of said Quarter Section, and running thence East 20 chains, thence South 10 chains, thence West 20 chains, thence North 330 chains, thence East 235 feet, thence North 200 feet, thence West 235 feet, thence North 130 feet to the place of beginning.

Also:

**Parcel 21-004-0007**

Part of the Northwest Quarter of Section 5, Township 6 North, Range 2 East, Salt Lake Base and Meridian;

Beginning at the Northwest Corner of said Section 5; running thence South 00°19' West 287.5 feet along the West line of said Section 5; which lies along the center line of a 66-foot Country Road; thence South 89°28' East 1425.13 feet; thence North 6°52' West 289.91 feet to the North line of said Section 5; thence West along said North line 1398.88 feet to the point of beginning. Excepting that portion thereof within the Ogden Valley Canal.

Also:

**Parcel 21-004-0002**

Part of the Northwest Quarter of Section 5, Township 6 North, Range 2 East, Salt Lake Base and Meridian;

Beginning at a point 287.5 feet South 00°19' West along the West line of said Section 5, which lies along the center line of a 66-foot Country Road; thence continuing South 00°19' West along said West line 712.5 feet; thence South 89°41' East 1185.37 feet; thence North 51°55' East 304.12 feet; thence North 30°23' East 221.62 feet; thence North 13°34' East 308.45 feet; thence South 88°28' West 173.86 feet; thence North 6°52' West 41.49 feet; thence North 89°28' West 1425.13 feet to the point of beginning. Excepting that portion thereof within the Ogden Valley Canal.

Also:

**Parcel 21-004-0006**

Part of the Northwest Quarter of Section 5, Township 6 North, Range 2 East, Salt Lake Base and Meridian;

Beginning at a point South 00°19' West 1000 feet from the Northwest corner of said Section 5, said line being the West line of Section 5, said line being the West line of Section 5 and also the center line of a 66 foot county road; running thence South 89°41' East 1185.37 feet; thence South 51°55' East 304.12 feet; thence North 13°34' West 629.36 feet; thence South 89°49' West 146.68 feet; thence North 01°19' East 200 feet; thence South 89°49' West 233 feet; thence North 01°19' East 135.2 feet to the place of beginning.

Also:

**LEGAL DESCRIPTION**

**Parcel 1 21-001-0005**

The Northwest Quarter and the West half of the Northeast Quarter, and the North Half of the Southwest Quarter of the North Half of the Northwest Quarter of the Southeast Quarter of Section 4, Township 6 North, Range 2 East, Salt Lake Base and Meridian, U.S. Survey.

**Parcel 2 21-002-0002**

Part of the South half of Section 5, Township 6 North, Range 2 East, Salt Lake Base and Meridian, U.S. Survey;

Beginning 6.77 chains (446.02 feet) North of the Southwest corner of the Southeast Quarter; thence North 71° East 110 chains (66.00 feet) to Mountain Canal; thence Southeasterly along the Canal to the South Quarter corner of the East 444.7 feet, more or less, along the Section line to the North line of the Ogden Valley Canal; thence North 41°00'08", East 1115.36 feet, more or less, to the Northwest Corner of Greenhill County Estates, Phase No. 2, Weber County, Utah; thence East 833.82 feet, more or less, along the North line of said Greenhill County Estates No. 2 to the East line of said Section; thence North (North 04°23' West) 1805.51 feet along said East Section line to the East Quarter Corner; thence West to the Center of Section; thence South 2.61 chains (172.26 feet); thence West 18.57 chains (1225.62 feet); thence South 35° East 9.02 chains (595.32 feet); thence South 22°50' East 11.96 chains (789.36 feet) thence South 33°35' East 16 chains (1056.00 feet) to the beginning, excepting 5.83 Acre, more or less, in the Ogden Valley Canal.

**SURVEYOR'S CERTIFICATE**

I, Andy Hubbard do hereby certify that I am a Professional Land Surveyor, and that I hold Certificate No. 6242920, in accordance with Title 58, Chapter 22, of the Professional Engineers and Professional Land Surveyors Licensing Act, and I have made a survey of the above described property according to Section 17-23-17 and that the above plot correctly shows the true dimensions of the property surveyed.

Andy Hubbard, PLS 6242920  
23 Aug. 2023  
STATE OF UTAH

RECEIVED  
AUG 25 2023  
FILE # 7635

Date

**GREAT BASIN ENGINEERING**

5746 SOUTH OGDEN, UTAH 84403  
MAIN (801)394-4515, S.L.C. (801)521-0222, FAX (801)392-7544  
WWW.GREATBASINENGINEERING.COM

**Record of Survey**


**Middlefork Ranch LLC**

1450 North 7900 East  
Huntsville, Utah  
A part of Sections 4 & 5, T6N, R2E, SLB&M, U.S. Survey


**Jan, 2023**

SHEET NO. **1** of 5

13N778

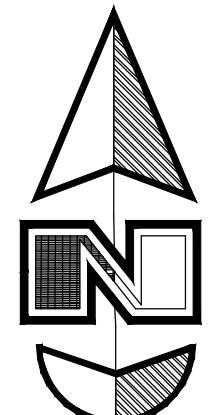

Scale: 1" = 150'

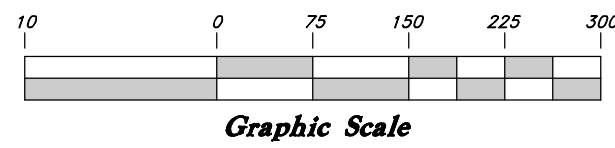

Graphic Scale

Calculated Section Corner of the Northwest Corner of Section 5, T6N, R2E, SLB&M Point of Beginning (Parcel 40007)

Reference Monument in the Northwest Corner of Section 5, T6N, R2E, SLB&M

Found Northeast Quarter Corner of Section 5, T6N, R2E, SLB&M

State of Utah Department of Natural Resources

Parcel # 23-012-0048





2637.09'



VICINITY MAP (Not to Scale)

Legend

- Monument to be set
- Found Centerline Monument
- Fence
- Existing Asphalt
- Existing Concrete
- Existing Gravel
- Easement
- Approximate Canal Location
- Existing Boundary
- Set 5/8" x 24" Long Rebar & Cap w/ Lathe

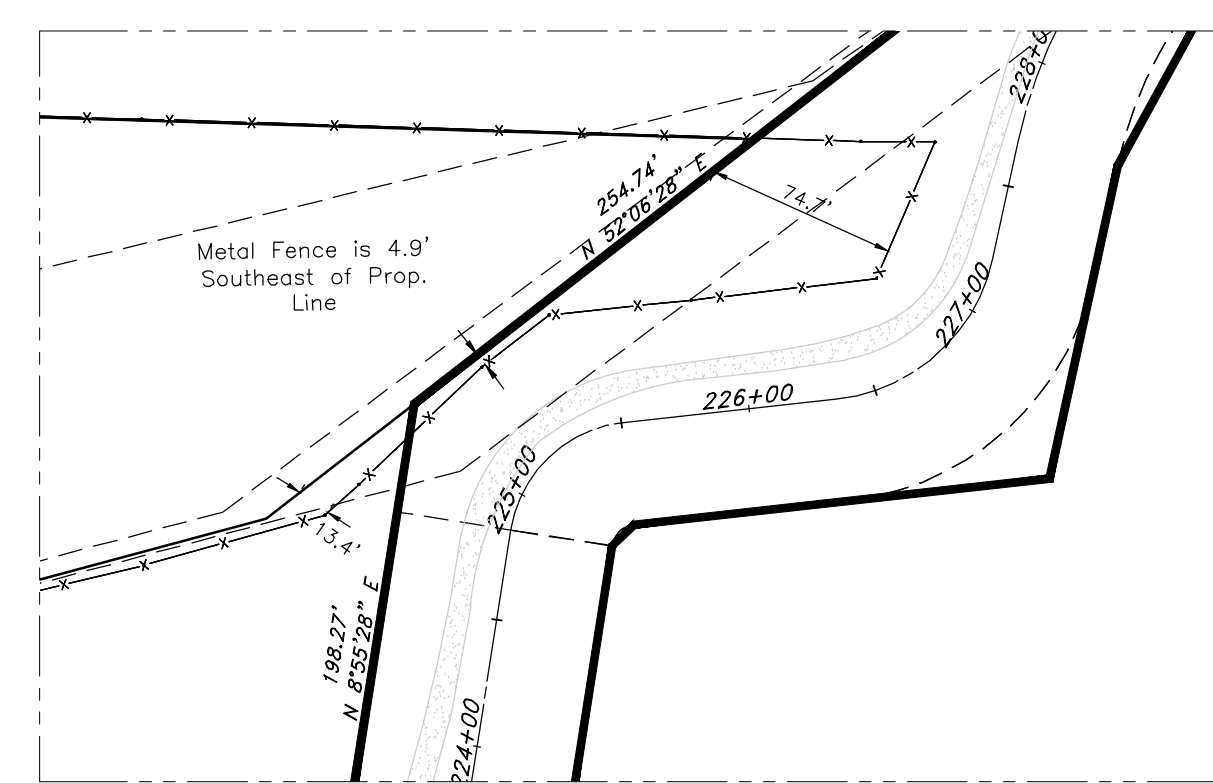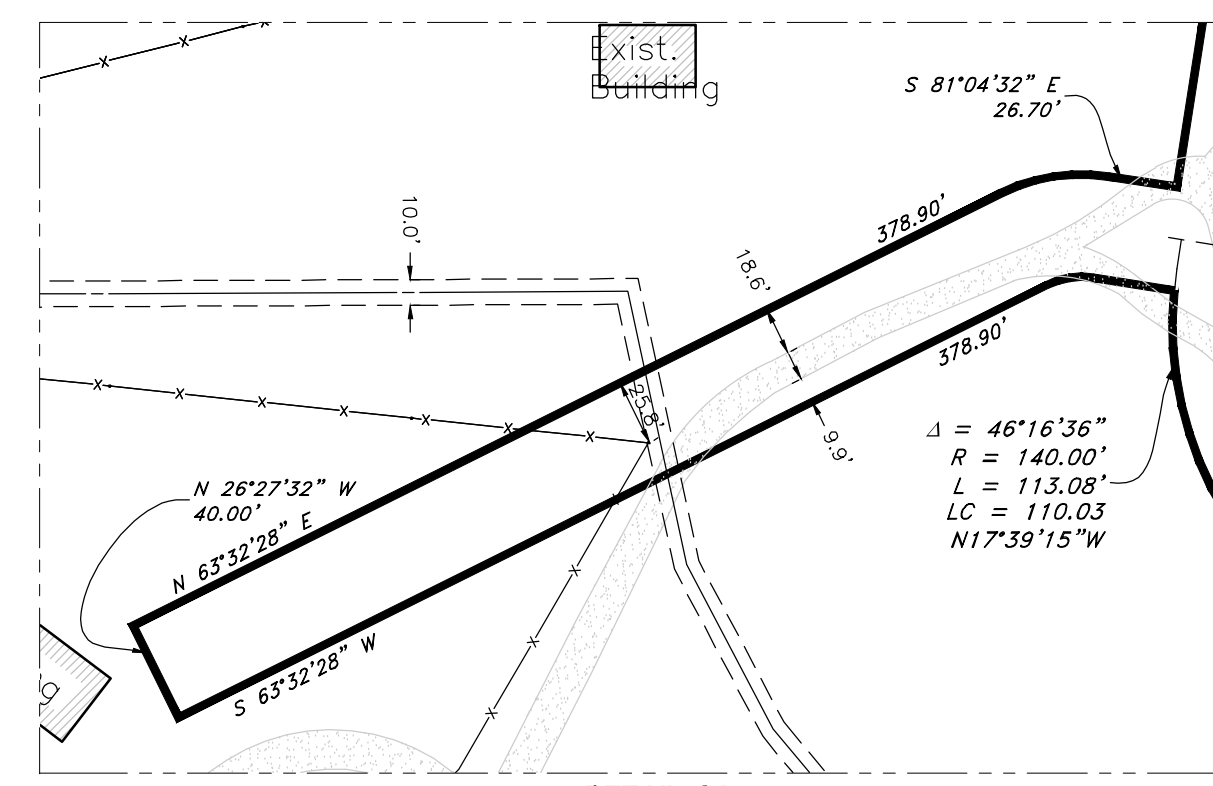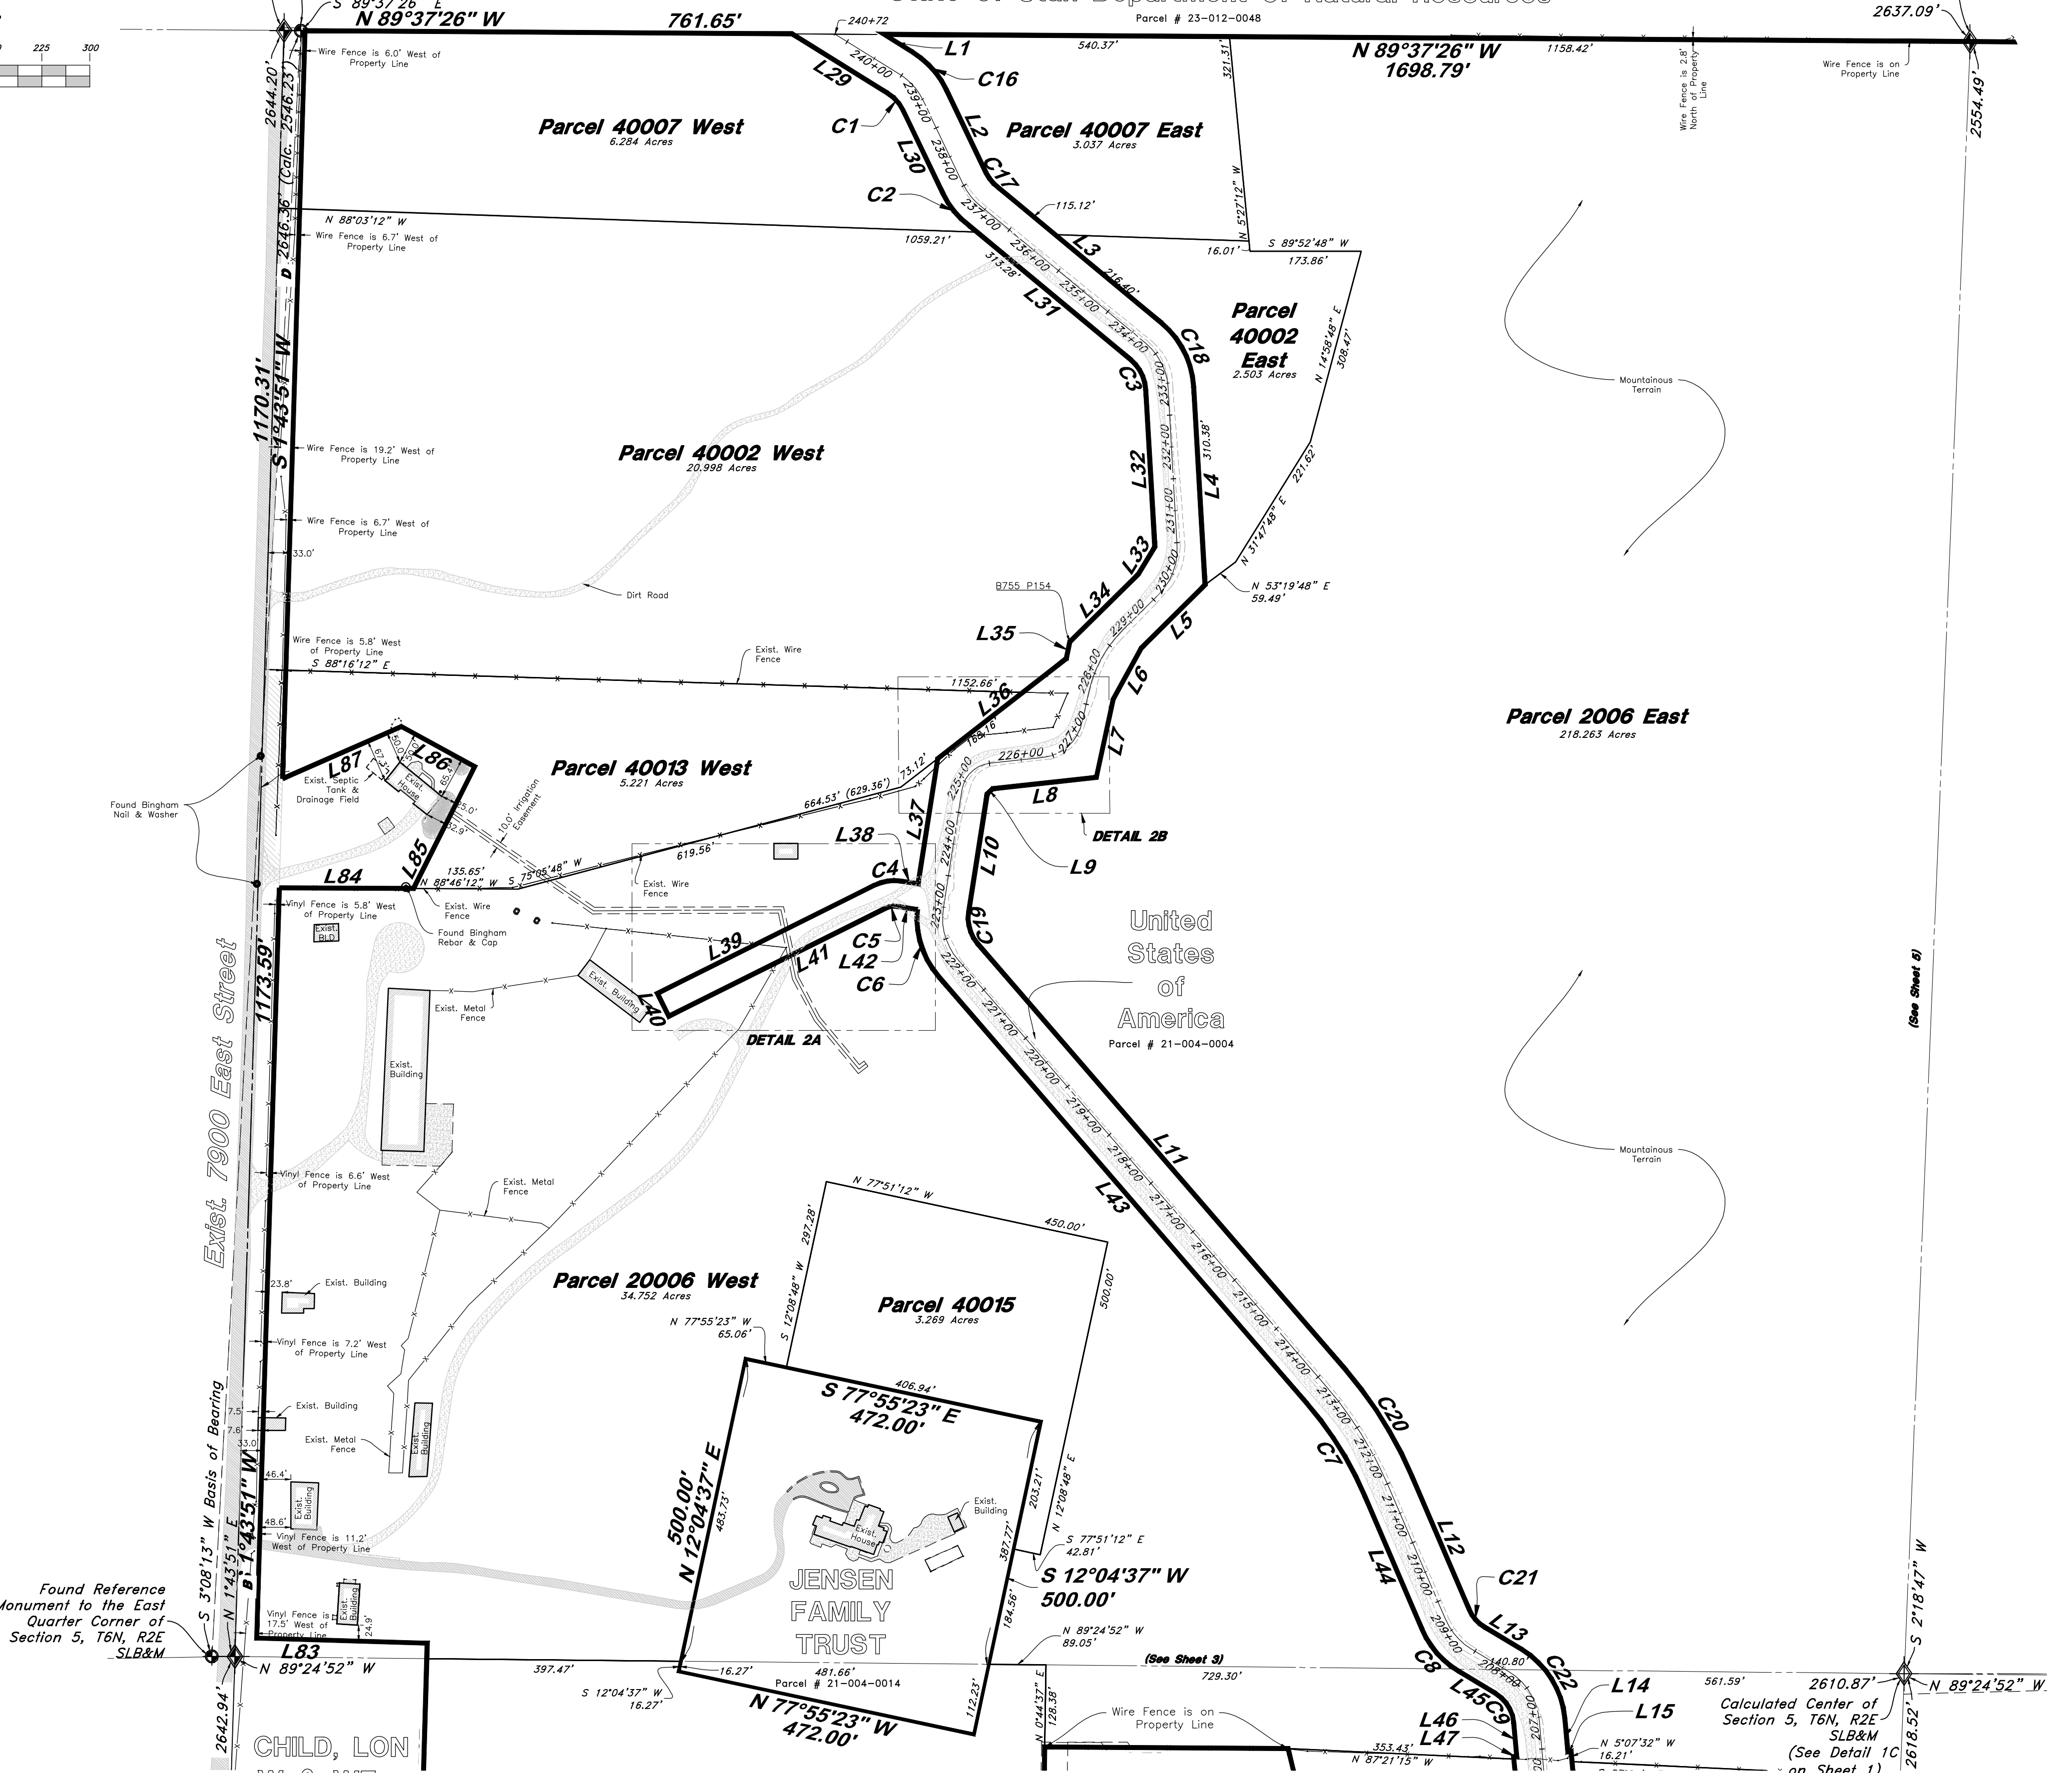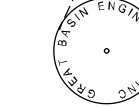

REF	DATE	DESCRIPTION

**GREAT BASIN ENGINEERING**

5746 SOUTH 1475 EAST OGDEN, UTAH 84403  
 MAIN (801)399-4451 S.L.C. (801)521-0222 FAX (801)392-7544  
 WWW.GREATBASINENGINEERING.COM

**Record of Survey**

**Middlefork Ranch LLC**

1450 North 7900 East  
 Huntsville, Utah

A part of Sections 4 & 5, T6N, R2E, SLB&M, U.S. Survey


Jan, 2023

SHEET NO. **2** of 5

13N778



RECEIVED  
AUG 25 2023  
FILE # 7635

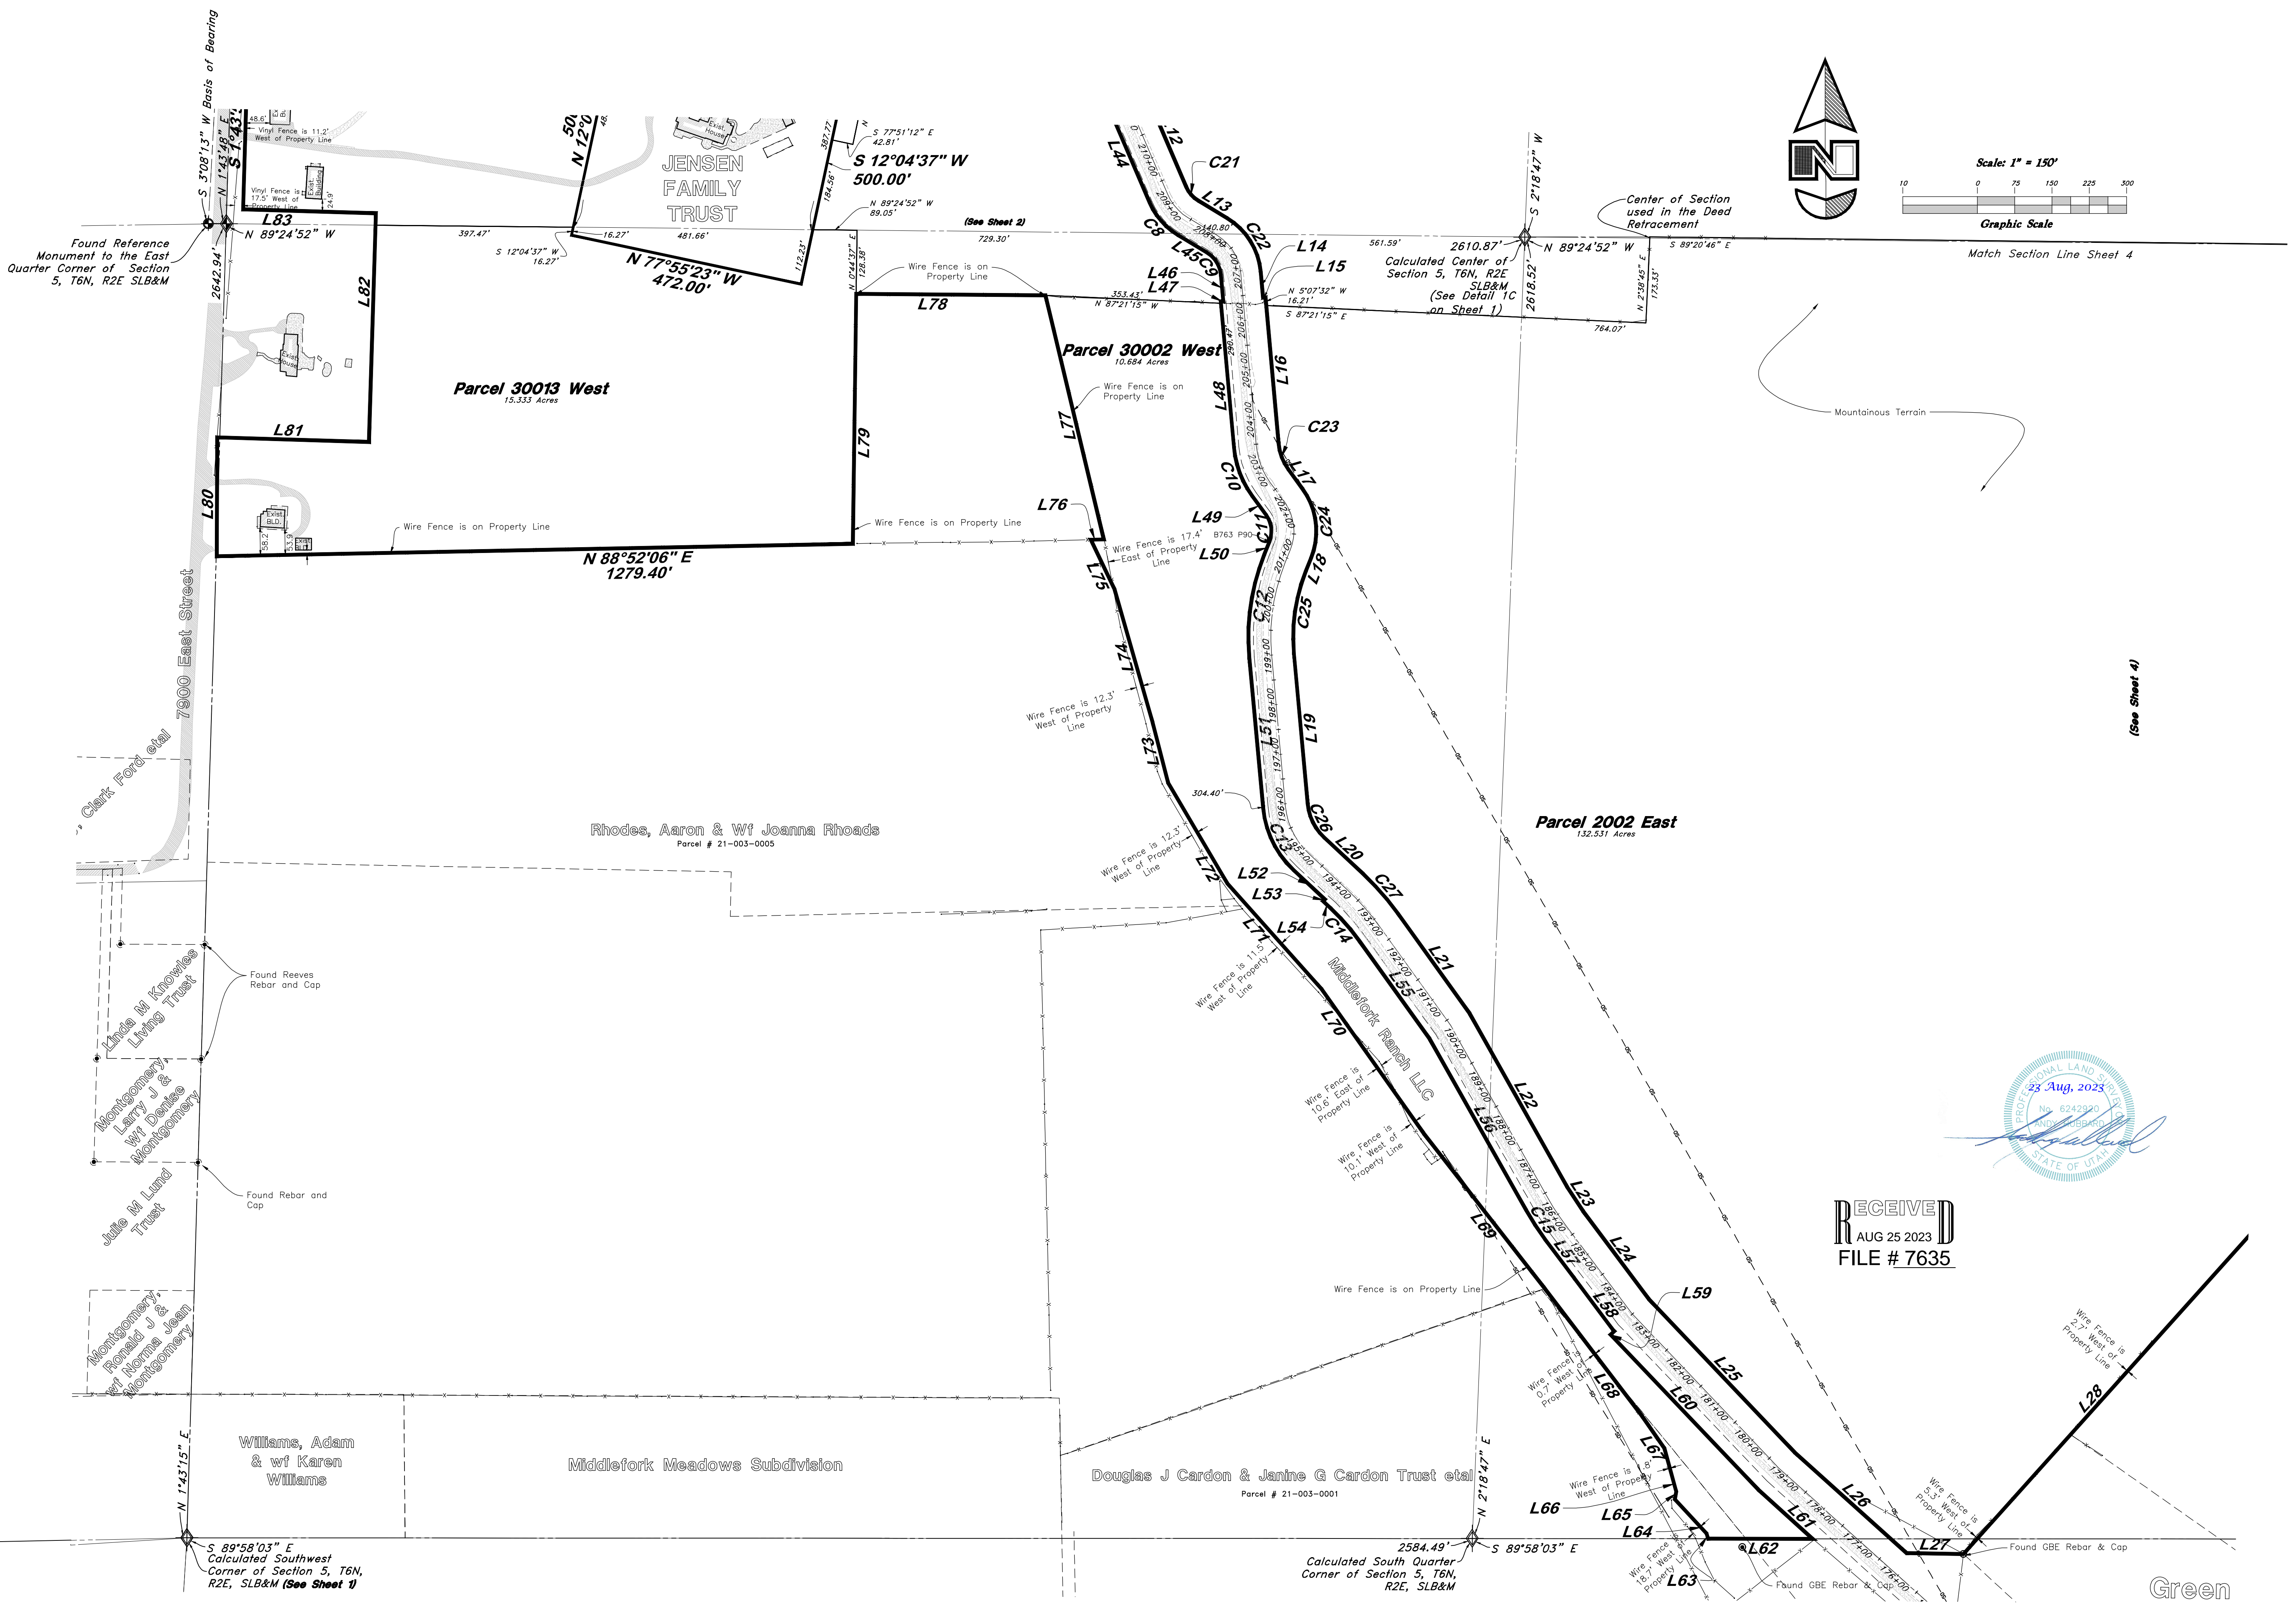

REF	DATE	DESCRIPTION

**GREAT BASIN ENGINEERING**

5746 SOUTH 1475 EAST OGDEN, UTAH 84403  
 MAIN (801)399-44515 S.L.C (801)521-0222 FAX (801)392-7544  
 WWW.GREATBASINENGINEERING.COM

**Record of Survey**

**Middlefork Ranch LLC**


1450 North 7900 East  
 Huntsville, Utah  
 A part of Sections 4 & 5, T6N, R2E, SLB&M, U.S. Survey

Jan, 2023


SHEET NO. **3** of 5

13N778


W:\13N778 MIDDLE FORK RANCH\13N778 - Middlefork Ranch\DWG\13N778 - ROS 2022 Middlefork Ranch (KG).dwg, 8/23/2023 4:57:32 PM, drew, 1:1

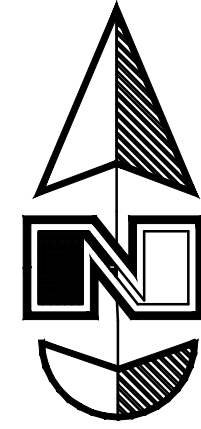


Scale: 1" = 200'

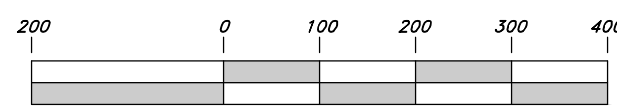

Graphic Scale

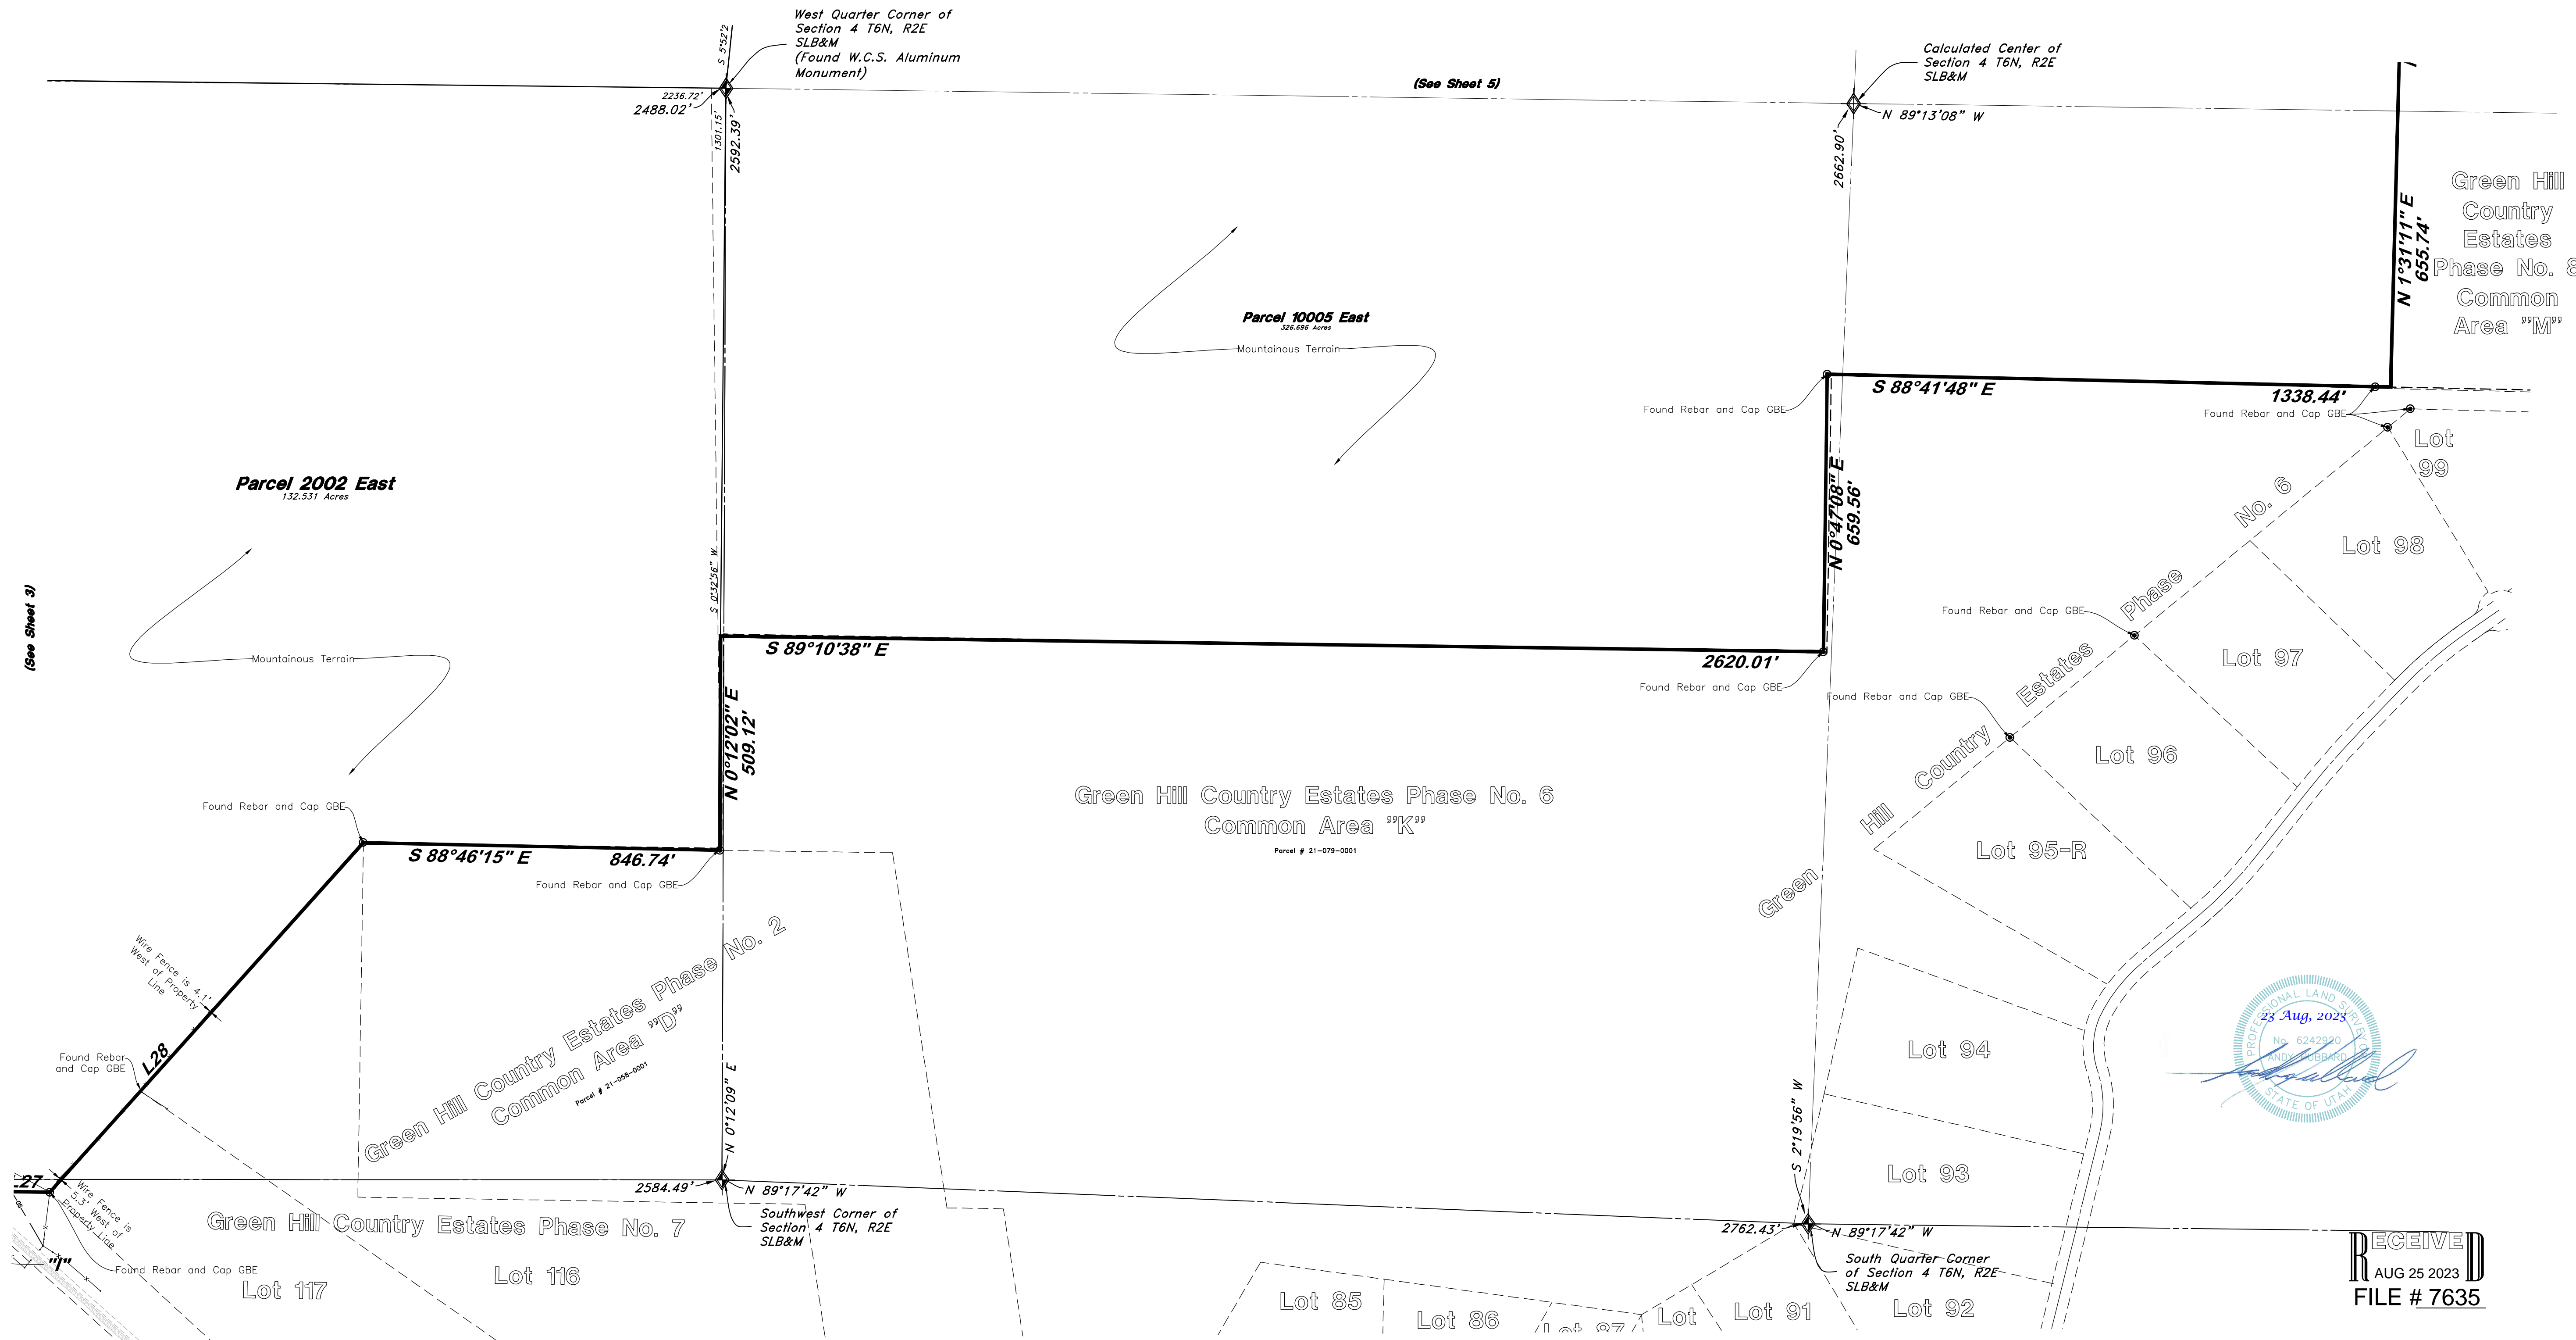

REF	DATE	DESCRIPTION

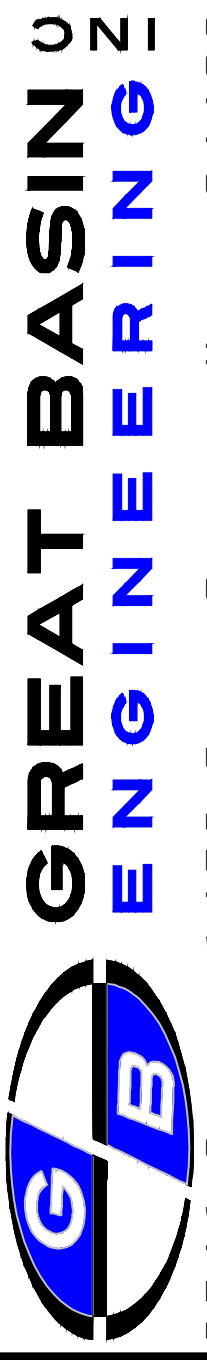

**GREAT BASIN ENGINEERING**  
 5746 SOUTH 1475 EAST OGDEN, UTAH 84403  
 MAIN (801)399-44515 S.L.C (801)521-0222 FAX (801)392-7544  
 WWW.GREATBASINENGINEERING.COM

**Record of Survey**  
**Middlefork Ranch LLC**  
 1450 North 7900 East  
 Huntsville, Utah  
 A part of Sections 4 & 5, T6N, R2E, SLB&M, U.S. Survey




**RECEIVED**  
 AUG 25 2023  
 FILE # 7635

Jan, 2023

SHEET NO. **4** of 5




Scale: 1" = 250'

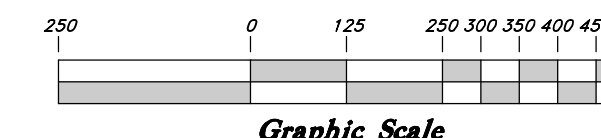

State of Utah Department of Natural Resources

Parcel # 23-012-0050

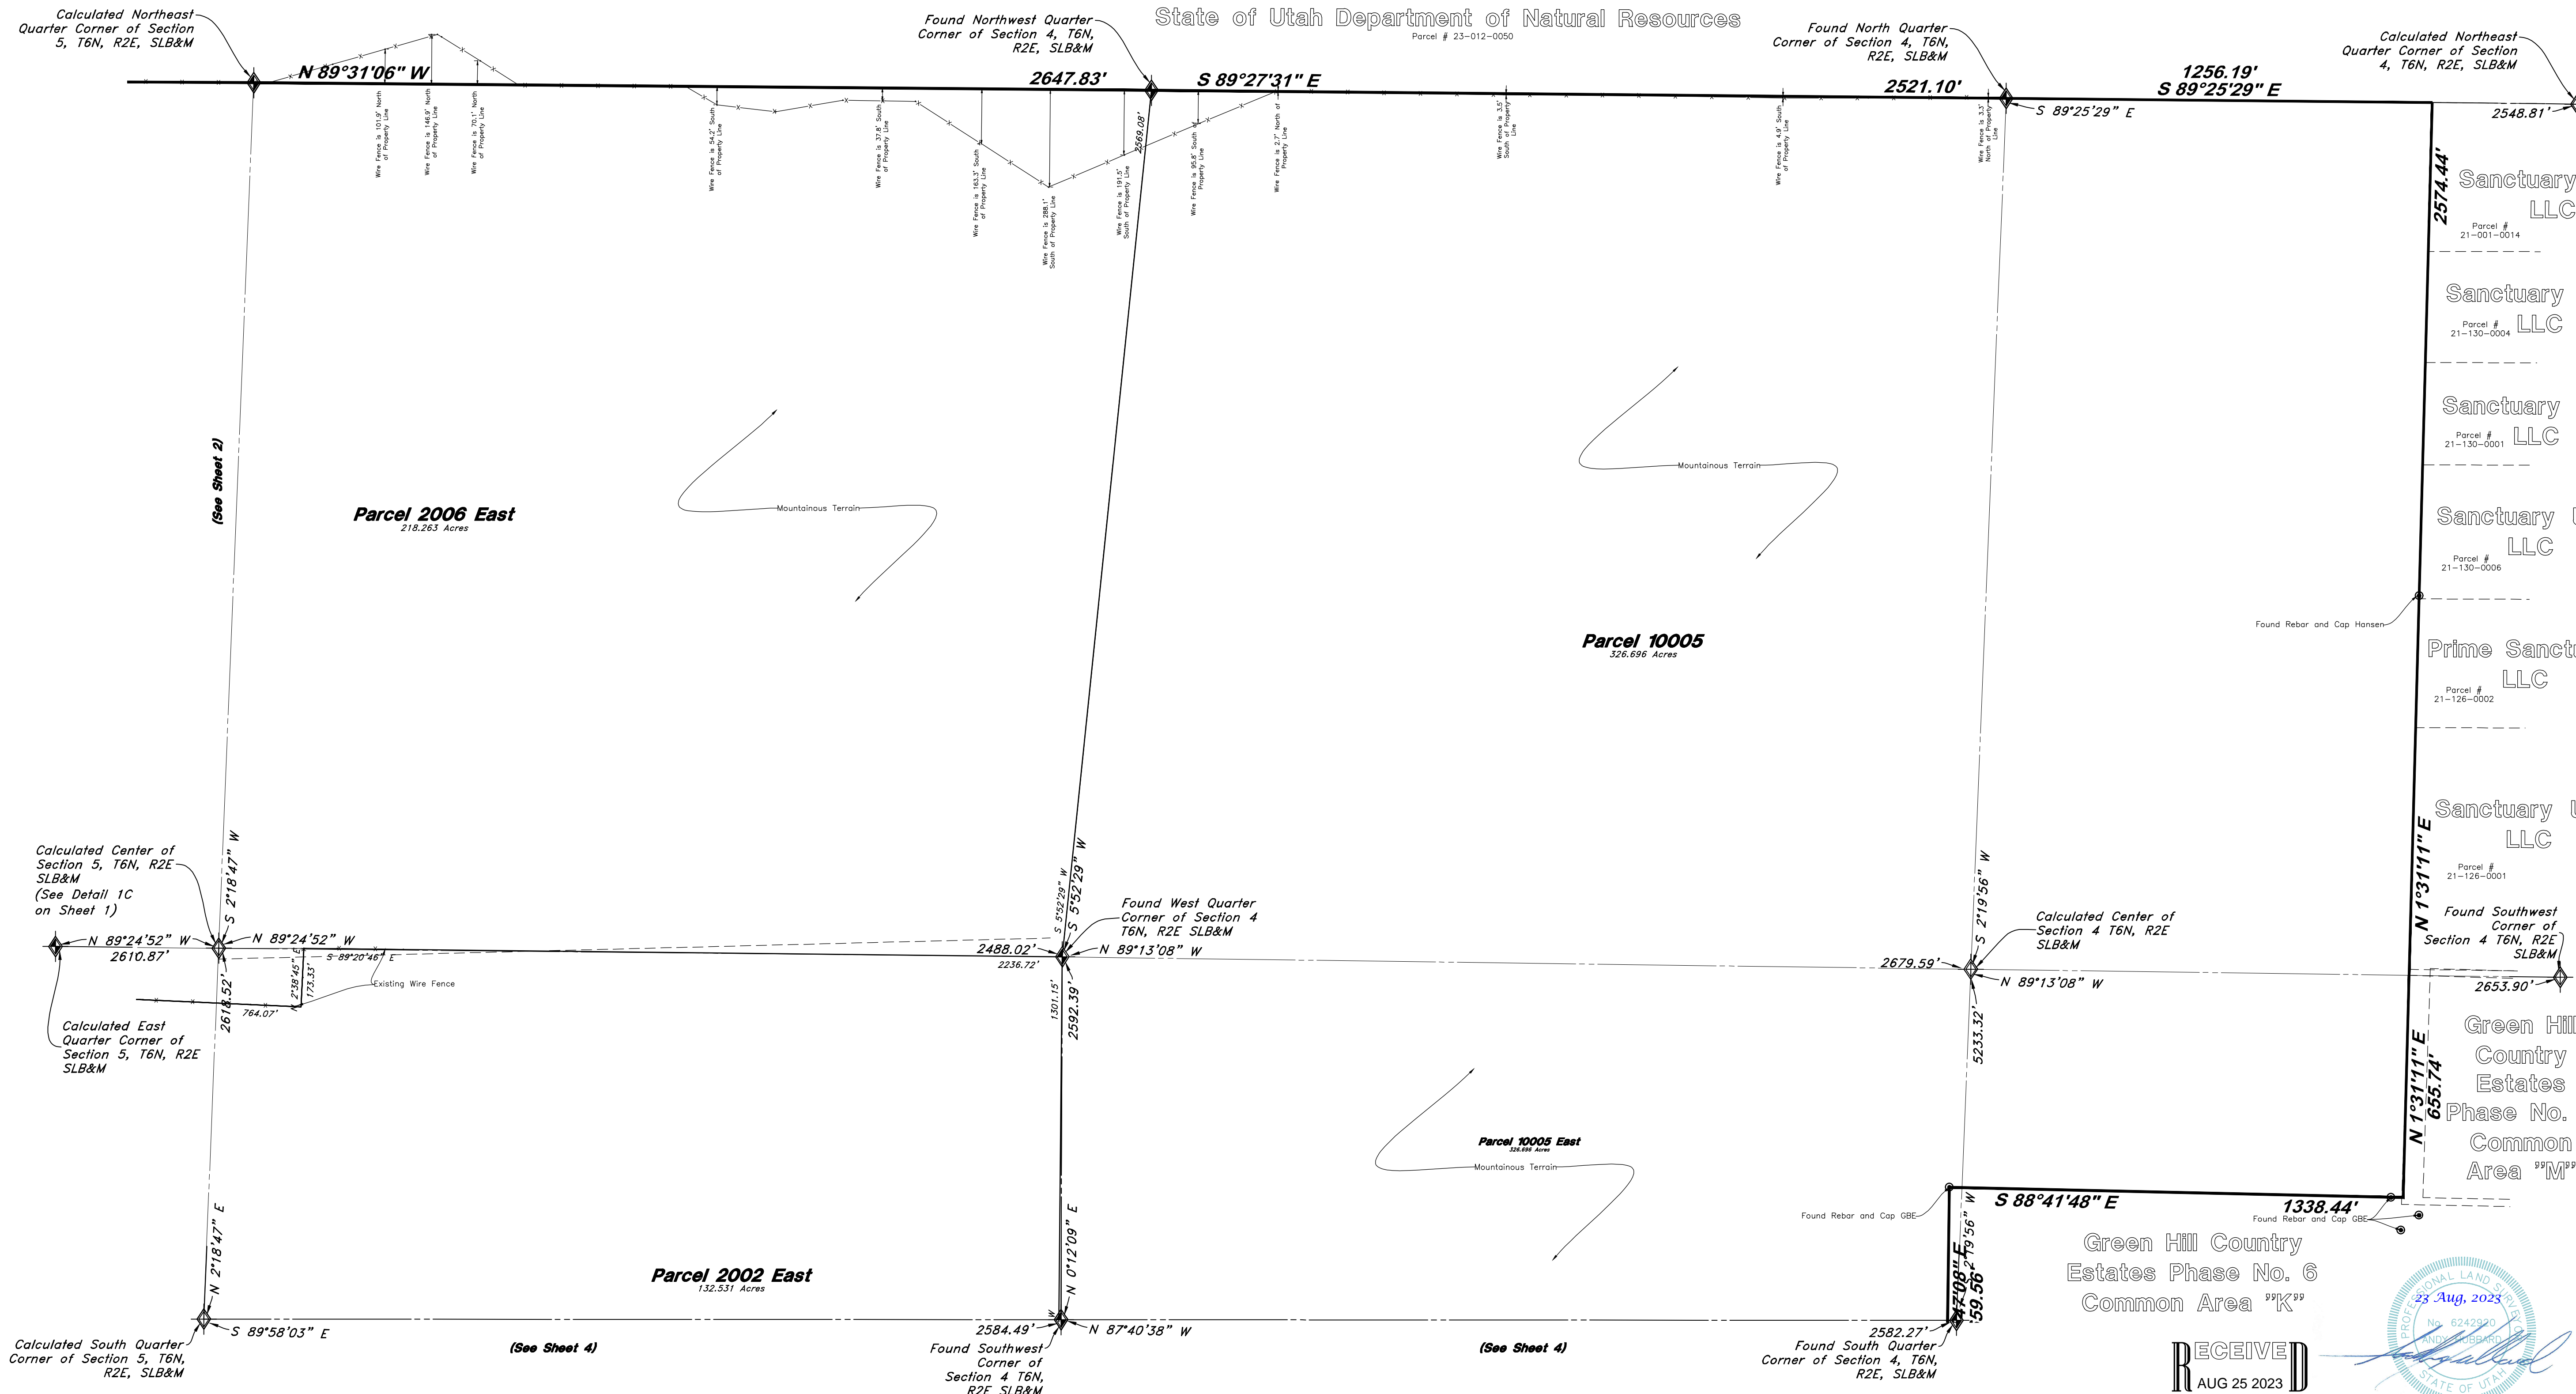

- Sanctuary Utah LLC (Parcel # 21-001-0014)
- Sanctuary Utah LLC (Parcel # 21-130-0004)
- Sanctuary Utah LLC (Parcel # 21-130-0001)
- Sanctuary Utah LLC (Parcel # 21-130-0006)

- Sanctuary Utah LLC (Parcel # 21-126-0001)
- Green Hill Country Estates Phase No. 8 Common Area "M"

REF	DATE	DESCRIPTION

**GREAT BASIN ENGINEERING**  
5746 SOUTH 1475 EAST OGDEN, UTAH 84403  
MAIN (801)394-4515 S.L.C (801)521-0222 FAX (801)392-7544  
WWW.GREATBASINENGINEERING.COM

**Record of Survey**  
**Middlefork Ranch LLC**  
1450 North 7900 East  
Huntsville, Utah  
A part of Sections 4 & 5, T6N, R2E, SLB&M, U.S. Survey

Green Hill Country Estates Phase No. 6 Common Area "K"

RECEIVED  
AUG 25 2023  
FILE # 7635

Jan, 2023  
SHEET NO. 5 of 5  
13N778

PARCEL LINE DATA		
SEGMENT	LENGTH	BEARING
L1	52.37'	S58° 08' 52"E
L2	144.07'	S25° 32' 32"E
L3	331.52'	S50° 18' 32"E
L4	310.38'	S3° 17' 32"E
L5	140.18'	S45° 15' 28"W
L6	91.20'	S28° 45' 28"W
L7	125.10'	S12° 14' 28"W
L8	163.20'	S83° 41' 28"W
L9	11.91'	S46° 18' 06"W
L10	187.05'	S8° 55' 28"W
L11	881.30'	S40° 47' 32"E
L12	227.00'	S23° 12' 32"E
L13	68.00'	S58° 55' 32"E
L14	52.60'	S5° 07' 32"E
L15	5.00'	N84° 52' 28"E
L16	294.40'	S5° 07' 32"E
L17	48.20'	S36° 04' 32"E
L18	27.80'	S21° 55' 28"W
L19	304.40'	S5° 13' 32"E
L20	107.20'	S46° 52' 32"E

PARCEL LINE DATA		
SEGMENT	LENGTH	BEARING
L21	247.17'	S35° 40' 32"E
L22	400.17'	S29° 23' 32"E
L23	58.99'	S33° 06' 32"E
L24	219.85'	S36° 49' 32"E
L25	425.61'	S43° 34' 32"E
L26	302.71'	S47° 59' 32"E
L27	114.54'	S89° 05' 18"E
L28	1115.33'	N41° 54' 49"E
L29	175.09'	N58° 08' 52"W
L30	143.95'	N25° 32' 32"W
L31	329.47'	N50° 18' 32"W
L32	246.60'	N3° 17' 32"W
L33	50.20'	N31° 30' 28"E
L34	150.20'	N45° 15' 28"E
L35	26.60'	N12° 14' 28"E
L36	254.74'	N52° 06' 28"E
L37	198.27'	N8° 55' 28"E
L38	26.70'	S81° 04' 32"E
L39	378.90'	N63° 32' 28"E
L40	40.00'	N26° 27' 32"W

PARCEL LINE DATA		
SEGMENT	LENGTH	BEARING
L41	378.90'	S63° 32' 28"W
L42	31.95'	N81° 04' 32"W
L43	881.30'	N40° 47' 32"W
L44	227.00'	N23° 12' 32"W
L45	68.00'	N58° 55' 32"W
L46	52.60'	N5° 07' 32"W
L47	5.00'	N84° 52' 28"E
L48	294.40'	N5° 07' 32"W
L49	48.20'	N36° 04' 32"W
L50	27.80'	N21° 55' 28"E
L51	304.40'	N5° 13' 32"W
L52	86.70'	N46° 52' 32"W
L53	5.00'	N43° 07' 28"E
L54	20.50'	N46° 52' 32"W
L55	241.96'	N35° 40' 32"W
L56	394.96'	N29° 23' 32"W
L57	96.36'	N36° 49' 32"W
L77	504.61'	S13° 25' 31"E
L84	210.03'	S89° 42' 41"E
L85	213.52'	N26° 35' 42"E

PARCEL LINE DATA		
SEGMENT	LENGTH	BEARING
L86	130.47'	N61° 20' 42"W
L87	203.01'	S66° 20' 47"W

PROPERTY LINE CURVE DATA					
SEGMENT	LENGTH	RADIUS	DELTA	Chord	Chord Bearing
C1	11.42	19.81	33.01	36.935'	N42°02'54"W
C2	19.77	41.15	27.53	64.246'	N39°08'41"W
C3	16.26	19.81	47.02	51.855'	N26°48'02"W
C4	13.18	21.34	35.38	42.545'	N81°13'58"E
C5	5.65	9.14	35.38	18.234'	S81°13'58"W
C6	34.47	42.67	46.28	110.026'	N17°39'15"W
C7	52.38	170.69	17.58	171.183'	N32°00'02"W
C8	26.60	42.67	35.72	85.866'	N41°04'02"W
C9	17.17	18.29	53.80	54.292'	N32°01'32"W
C10	32.11	59.44	30.95	104.059'	N20°36'02"W
C11	16.97	16.76	58.00	53.329'	N7°04'32"W
C12	64.27	135.64	27.15	208.899'	N8°20'58"E
C13	43.21	59.44	41.65	138.651'	N26°03'02"W
C14	26.81	137.16	11.20	87.825'	N41°16'32"W
C15	21.75	167.64	7.43	71.305'	N33°06'32"W
C16	24.49	42.67	32.88	79.249'	S41°59'01"E
C17	9.23	18.29	28.91	29.958'	S39°45'15"E
C18	35.02	42.67	47.02	111.687'	S26°48'02"E
C19	15.88	18.29	49.77	50.493'	S15°54'32"E
C20	59.87	195.07	17.58	195.638'	S32°00'02"E

PROPERTY LINE CURVE DATA					
SEGMENT	LENGTH	RADIUS	DELTA	Chord	Chord Bearing
C21	11.40	18.29	35.72	36.800'	S41°04'02"E
C22	40.07	42.67	53.80	126.682'	S32°01'32"E
C23	17.29	32.00	30.95	56.032'	S20°36'02"E
C24	44.74	44.20	58.00	140.595'	S7°04'32"E
C25	51.27	108.20	27.15	166.650'	S8°20'58"W
C26	23.26	32.00	41.65	74.658'	S26°03'02"E
C27	32.47	166.12	11.20	106.365'	S41°16'32"E

RECEIVED  
AUG 25 2023  
FILE # 7635



**GREAT BASIN ENGINEERING**  
 5746 SOUTH 1475 EAST OGDEN, UTAH 84403  
 MAIN (801)394-4515 S.L.C (801)521-0222 FAX (801)392-7544  
 WWW.GREATBASINENGINEERING.COM

**Record of Survey**  
**Middlefork Ranch LLC**  
 1450 North 7900 East  
 Huntsville, Utah  
 A part of Sections 4 & 5, T6N, R2E, SLB&M, U.S. Survey

Jan, 2023  
 SHEET NO. **6** of 6  
 13N778