


(6N3W23NE)

(6N3W24N)

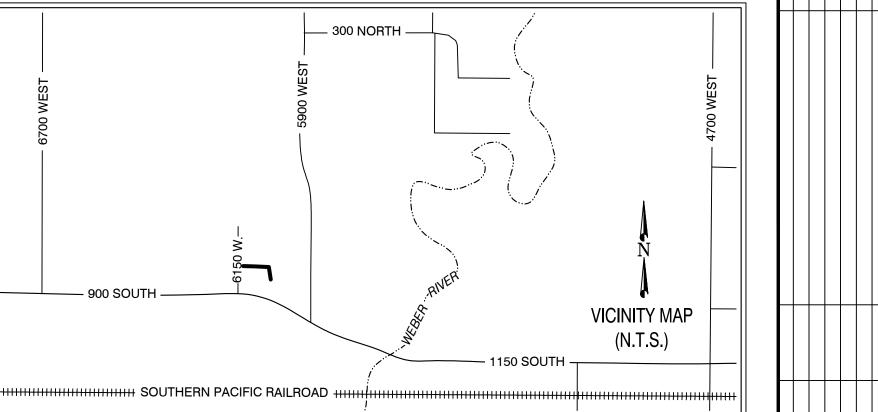

Common Boundary Line Descriptions

A common boundary line between the following two (2) entire tracts of land described in that: 1) Quit Claim Deed recorded November 4, 2022 as Entry No. 3262375 and; 2) Quit Claim Deed recorded March 9, 2016 as Entry No. 2782048 in the Office of the Weber County Recorder. Said common boundary line is located in the Southeast Quarter of Section 13, Township 6

Beginning at a point on a easterly boundary line of a 21.0' foot wide strip of land known as 6150 West described in that Quit Claim Deed recorded October 28, 2022 as Entry No. 3261356 in the Office of said Recorder, which is 2290.66 feet S. 00°11'57" W. along the Section line and 1288.29 feet N. 89°19'41" W. from the East Quarter Corner of said Section 13, said point being 2654.54 feet S. 89°10'53" E. along the Section line to the South Quarter of said Section 13 and 1350.68 feet S. 89°20'15" E. along the Section line and 346.07 feet North from the Southwest Corner of said Section 13; thence S. 88°49'35" E. 30.06 feet; thence S. 87°10'51" E. 36.82 feet to the end of an existing wire fence and top bank of slough; thence S. 08°37'04" E. 32.71 feet along said top bank of slough to an existing #5 rebar and yellow cap stamped "PLS 356548" as shown on that Record of Survey & Parcel Adjustment survey filed as 7384 in the Office of the Weber County Surveyor and the **Point of Terminus**.


This survey and resulting boundary line agreements were completed at the requested of Dallin Curriden with BlackPine LLC to define a common boundary line between the Wadeland Land LLC property having parcel numbers 10-035-0008 and the Lonn Knight property having Parcel No. 10-035-0066 in the Office of the Weber County Recorder. The following documents were

- Quit Claim Deed recorded November 4, 2022 as Entry No. 3262375 in the Office of the Weber County Recorder;

- Record of Survey of Parcel Line Adjustment prepared by Boundary Consultants filed as 7384.

The basis of bearing for this survey is N. 00°46'18" E. along the Section line between the East Quarter Corner and the Northeast Corner of Section 13, Township 6 North, Range 3 West, Salt Lake Base and Meridian.

accordance with Title 58, Chapter 22, Professional Engineers and Professional Land Surveyors Licensing Act. I further certify that a survey of the land shown hereon is a correct representation of the land surveyed and has been prepared in conformity

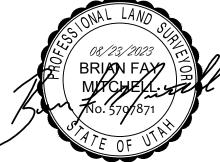

SHEET NO. 1 OF 1

RECORD BOUNDARY

PROJECT ID: DATE: 08/23/2023 S22-191 FILE NAME: