

on the ground. The descriptions on Entry #2068990 are poorly written. It appears that dimensions from the ownership plat were used to write the descriptions instead of dimension shown on Drawing #2679 of the Ogden City Survey which do not agree. There are bounds to lot corners and lot lines on a few calls which have been held for the position of the parcels when available. All other lines are shown as described with dimensions to occupation lines. Boundary line agreements may be needed to bring descriptions and occupations into agreement.

<u>Surveyor's Certificate</u>

I, Nathan B. Weber, certify that I am a Professional Land Surveyor as prescribed under the laws of the state of Utah and that I hold license no. 5152762. I further certify that a land survey was made of the property described below, and the findings of that survey are as shown hereon.

Deed Description <u>Entry#2068990</u>

PARCEL 1:

PART OF LOTS 4, 5 AND 6, BLOCK 2, PLAT A, OGDEN CITY SURVEY; BEGINNING AT THE NORTHWEST CORNER OF SAID LOT 5, RUNNING THENCE SOUTH 86 FEET, THENCE EAST 16 RODS, THENCE NORTH 86 FEET MORE OR LESS TO A POINT EAST OF THE BEGINNING, THENCE WEST TO THE NORTHWEST CORNER OF LOT 4, THENCE NORTH 4 FEET, THENCE WEST TO THE WEST LINE OF LOT 6, THENCE SOUTH 4 FEET TO THE PLACE OF BEGINNING.

SUBJECT TO RIGHT OF WAY ALONG THE MOST NORTHERLY 4 FEET AS DISCLOSED BY VARIOUS DEEDS OF RECORD.


PARCEL 2:


PART OF LOT 3, BLOCK 2, PLAT A, OGDEN CITY SURVEY: BEGINNING AT A POINT 240 FEET NORTH OF THE SOUTHWEST CORNER OF SAID LOT 3, AND RUNNING THENCE NORTH 90 FEET TO THE NORTHWEST CORNER OF SAID LOT; THENCE EAST 77 FEET 9 INCHES TO THE WEST LINE OF HINCHCLIFF PROPERTY AS DETERMINED BY COURT DECREE: THENCE SOUTH 90 FEET. MORE OR LESS, TO A POINT EAST OF BEGINNING; THENCE WEST 77 FEET 9 INCHES, MORE OR LESS TO BEGINNING;

TOGETHER WITH AND SUBJECT TO A RIGHT OF WAY BEGINNING AT A POINT 32 FEET EAST OF THE SOUTHWEST CORNER OF LOT 3, THENCE EAST 10 FEET; THENCE NORTH 15 RODS; THENCE WEST 10 FEET; THENCE SOUTH 15 RODS TO THE PLACE OF BEGINNING.

PARCEL 3:

PART OF LOT 3, BLOCK 2, PLAT A, OGDEN CITY SURVEY: BEGINNING AT A POINT 257 FEET NORTH OF THE SOUTHEAST CORNER OF SAID LOT 3, RUNNING THENCE WEST 56 FEET, THENCE NORTH 73 FEET, THENCE EAST 56 FEET, THENCE SOUTH 73 FEET TO THE PLACE OF BEGINNING.

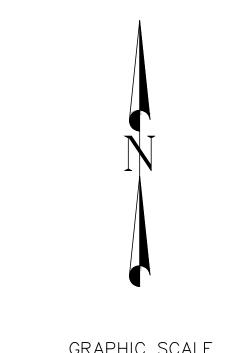

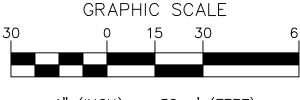

1"(INCH) = 30'(FEET)

ECEIVE SEPT 21 2023 FILE <u># 7651</u>

LEGEND	
	Boundary Line Centerline Adjoiner Line Tie Line Right—of—Way Line Fence Line Edge of Asphalt
	Right—of—Way Hatch
۲	Property Corner
\$	Street Monument

The basis of bearing is South 0°58'00" West between the found monuments in Adams Avenue at the intersections of 27th Street and 28th Street located in the Northwest Quarter of Section 33, Township 6 North, Range 1 West, Salt Lake Base and Meridian as shown.

The purpose of this survey is to retrace and monument the boundary of the above described property according to the official records and the location of pertinent existing improvements located

> LOCATED IN THE NORTHWEST QUARTER OF SECTION 33, TOWNSHIP 6 NORTH, RANGE 1 WEST, SALT LAKE BASE AND MERIDIAN

B	SURVEY DATE: 6/30/2021	
REVISIONS		
No. DATE	DRAWN BY: MGO	
No. 5152762 No. 51		
Boundary Surveys Topography Surveys Subdivisions Construction Staking A.L.T.A. & A.C.S.M. Surveys		
DIAMOND LAND SURVEYING	6891 South 700 West Ste. 150 Midvale, Utah 84047 Phone (801) 266-5099 Fax (801) 266-5032 office@diamondlandsurveying.com www.diamondlandsurveying.com	
BOUNDARY SURVEY 2748 ADAMS AVENUE OGDFN, UT	PAAG	
COP YRIGHT ALL REPORTS, DESIGNS, FIELD DATA, FIELD NOTES, DRAWINGS, SPECIFICATIONS, CALCULATIONS, ESTIMATES OR ANY REPRESENTATION CONTAINED HEREON ARE THE SOLE PROPERTY OF DIAMOND DESIGN AND LAND SURVEVING UNLESS PREVIOUSLY ESTABLISHED BY PRECEDENCE OR WRITTEN AGREEMENT		
JOB No. SHEET	ED 8/16/21 21-160 OF 1	