

LAWS OF THE STATE OF UTAH AND THAT I HOLD LICENSE NO. 5152762. I FURTHER CERTIFY THAT A LAND SURVEY WAS MADE OF THE PROPERTY DESCRIBED BELOW, AND THE FINDINGS OF THAT SURVEY ARE AS SHOWN

PARCEL 1 (06-016-0141) PART OF THE SOUTHWEST QUARTER OF SECTION 7, TOWNSHIP 5 NORTH, RANGE 1 WEST, SALT LAKE BASE & MERIDIAN, US SURVEY: BEGINNING ON THE NORTH LINE RIVERDALE ROAD, SAID POINT BEING 26.95 FEET SOUTH 018'31" WEST AND 1168.0 FEET NORTH 6415' EAST ALONG THE NORTH LINE OF RIVERDALE ROAD FROM THE SOUTHWEST CORNER OF SAID SECTION 7, SAID POINT ALSO BEING ON THE SOUTHEAST CORNER OF THE PROPERTY CONVEYED TO C C PINGREE BY WARRANTY DEED IN BOOK 402 OF RECORDS PAGE 507, RUNNING THENCE NORTH 6415' EAST 438.65 FEET ALONG THE NORTH LINE OF RIVERDALE ROAD TO THE WEST LINE OF 900 WEST STREET, THENCE TWO COURSES ALONG SAID WEST LINE AS FOLLOWS: NORTH 0'38'20" EAST 340.34 FEET, AND NORTH 2'33'12" EAST 264.69 FEET TO THE SOUTH LINE OF AN EXISTING STREET, BEING 4600 SOUTH STREET, THENCE NORTH 89°22'30" WEST 378.40 FEET ALONG SAID SOUTH LINE OF SAID EXISTING STREET, BEING 4600 SOUTH STREET, THENCE SOUTH 0°44'15" WEST 646.45 FEET, THENCE NORTH 89°32' WEST 22.74 FEET, THENCE SOUTH 0°28' WEST 153.23 FEET TO THE POINT OF BEGINNING. RESERVING UNTO THE GRANTOR OVER AND ACROSS THE ABOVE-DESCRIBED TRACT AN EASEMENT AND RIGHT OF WAY 1 ROD IN WIDTH, EXTENDED 16.5 FEET TO THE EAST OF THE WEST BANK OF THE NOW EXISTING IRRIGATION DITCH, WHICH EXTENDS IN A GENERALLY NORTH SOUTH DIRECTION ALONG THE WEST LINE OF SAID TRACT, FOR THE MAINTENANCE AND USE OF SAID IRRIGATION DITCH AS IT SERVES GRANTORS PREMISES TO THE NORTH OF THE CONVEYED PREMISES. SUBJECT TO PERPETUAL 16 1/2 FOOT EASEMENT AND RIGHT OF WAY (1469-477), EXCEPTING ANY PART OF THE FOLLOWING: PARCEL OF LAND IN FEE, BEING A PART OF AN ENTIRE TRACT OF PROPERTY, SITUATE IN THE SOUTHWEST 1/4 SOUTHWEST 1/4 OF SECTION 7, TOWNSHIP 5 NORTH, RANGE 1 WEST, SALT LAKE BASE & MERIDIAN, THE BOUNDARIES OF SAID PARCEL OF LAND ARE DESCRIBED AS FOLLOWS: BEGINNING AT THE INTERSECTION OF THE WESTERLY BOUNDARY LINE OF SAID ENTIRE TRACT AND THE NORTHWESTERLY RIGHT OF WAY LINE OF THE EXISTING HIGHWAY STATE ROUTE 26, SAID INTERSECTION IS 26.93 FEET (26.95 FEET BY RECORD) SOUTH 0018'31" WEST AND 912.51 FEET NORTH 64"15'12" EAST (912.70 FEET NORTH 64"15'00" EAST BY RECORD) ALONG SAID NORTHWESTERLY RIGHT OF WAY LINE FROM THE SOUTHWEST CORNER OF SAID SECTION 7, SAID INTERSECTION IS ALSO APPROXIMATELY 59.94 FEET PERPENDICULARLY DISTANT NORTHWESTERLY FROM THE CONTROL LINE OF SAID PROJECT SP-0026(4)0 OPPOSITE ENGINEER STATION 81+83.92 AND RUNNING THENCE NORTH 02°28'19" WEST 12.58 FEET ALONG SAID WESTERLY BOUNDARY LINE TO A POINT 71.50 FEET PERPENDICULARLY DISTANT NORTHWESTERLY FROM SAID CONTROL LINE, THENCE NORTH 64"14"15" EAST 200.39 FEET ALONG A LINE PARALLEL WITH AND 71.50 FEET PERPENDICULARLY DISTANT NORTHWESTERLY FROM SAID CONTROL LINE TO A POINT OPPOSITE ENGINEER STATION 83+95.29, THENCE NORTH 68*02'59" EAST 120.42 FEET TO A POINT 63.49 FEET PERPENDICULARLY DISTANT NORTHWESTERLY FROM SAID CONTROL LINE OPPOSITE ENGINEER STATION 85+15.44, THENCE NORTH 65°23'00" EAST 184.69 FEET TO SAID NORTHWESTERLY RIGHT OF WAY LINE AT A POINT 59.80 FEET PERPENDICULARLY DISTANT NORTHWESTERLY FROM SAID CONTROL LINE OPPOSITE ENGINEER STATION 87+00.09; THENCE SOUTH 6415'12" WEST (SOUTH 6415'00" WEST BY 510.17 FEET ALONG SAID RIGHT OF WAY LINE TO THE POINT OF BEGINNING. (E# 2365586)

FROM THE SOUTHWEST CORNER OF SAID SOUTHWEST QUARTER SECTION, THENCE NORTH 1043'09" EAST 26.34 FEET TO THE SOUTHWEST CORNER OF A METAL BUILDING, AND THENCE NORTH 0*28'12" EAST 169.05 FEET ALONG THE WEST WALL OF SAID METAL BUILDING AND THE EXTENSION OF SAID WEST WALL, THENCE NORTH 53°26'14" EAST 116.80 FEET, THENCE SOUTH 89"15'45" EAST 175.53 FEET TO THE WEST PROPERTY LINE OF PETERSON INVESTMENT II, THENCE (3) THREE COURSES ALONG SAID WEST LINE AS FOLLOWS: SOUTH 0°44'15" WEST 387.18 FEET, NORTH 89'32' WEST 22.74 FEET, THENCE NORTH 4.85 FEET, THENCE NORTH 64'30' WEST 273.97 FEET TO BEGINNING. SUBJECT TO AND TOGETHER WITH A NONEXCLUSIVE TWENTY FIVE (25) FOOT ACCESS OPENING ON THE MUTUALLY SHARED EAST/WEST PROPERTY BORDER LINE FOR INGRESS AND EGRESS OF CUSTOMERS AND INVITEES OF THE TWO CONTRACTING PARTIES. SAID ACCESS SHALL BE LOCATED TO-WIT: PART OF THE SOUTHWEST QUARTER OF SECTION 7, TOWNSHIP 5 NORTH, RANGE 1 WEST, SALT LAKE MERIDIAN, U.S. SURVEY: BEGINNING AT A POINT ON THE SOUTH LINE OF 4600 SOUTH STREET AND RUNNING THENCE SOUTH 0'31' WEST (SOUTH 0'44'15" WEST) 260.00 FEET AND LOCATED WITHIN THE FIRST 50' OF A LINE RUNNING NORTH 89°15'45" WEST 175.00 FEET SAID ACCESS IS ON THE SOUTH LINE OF PROPERTY CONVEYED IN DEED RECORDED IN BOOK, PAGE. (BOOK 1632 PAGE 986) SUBJECT TO AND TOGETHER WITH A NON-EXCLUSIVE TWENTY-FIVE (25) FOOT ACCESS ON THE MUTUALLY SHARED EAST/WEST PROPERTY BORDER LINE FOR INGRESS AND EGRESS LOCATED TO WIT: PART OF THE SOUTHWEST QUARTER OF SECTION 7, TOWNSHIP 5 NORTH, RANGE 1 WEST, SALT LAKE MERIDIAN, U.S. SURVEY: BEGINNING AT A POINT ON THE NORTH LINE OF STATE ROAD 27.20 FEET, SOUTH 0°20' WEST AND

NORTH 6415' EAST 912.50 FEET FROM THE SOUTHWEST CORNER OF SAID SOUTHWEST QUARTER TO THE WEST

LINE OF PROPERTY CONVEYED IN DEED RECORDED IN BOOK 402 AT PAGE 507, THENCE NORTH 2°25' WEST 364

FEET TO THE TRUE POINT OF BEGINNING, AND RUNNING THENCE 2°25' WEST ALONG SAID EAST/WEST PROPERTY

BORDER LINE 25 FEET.

PART OF THE SOUTHWEST QUARTER OF SECTION 7, TOWNSHIP 5 NORTH, RANGE 1 WEST, SALT LAKE BASE & MERIDIAN, U S SURVEY: BEGINNING AT A POINT ON THE NORTH LINE OF THE STATE ROAD 19.05 FEET SOUTH 20' WEST AND 912.7 FEET NORTH 64"15' EAST FROM THE SOUTHWEST CORNER OF SAID QUARTER SECTION, RUNNING THENCE NORTH 2°25' WEST 389.05 FEET, MORE OR LESS, TO AN OLD FENCE LINE, THENCE SOUTH 64°39' EAST 273.87 FEET, THENCE SOUTH 0°28' WEST 153.23 FEET TO THE NORTH LINE OF SAID ROAD, THENCE SOUTH 64"15' WEST 255.3 FEET TO THE POINT OF BEGINNING. SUBJECT TO AND TOGETHER WITH THE RIGHT OF WAY (BOOK 1589 PAGE 2196 AND BOOK 1648 PAGE 2112). EXCEPTING: PARCEL OF LAND IN FEE, BEING A PART OF AN ENTIRE TRACT OF PROPERTY, SITUATE IN THE SOUTHWEST 1/4 SOUTHWEST 1/4 OF SECTION 7, TOWNSHIP 5 NORTH, RANGE 1 WEST, SALT LAKE BASE & MERIDIAN, THE BOUNDARIES OF SAID PARCEL OF LAND ARE DESCRIBED AS FOLLOWS: BEGINNING AT THE INTERSECTION OF THE WESTERLY BOUNDARY LINE OF SAID ENTIRE TRACT AND THE NORTHWESTERLY RIGHT OF WAY LINE OF THE EXISTING HIGHWAY STATE ROUTE 26, SAID INTERSECTION IS 26.93 FEET (26.95 FEET BY RECORD) SOUTH 0018'31" WEST AND 912.51 FEET NORTH 6415'12" EAST (912.70 FEET NORTH 6415'00" EAST BY RECORD) ALONG SAID NORTHWESTERLY RIGHT OF WAY LINE FROM THE SOUTHWEST CORNER OF SAID SECTION 7. SAID INTERSECTION IS ALSO APPROXIMATELY 59.94 FEET PERPENDICULARLY DISTANT NORTHWESTERLY FROM THE CONTROL LINE OF SAID PROJECT SP-0026(4)0 OPPOSITE ENGINEER STATION 81+83.92 AND RUNNING THENCE NORTH 02°28'19" WEST 12.58 FEET ALONG SAID WESTERLY BOUNDARY LINE TO A POINT 71.50 FEET PERPENDICULARLY DISTANT NORTHWESTERLY FROM SAID CONTROL LINE, THENCE NORTH 64"14'15" EAST 200.39 FEET ALONG A LINE PARALLEL WITH AND 71.50 FEET PERPENDICULARLY DISTANT NORTHWESTERLY FROM SAID CONTROL LINE TO A POINT OPPOSITE ENGINEER STATION 83+95.29, THENCE NORTH 68°02'59" EAST 120.42 FEET TO A POINT 63.49 FEET PERPENDICULARLY DISTANT NORTHWESTERLY FROM

SAID CONTROL LINE OPPOSITE ENGINEER STATION 85+15.44. THENCE NORTH 65°23'00" EAST 184.69 FEET TO SAID

NORTHWESTERLY RIGHT OF WAY LINE AT A POINT 59.80 FEET PERPENDICULARLY DISTANT NORTHWESTERLY FROM


SAID CONTROL LINE OPPOSITE ENGINEER STATION 87+00.09: THENCE SOUTH 64"15'12" WEST (SOUTH 64"15'00"


WEST BY RECORD) 510.17 FEET ALONG SAID RIGHT OF WAY LINE TO THE POINT OF BEGINNING. (E# 2365586)

SAID QUARTER SECTION. RUNNING THENCE NORTH 0°44'15" EAST 220.07 FEET ALONG SAID FENCE; THENCE SOUTH 87*26'48" EAST 393.47 FEET TO THE WEST LINE OF 900 WEST STREET; THENCE SOUTH 2*23'12" WEST 219.93 FEET ALONG SAID STREET, THENCE NORTH 87°26'48" WEST 393.47 FEET, MORE OR LESS, TO THE POINT OF BEGINNING. SUBJECT TO A PERPETUAL 16 1/2 FOOT EASEMENT & RIGHT-OF- WAY. (1469-477).

PART OF THE SOUTHWEST QUARTER OF SECTION 7, TOWNSHIP 5 NORTH, RANGE 1 WEST, SALT LAKE BASE AND MERIDIAN, U.S. SURVEY: BEGINNING ON THE WEST LINE OF 900 WEST STREET. SAID POINT BEING 26.95 FEET SOUTH 018'31" WEST 1455.14 FEET, NORTH 6415' EAST ALONG THE NORTH LINE OF RIVERDALE ROAD 41.60 FEET, NORTH 87°00' WEST 197.64 FEET, NORTH 64°15' EAST TO THE SAID WEST LINE OF 900 WEST STREET 318.00 FEET, NORTH 0°38'20" EAST ALONG SAID WEST LINE AND 324.72 FEET NORTH 2°33'12" EAST ALONG SAID WEST LINE FROM THE SOUTHWEST CORNER OF SAID SECTION 7, RUNNING THENCE NORTH 89°22'30" WEST 378.19 FEET ALONG THE NORTH LINE OF 4600 SOUTH STREET, THENCE NORTH 0'44'15" EAST 202.67 FEET, MORE OR LESS, THENCE SOUTH 87'26'48" EAST 393.47 FEET, MORE OR LESS, TO THE WEST LINE OF 900 WEST STREET, THENCE SOUTH 2'23'12" WEST 189.52 FEET, MORE OR LESS, TO THE POINT OF BEGINNING. SUBJECT TO A PERPETUAL 16 1/2 FOOT EASEMENT AND RIGHT OF WAY. (ORDER BOOK 1469 PAGE 477).

FILE # 7653

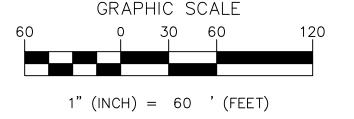

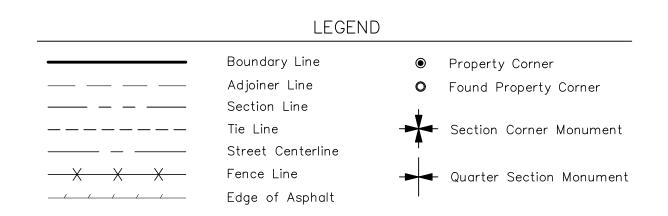

Narrative:

The basis of bearing is South 0°19'57" West between the found brass cap monuments at the Southwest Corner of Section 7 and the West Quarter Corner of Section 18, Township 5 North, Range 1 West, Salt Lake Base and Meridian as shown. The basis of bearing matches the first call in the Description of parcel 3 and is the basis of bearing used on other surveys of the same property and surveys of adjoining properties. Parcels 1, 3, 4 and 5 were rotated to match the basis of bearing of this survey.

The purpose of this survey is to retrace and monument the boundary of the above described property according to the official records and the location of pertinent existing improvements located on the ground.

> LOCATED IN THE SOUTHWEST QUARTER OF SECTION 7 TOWNSHIP 5 NORTH. RANGE 1 WEST. SALT LAKE BASE AND MERIDIAN


COPYRIGHT ALL REPORTS, DESIGNS, FIELD DATA, FIELD NOTES, DRAWINGS, SPECIFICATIONS, CALCULATIONS, ESTIMATES OR ANY REPRESENTATION CONTAINED HEREON ARE THE SOLE PROPERTY OF DIAMOND DESIGN ANI LAND SURVEYING UNLESS PREVIOUSLY ESTABLISHED BY PRECEDENCE OR WRITTEN AGREEMENT

DATE PLOTTED 2/28/19 19 - 031