


SITE

LOT 1
BLOCK 30, PLAT "A",
OGDEN CITY SURVEY

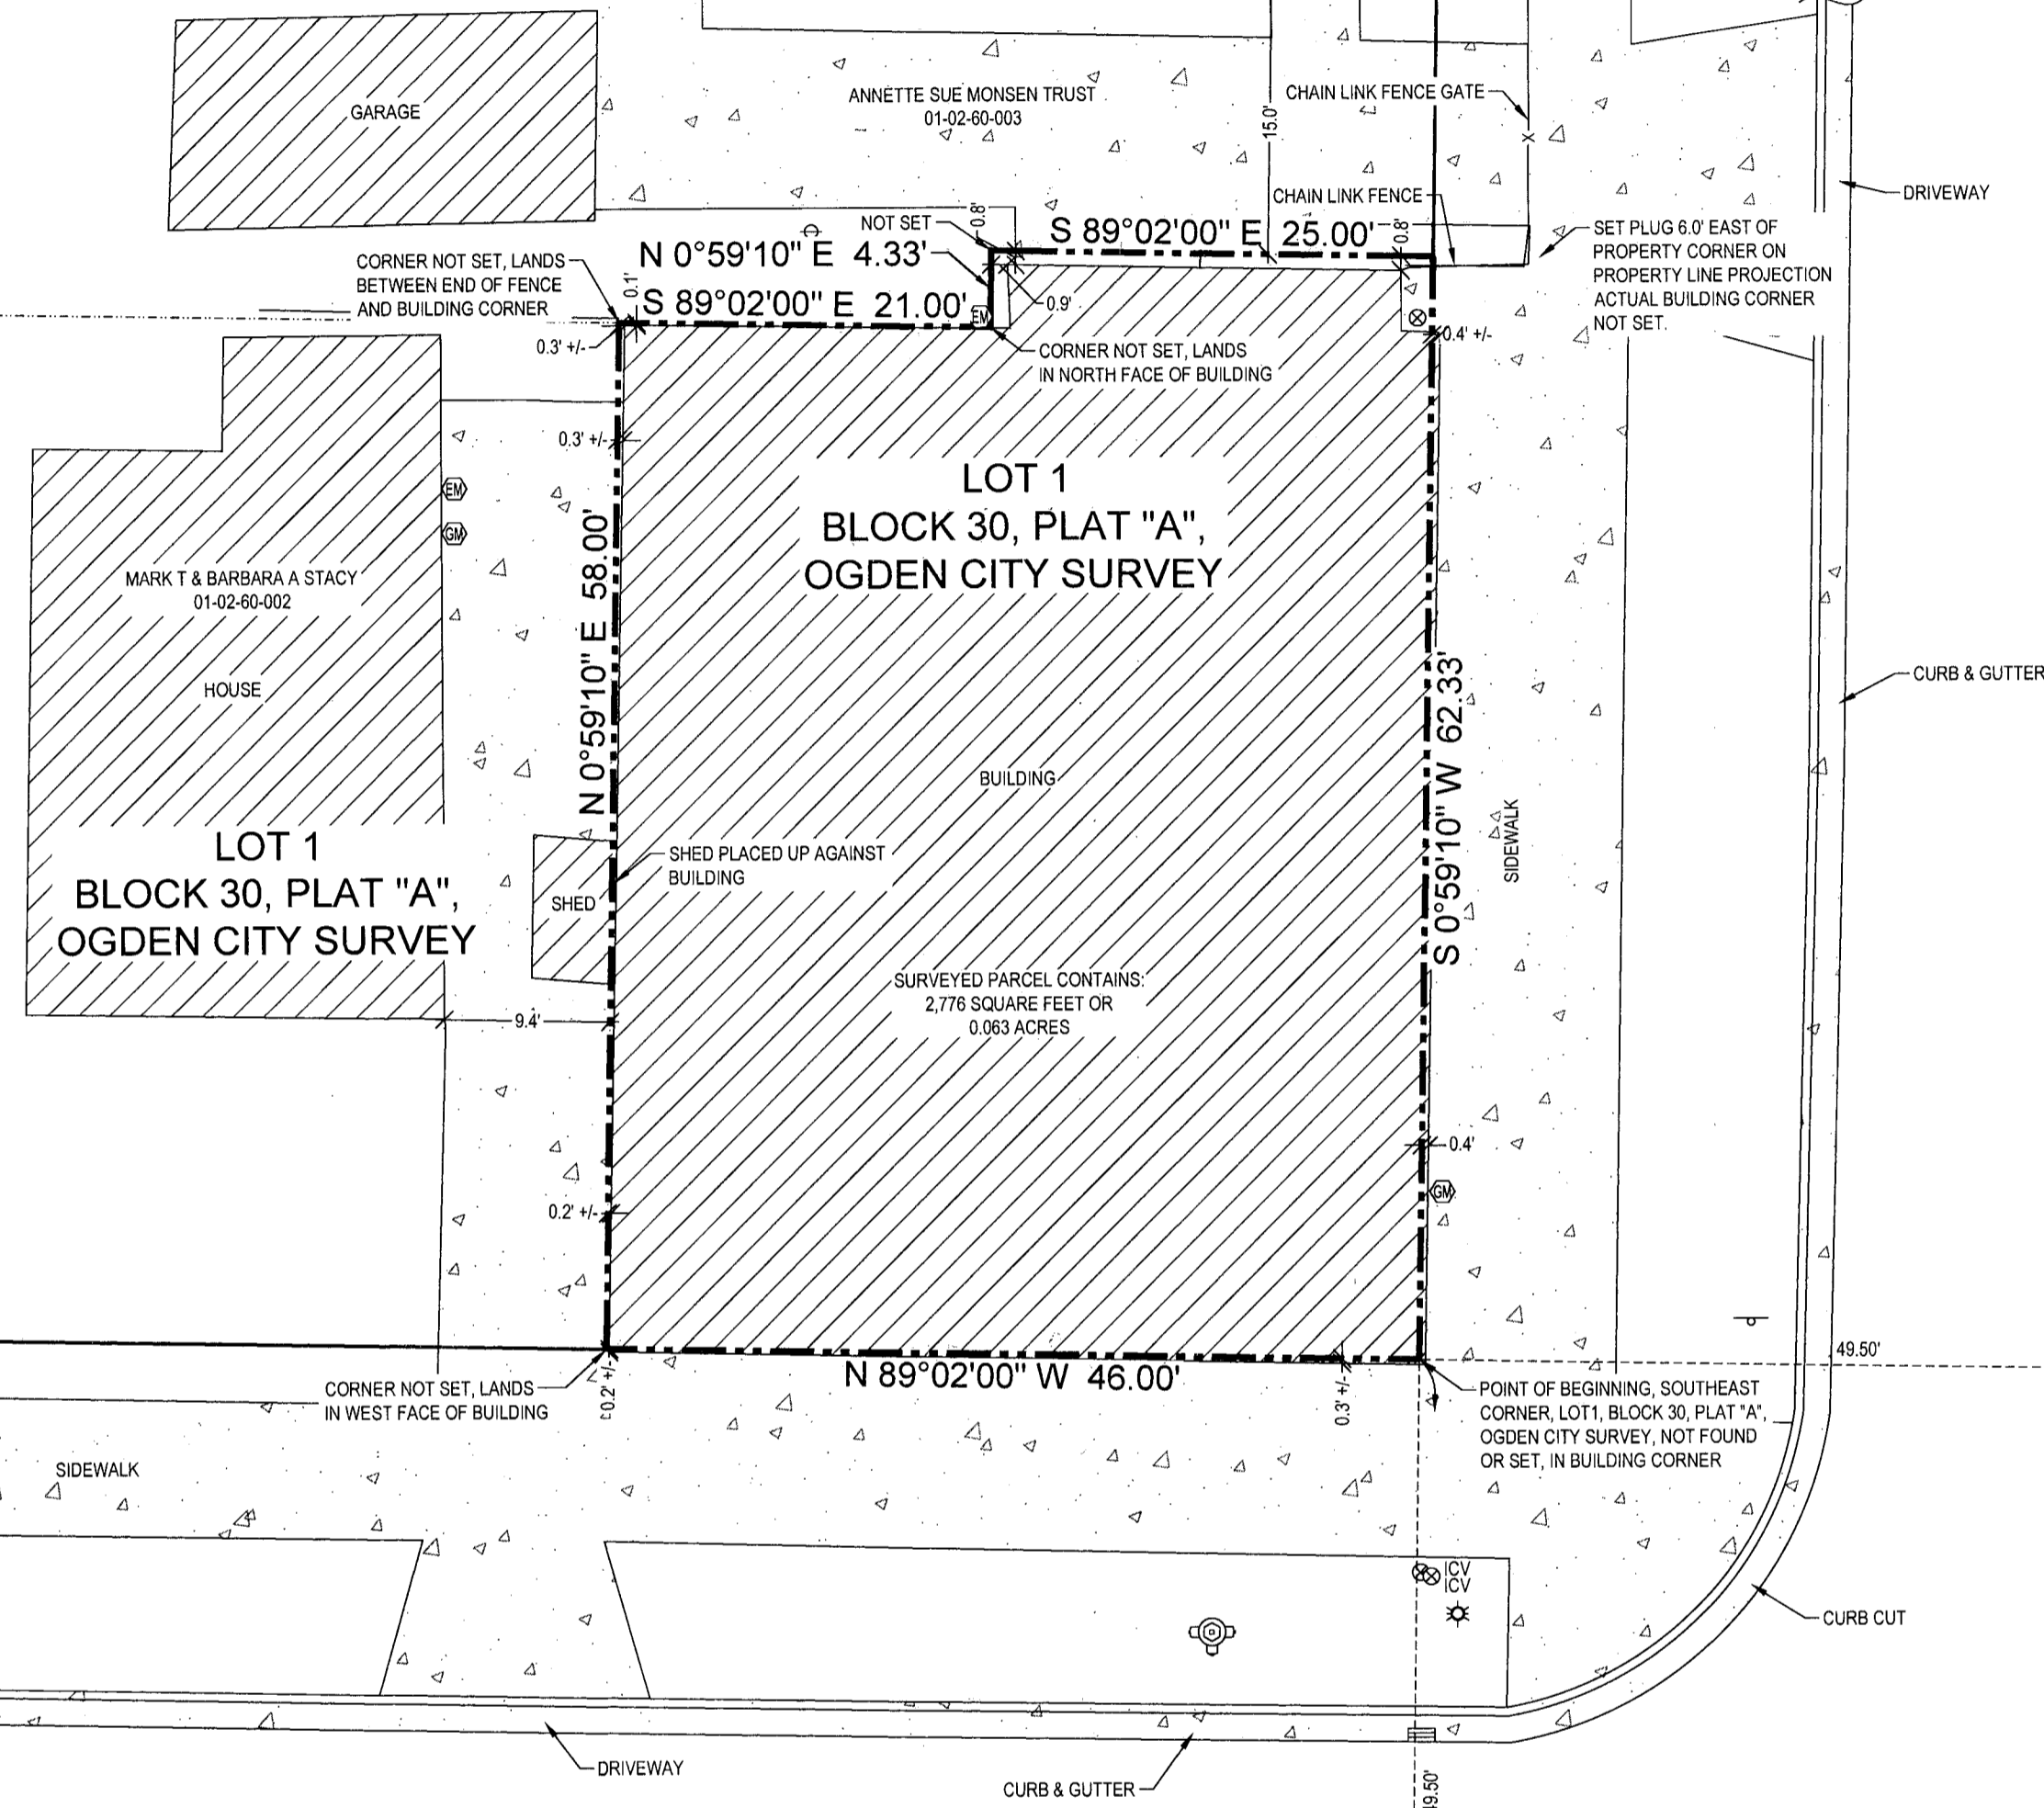

23RD STREET


FOUND BRASS CAP MONUMENT
WITH RING & LID

JEFFERSON AVENUE
(PAVED PUBLIC RIGHT OF WAY)
S 0°59'10" W 763.36' (N 0°59'07" E)

24TH STREET

(PAVED PUBLIC RIGHT OF WAY)
BASIS OF BEARING S 89°02'00" E 763.65'

NORTH

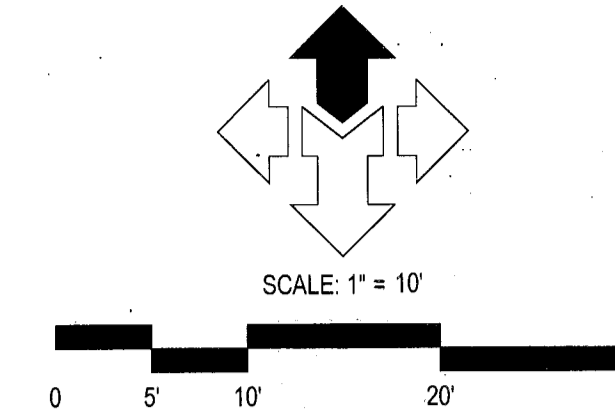


DESCRIPTION

PART OF LOT 1, BLOCK 30, PLAT A, OGDEN CITY SURVEY, WEBER COUNTY, UTAH; BEGINNING AT THE SOUTHEAST CORNER OF SAID LOT 1, AND RUNNING THENCE NORTH 49 FEET 4 INCHES, THENCE WEST 25 FEET, THENCE SOUTH 4 FEET 4 INCHES, THENCE WEST 21 FEET, THENCE SOUTH 58 FEET, THENCE EAST 48 FEET TO THE PLACE OF BEGINNING.

SURVEYOR'S CERTIFICATE

I, DAVID B. DRAPER, DEPOSE AND SAY THAT I AM A PROFESSIONAL LAND SURVEYOR ACCORDING TO THE RULES AND REGULATIONS OF THE STATE OF UTAH. I FURTHER STATE THAT THE ABOVE DESCRIBED PROPERTY WAS SURVEYED UNDER MY DIRECT SUPERVISION AND THE RESULTS OF THAT SURVEY ARE DEPICTED HEREON.

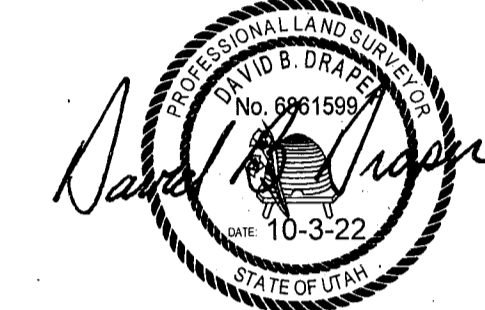

DAVID B. DRAPER

SURVEY NARRATIVE

THIS SURVEY WAS PREPARED FOR HEINRICH PROPERTIES FOR THE PURPOSE OF RE-ESTABLISHING THE BOUNDARY OF THE ABOVE DESCRIBED PARCEL OF LAND. THE BASIS OF BEARING IS SOUTH 89°02'00" EAST ALONG THE MONUMENT LINE OF 24TH STREET, BETWEEN THE BRASS CAP MONUMENTS, LOCATED AT THE INTERSECTIONS OF ADAMS AND JEFFERSON AVENUES AS SHOWN ON THIS PLAT. EVERY DOCUMENT OF RECORD REVIEWED AND CONSIDERED AS A PART OF THIS SURVEY IS NOTED HEREON. ONLY THE DOCUMENTS NOTED BELOW WERE SUPPLIED OR OBTAINED FOR OR BY THE SURVEYOR. NO ABSTRACT OF TITLE, NOR TITLE COMMITMENT, NOR RESULTS OF TITLE SEARCHES WERE FURNISHED TO THE SURVEYOR UNLESS NOTED OTHERWISE. THERE MAY EXIST OTHER DOCUMENTS OF RECORD THAT WOULD AFFECT THIS PARCEL. NO EASEMENTS ARE ADDRESSED BY THIS MAP. THE SURVEYED PROPERTY LINES WERE ESTABLISHED USING DEEDS OF THE SURVEYED AND ADJOINING PARCEL AND THE OGDEN CITY ATLAS PLAT FOR BLOCK 30.

GENERAL NOTES

- UNLESS OTHERWISE NOTED HEREON, PROPERTY CORNERS WERE SET WITH A 5/8" REBAR & CAP OR NAIL & WASHER STAMPED "MCNEIL ENG."
- THIS MAP MAKES NO ASSUMPTIONS AS TO ANY UNWRITTEN RIGHTS THAT MAY EXIST BY AND BETWEEN THE ADJOINING LANDOWNERS.
- THIS SURVEY DOES NOT PURPORT TO SHOW ALL OF THE EXISTING SITE IMPROVEMENTS WITHIN THE BOUNDS OF THE SURVEYED PARCEL. ADDITIONAL SITE IMPROVEMENTS MAY BE ENCOUNTERED UPON SITE INSPECTION.
- COURSES AND DISTANCES SHOWN ON THIS MAP ARE MEASURED DIMENSIONS UNLESS SHOWN WITHIN PARENTHESIS, INDICATING A RECORD COURSE OR DISTANCE. RECORD INFORMATION IS TAKEN FROM CITED TITLE COMMITMENT, DEEDS OF RECORD, SUBDIVISION PLATS, ROADWAY DEDICATION PLATS, CITY ATLAS PLATS, FILED SURVEYS OR OTHER SOURCES OF RECORD INFORMATION. DOCUMENTS REFERENCED FOR THIS SURVEY ARE AS FOLLOWS:
- MCNEIL ENGINEERING SURVEY, WEBER COUNTY FILE NO. 5423
- GARDNER ENGINEERING SURVEY, WEBER COUNTY FILE NO. 5106
- LANDMARK SURVEYING SURVEY, WEBER COUNTY FILE NO. 4617
- REEVES AND ASSOCIATES SURVEY, WEBER COUNTY FILE NO. 3436
- OGDEN CITY ATLAS MAP FOR BLOCK 30

LEGEND

—	RIGHT OF WAY LINE	⊗	FIRE HYDRANT
—	LOT LINE	⊕	WATER VALVE
---	PROPERTY LINE	⊙	ELECTRICAL METER
---	MONUMENT LINE	⊛	LIGHT POLE
---	SECTION LINE	⊙	UTILITY POLE
---	EASEMENT LINE	⊕	NATURAL GAS METER
-x-	FENCE	⊕	STORM DRAIN CATCH BASIN
-p-	POWER LINE	⊕	IRRIGATION CONTROL VALVE
▒	CONCRETE	⊕	TELECOMMUNICATIONS MANHOLE
▨	BUILDING	⊕	TELECOMMUNICATIONS BOX
		⊕	SIGN
		●	PROPERTY CORNER

RECEIVED
DEC 05 2023
BY: 7724

HEINRICH PROPERTIES PARCEL

584 24TH STREET
OGDEN, UTAH

LOCATED IN THE SOUTHWEST 1/4 OF SECTION 28, TOWNSHIP 6 NORTH, RANGE 1 WEST, S.L.B. & M.

REV	DATE	DESCRIPTION

PROJECT NO:	22530
CAD FILE:	22530BND
DRAWN BY:	KSL/KEG
CALC BY:	EAM
FIELD CREW:	HBD
CHECKED BY:	DBD
DATE:	10-3-22

BOUNDARY SURVEY

MCNEIL ENGINEERING
Economic and Sustainable Designs, Professionals You Know and Trust.
8610 South Sandy Parkway, Suite 200, Sandy, Utah 84070 801.555.7700 mcnileengineering.com
Civil Engineering • Consulting & Landscape Architecture
Structural Engineering • Land Surveying & HDS