MONSEN ENGINEERING CO. 111561

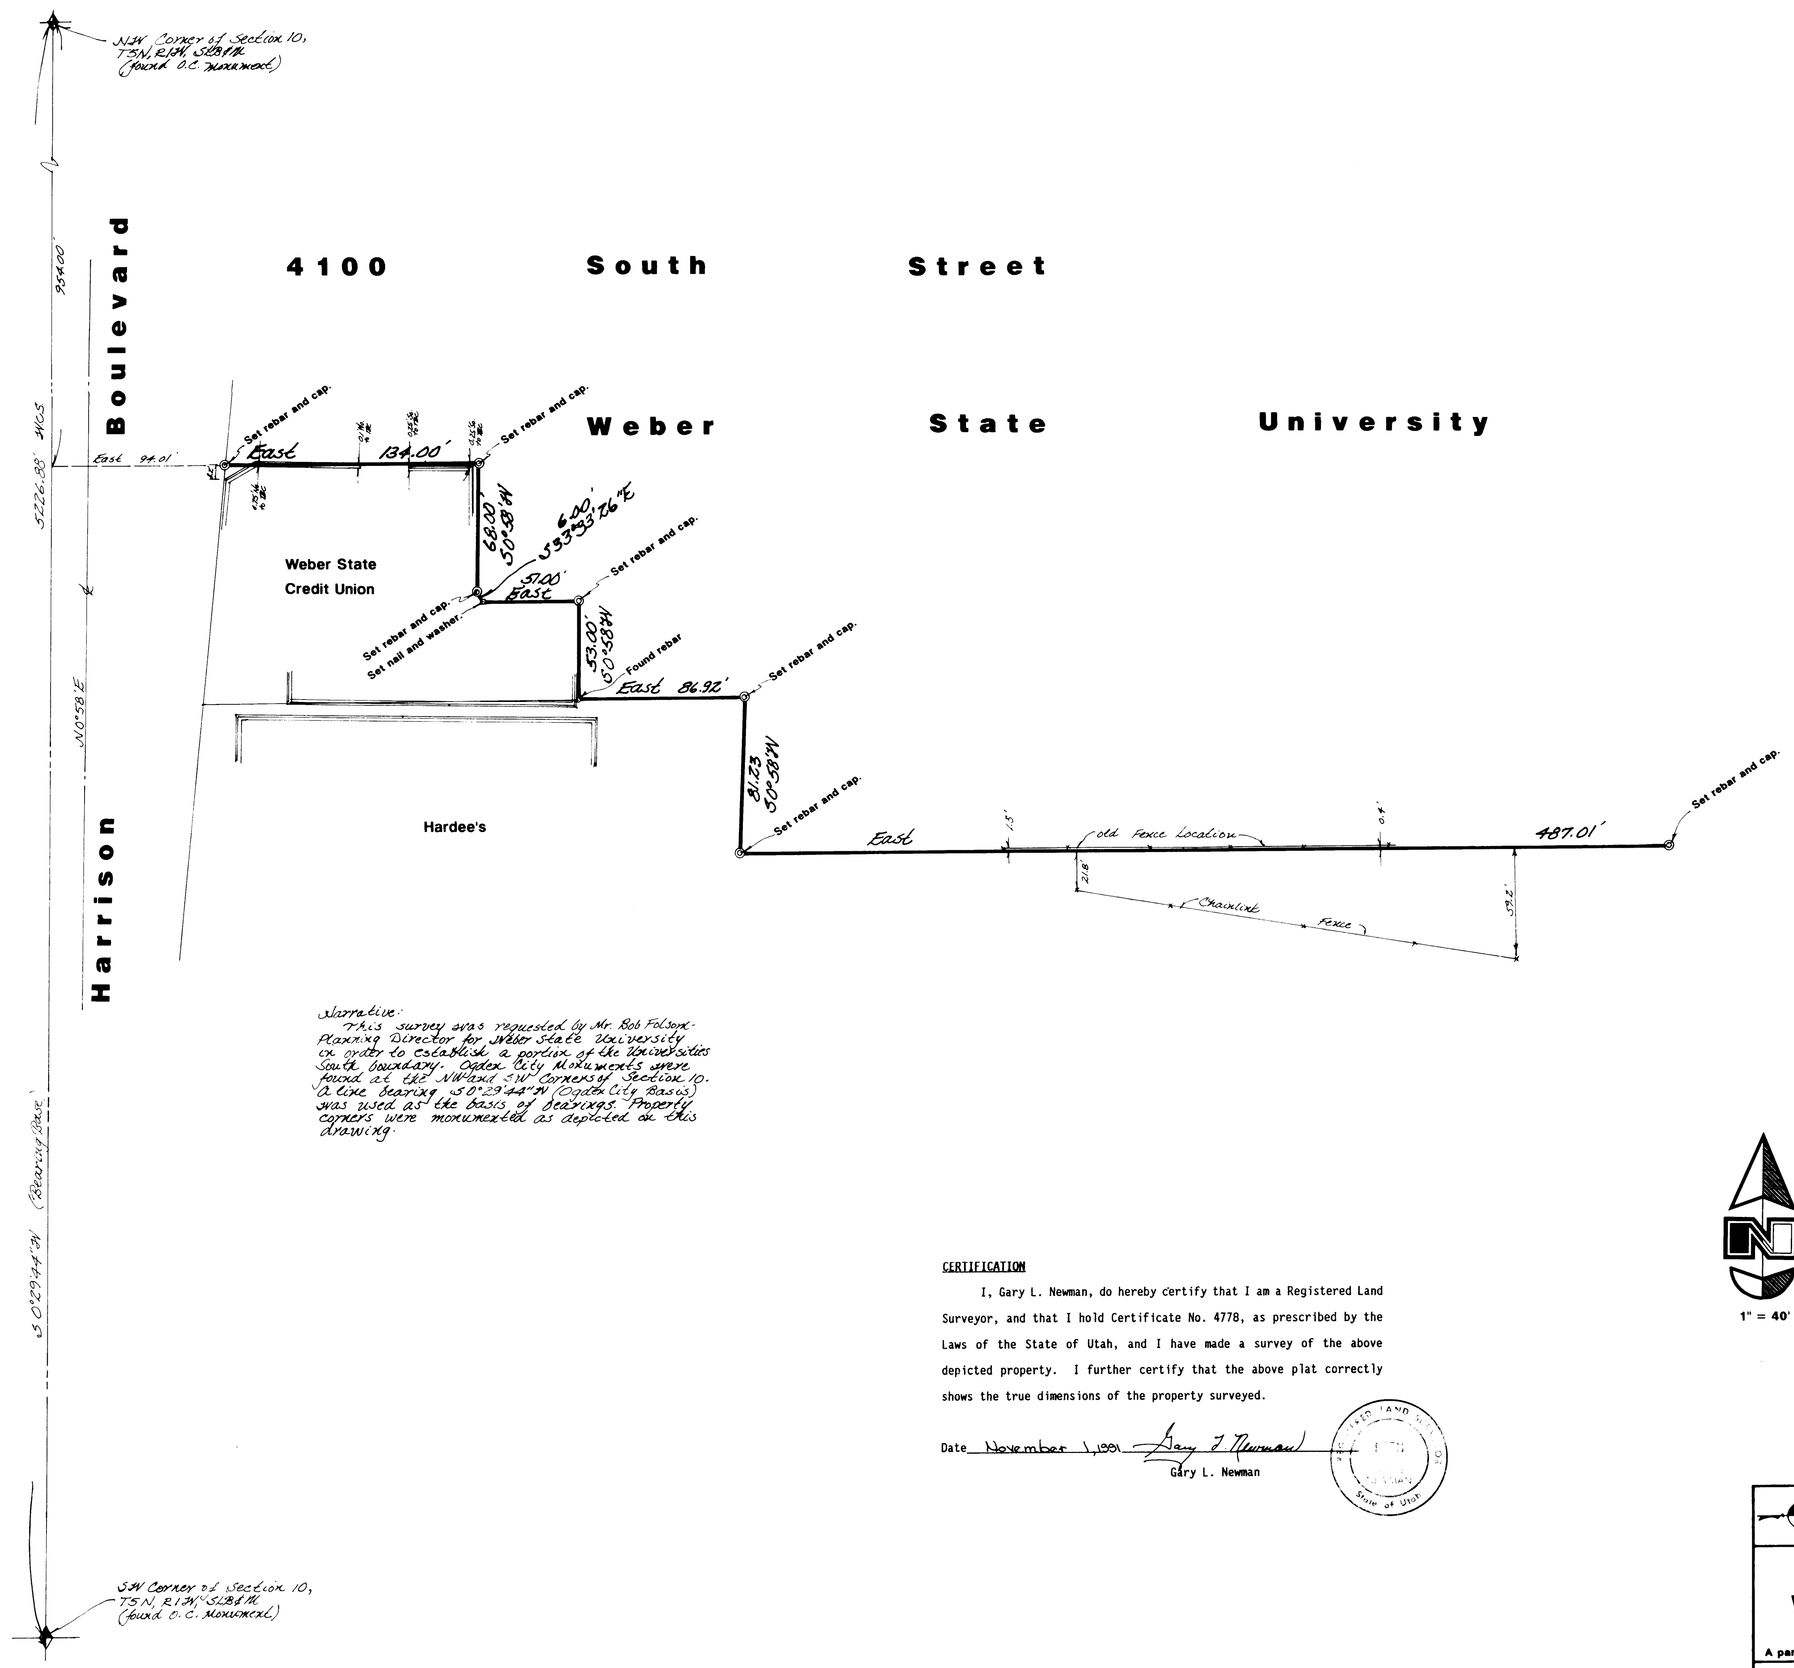

Narrative:
This survey was requested by Mr. Bob Folsom - Planning Director for Weber State University in order to establish a portion of the University's South boundary. Ogden City Monuments were found at the N.W. and S.W. Corners of Section 10. A line bearing S 0°29'44"W (Ogden City Basis) was used as the basis of bearings. Property corners were monumented as depicted on this drawing.

CERTIFICATION

I, Gary L. Newman, do hereby certify that I am a Registered Land Surveyor, and that I hold Certificate No. 4778, as prescribed by the Laws of the State of Utah, and I have made a survey of the above depicted property. I further certify that the above plat correctly shows the true dimensions of the property surveyed.

Date November 1, 1991 Gary L. Newman
Gary L. Newman

RECEIVED
OCT 21 1992
Weber County Surveyor

GREAT BASIN ENGINEERING, INC.
CONSULTING ENGINEERS & SURVEYORS
OGDEN & SALT LAKE CITY, UTAH

Property Survey for Weber State University
Ogden City, Weber County, Utah
A part of the North 1/2 of Section 10, T5N, R2W, SLB&M, U.S. Survey

DRAWN	CHECKED	APPROVED
CAO		
DATE	SCALE	DWG NO.
28 October 1991	1" = 40'	PS-91-56

DRAWING NUMBER 000775
PLAN HOLD CORPORATION • IRVINE, CALIFORNIA
REORDER BY NUMBER 017540
POSITIVE USE OF PAPER ON FILM
DRAWING NUMBER 000775
PLAN HOLD CORPORATION • IRVINE, CALIFORNIA
REORDER BY NUMBER 017540
POSITIVE USE OF PAPER ON FILM
