


Description
All of Lot 88, Bona Hills Subdivision, Ogden City, Weber County, Utah according to the official plat thereof.

Certification
I, Gary L. Newman, do hereby certify that I am a Registered Land Surveyor, and that I hold Certificate No. 4778, as prescribed by the Laws of the State of Utah, and I have made a survey of the above described property. I further certify that the above plat correctly shows the true dimensions of the property surveyed.

DATE: 11/13/91
GARY L. NEWMAN
Gary L. Newman

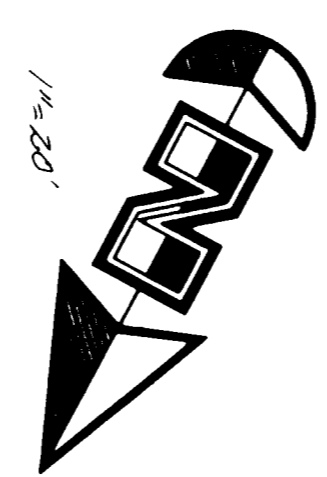

Narrative
This Survey was requested by Mr. Greg King from Woodside Homes in order to establish property boundaries for construction of a new home. Nails were found at the intersection of Lakeview Drive and Ross Drive, Ross Drive and Bona Villa Drive and the knuckle of Bona Villa Drive. The calculated angle between these three nails does not check, so the nail at the knuckle of Bona Villa Drive and the nail at the intersection of Bona Villa Drive and Ross Drive was used as the basis of bearings, because it checked the existing improvements and a 2" diameter pipe found at the Northwest Corner of Lot 88. Lot 88 was monumented as depicted on this Drawing.

GREAT BASIN ENGINEERING, INC.
CONSULTING ENGINEERS & SURVEYORS
OGDEN & SALT LAKE CITY, UTAH

Property Survey for
Woodside Corp.
Lot 88, Bona Hills Subdivision
Ogden City, Weber County, Utah
Part of Sub. No. 114 of Section 18, T4N, R17W, S44E, U.S. Survey

DATE: 10 October 1991
SCALE: 1" = 20'
DRAWN BY: [Signature]
CHECKED BY: [Signature]

RECEIVED
OCT 21 1992
Weber County Surveyor