




CERTIFICATION

I, Gary L. Newman, do hereby certify that I am a Registered Land
Surveyor, and that I hold Certificate No. 4778, as prescribed by the
Laws of the State of Utah, and I have made a survey of the above
depicted property. I further certify that the above plat correctly
shows the true dimensions of the property surveyed.

Date: 11-1-91

Gary L. Newman

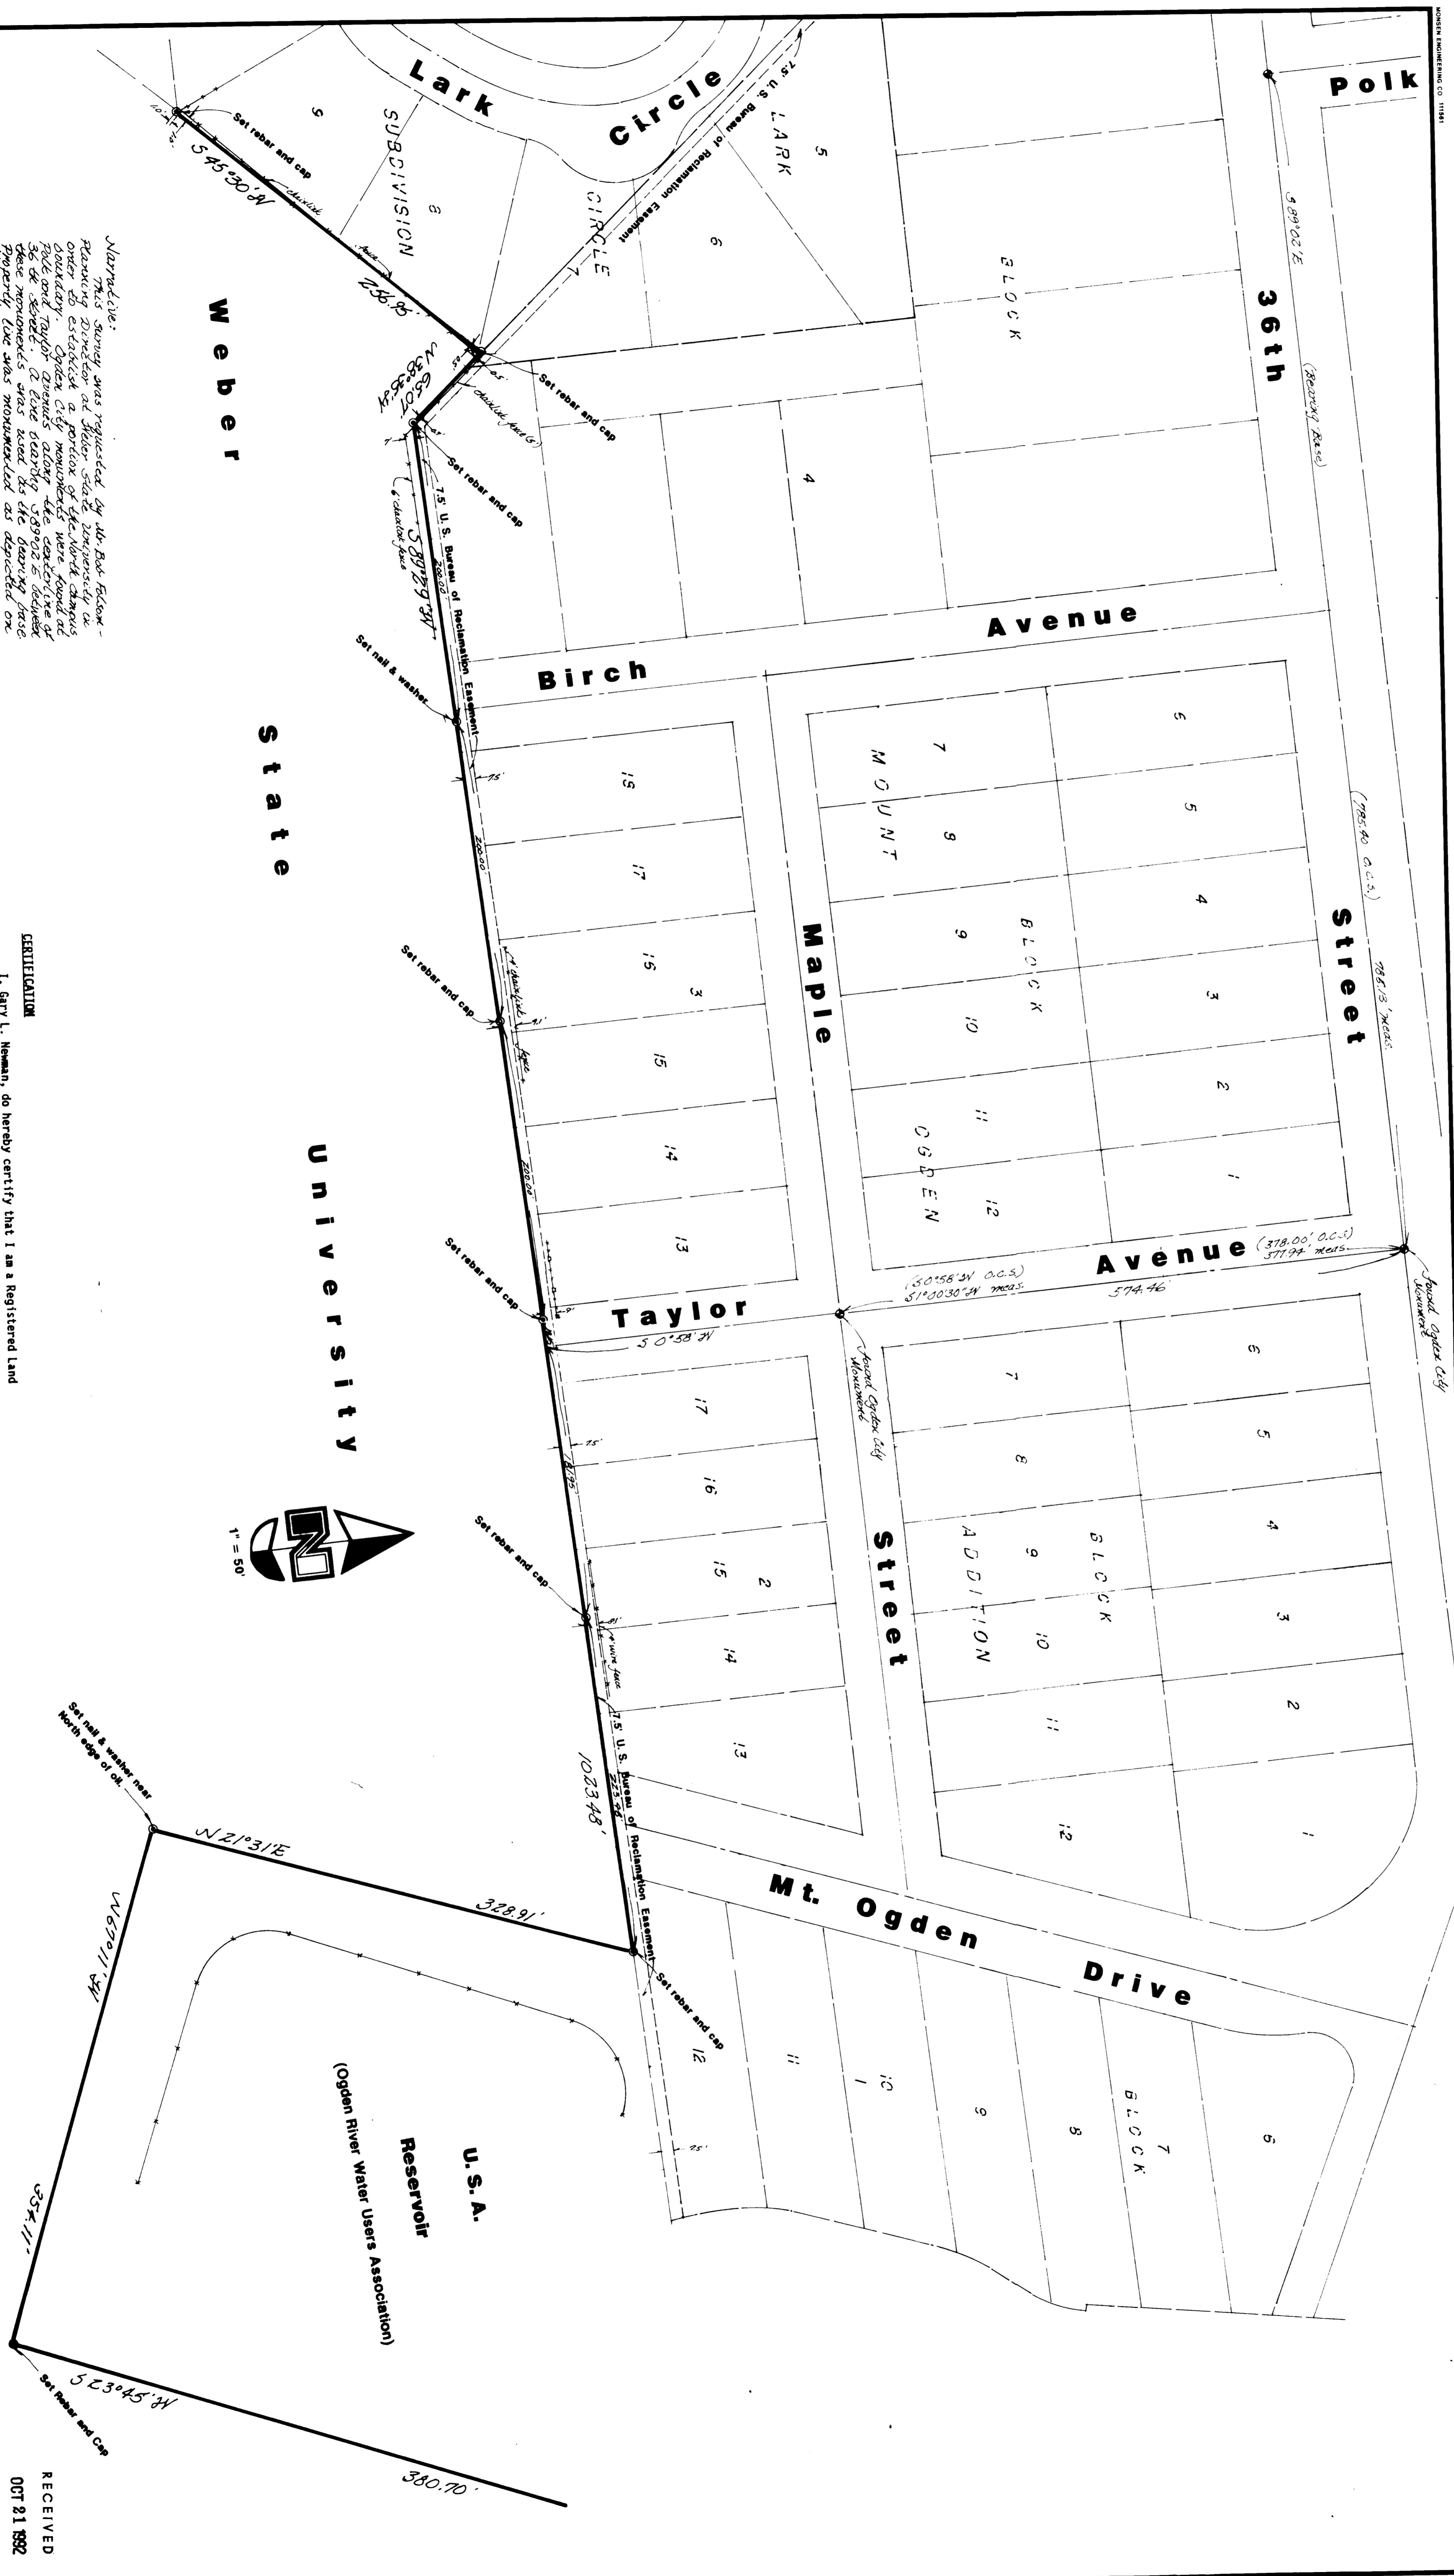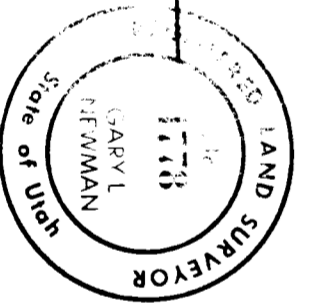

RECEIVED
Weber County Surveyor

GREAT BASIN ENGINEERING, INC.
CONSULTING ENGINEERS & SURVEYORS
OGDEN & SALT LAKE CITY, UTAH

Property Survey
for
Weber State University
Ogden City, Weber County, Utah

10 September, 1991 1" = 50'

11778
UTAH
LAND
SURVEYOR
GARY L. NEWMAN
STATE OF UTAH

10 September, 1991 1" = 50'