RECORD OF SURVEY

PART OF LOTS 39, 40, AND 41, BLOCK 40, LAKEVIEW ADDITION

BEING PART OF THE SOUTHEAST QUARTER OF SECTION 5, TOWNSHIP 5 NORTH, RANGE 1 WEST, SALT LAKE BASE & MERIDIAN, U.S. SURVEY SOUTH OGDEN CITY, WEBER COUNTY, UTAH

JANUARY, 2024

VICINITY MAP NOT TO SCALE

BOULEVARD AND 39TH STREET

(CALC'D, NOT FOUND)

LEGAL DESCRIPTION

ALL OF LOTS 39 AND 40, AND THE SOUTH 11 FEET OF LOT 41, BLOCK 40, LAKEVIEW ADDITION, SOUTH OGDEN CITY, WEBER COUNTY, UTAH, ACCORDING TO THE OFFICIAL PLAT THEREOF.

NARRATIVE

THIS SURVEY WAS REQUESTED BY ALLAN KARRAS FOR THE PURPOSE OF RE-ESTABLISHING THE BOUNDARY OF THE HEREON DESCRIBED PARCEL OF LAND.

BRASS CAP MONUMENTS WERE FOUND FOR CENTERLINE MONUMENTS IN THE INTERSECTION OF WASHINGTON BOULEVARD AND 38TH STREET; THE INTERSECTION OF OGDEN AVENUE AND 38TH STREET; THE INTERSECTION OF OGDEN AVENUE AND 39TH STREET; AND THE INTERSECTION OF WASHINGTON BOULEVARD AND 39TH

A LINE BEARING SOUTH 00°58'00" WEST BETWEEN SAID MONUMENTS IN THE INTERSECTION OF WASHINGTON BOULEVARD AND 38TH STREET AND THE INTERSECTION OF WASHINGTON BOULEVARD AND 39TH STREET WAS USED AS THE BASIS OF BEARINGS FOR THIS SURVEY.

A SURVEY PREPARED BY BINGHAM ENGINEERING, DATED MARCH 19, 2021, AND RECORDED MARCH 28, 2001, AS ENTRY #2679; AND A SUBDIVISION PLAT FOR LAKEVIEW ADDITION AS RECORDED IN THE WEBER COUNTY RECORDER'S OFFICE WAS USED AS REFERENCE FOR THIS SURVEY.

THE EAST LINE OF SUBJECT PARCEL WAS DETERMINED BY THE WEST RIGHT OF THESE DISCREPANCIES.

I, <u>Jason felt</u>, do hereby certify that I am a professional land surveyor IN THE STATE OF UTAH IN ACCORDANCE WITH TITLE 58, CHAPTER 22, PROFESSIONAL ENGINEERS AND PROFESSIONAL LAND SURVEYORS ACT; AND THAT I HAVE COMPLETED A SURVEY OF THE PROPERTY DESCRIBED ON THIS PLAT IN ACCORDANCE WITH SECTION 17-23-17 AND HAVE VERIFIED ALL MEASUREMENTS, AND HAVE PLACED MONUMENTS AS REPRESENTED ON THIS PLAT. I FURTHER CERTIFY THAT THIS PLAT IS A CORRECT REPRESENTATION OF THE LAND SURVEYED AND HAS BEEN PREPARED IN CONFORMITY WITH THE MINIMUM STANDARDS AND REQUIREMENTS OF THE LAW.

SIGNED THIS 6th DAY OF MARCH, 20 24.

9239283 UTAH LICENSE NUMBER





SOCIAL

RECORD
PART OF LOTS 39, 40

0 (5

0


Project Info.

Designer:

A. MULLINS Begin Date: 1-4-2024 Name: KARRAS

RECORD OF SURVEY 1"=10' Scale: ____ Checked: _ Number: 1714-50

Sheet Sheets

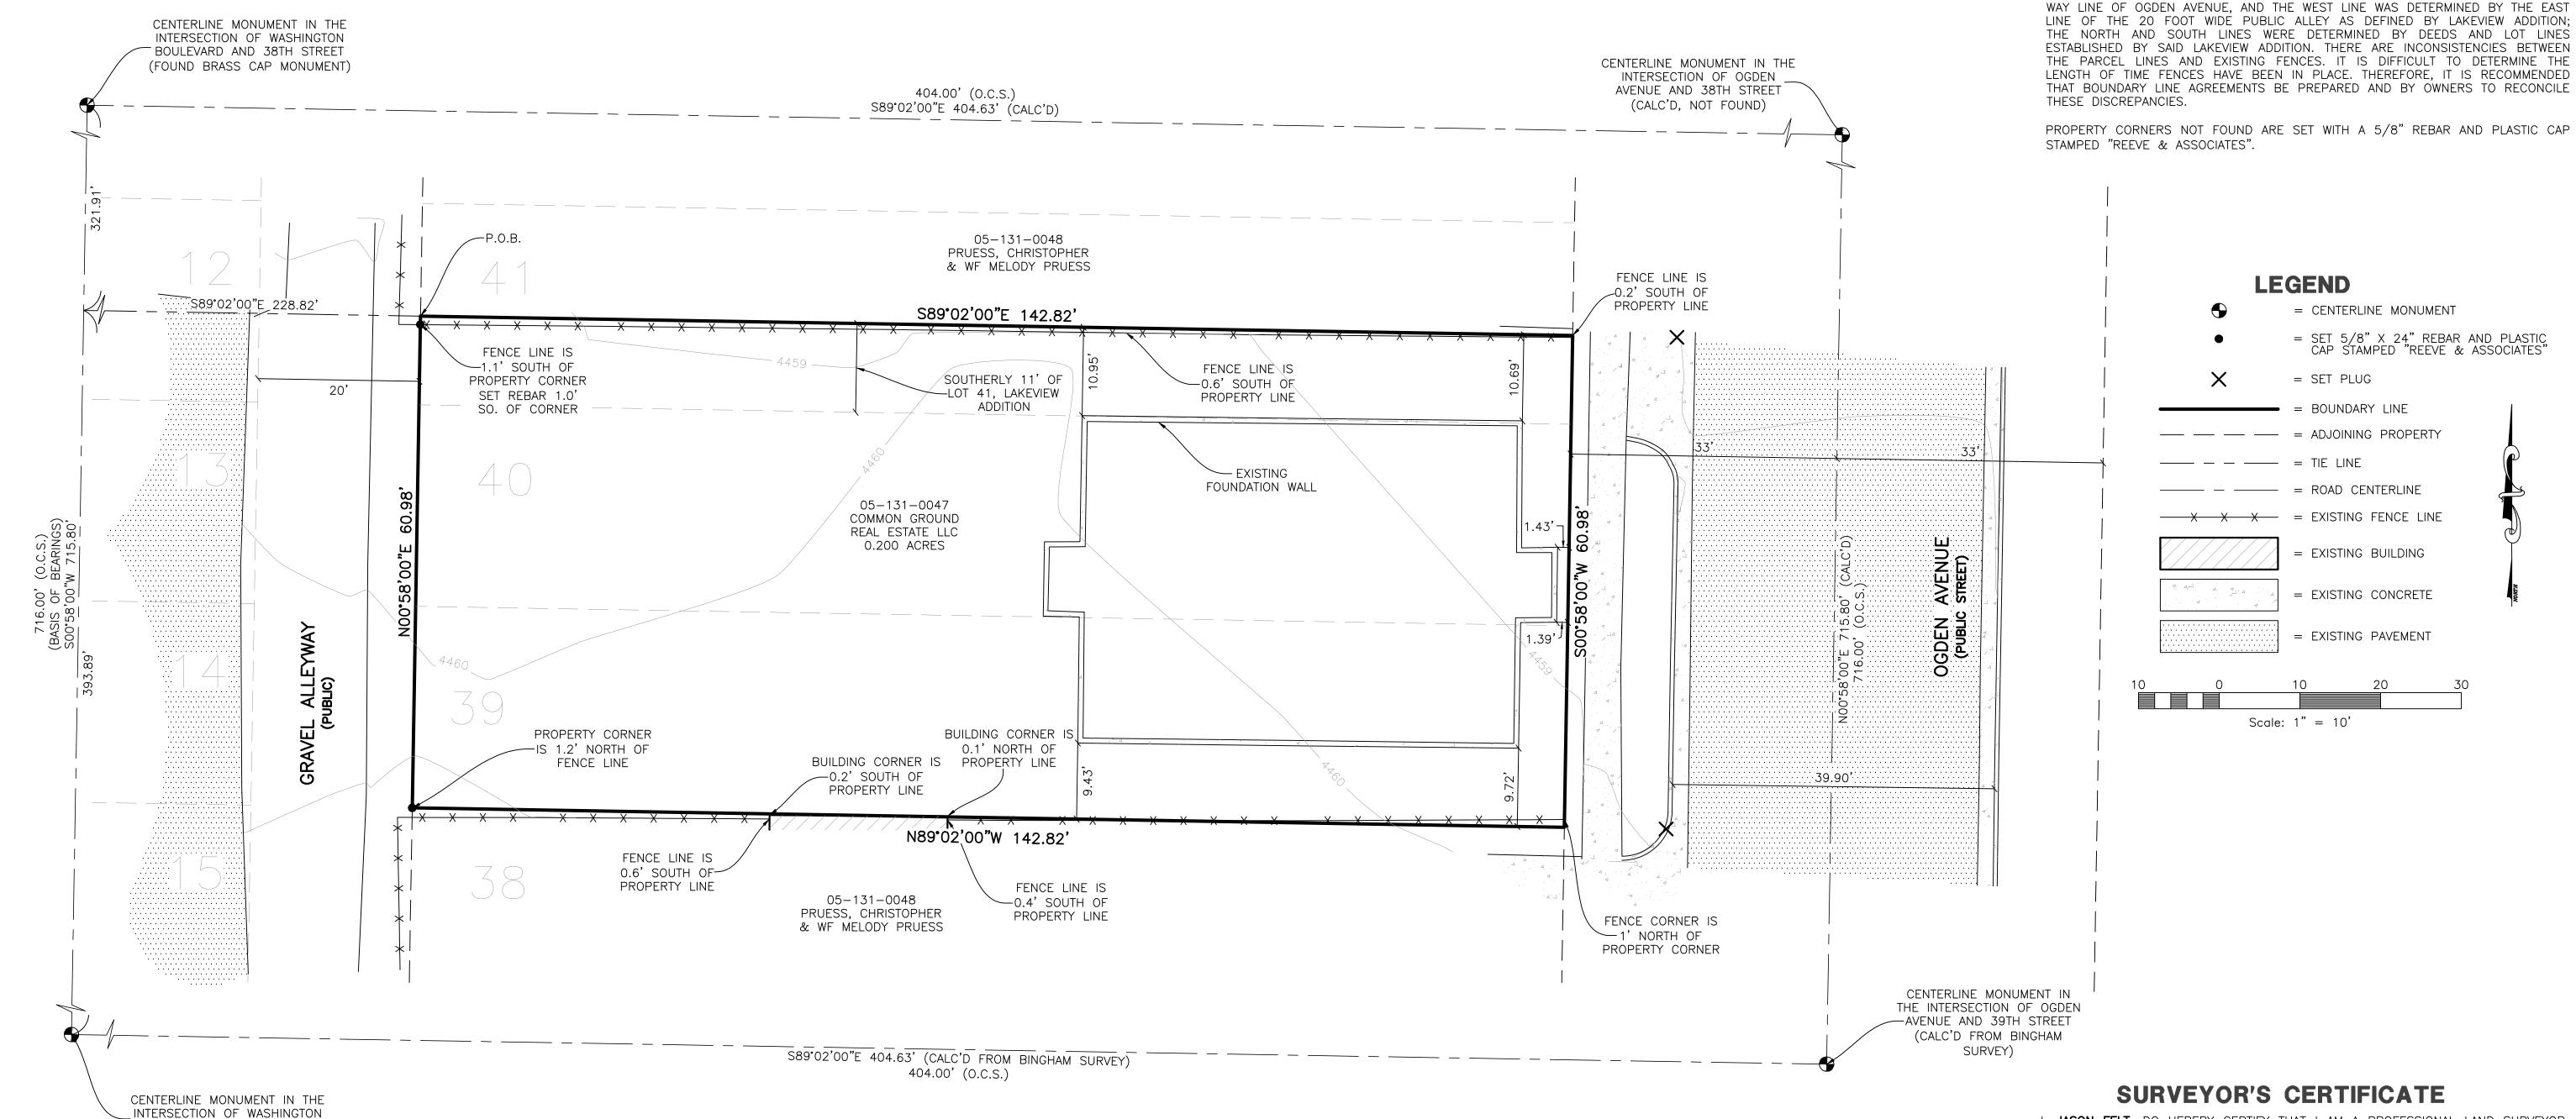

FILE # 7790

Reeve & Associates, Inc. - Solutions You Can Build On