

DRAWING NUMBER
000794

DRAWING NUMBER
000794

DRAWING NUMBER
000794


DRAWING NUMBER
000794

LAN HOLD CORPORATION RV NE C L ORN
REORD Y N U M B

LAN HOLD CORPORATION RV NE C L ORN
E O D R Y N U M B

LAN HOLD CORPORATION RV NE C L ORN
REORD Y N U M B

LAN HOLD CORPORATION RV NE C L ORN
E O D R Y N U M B

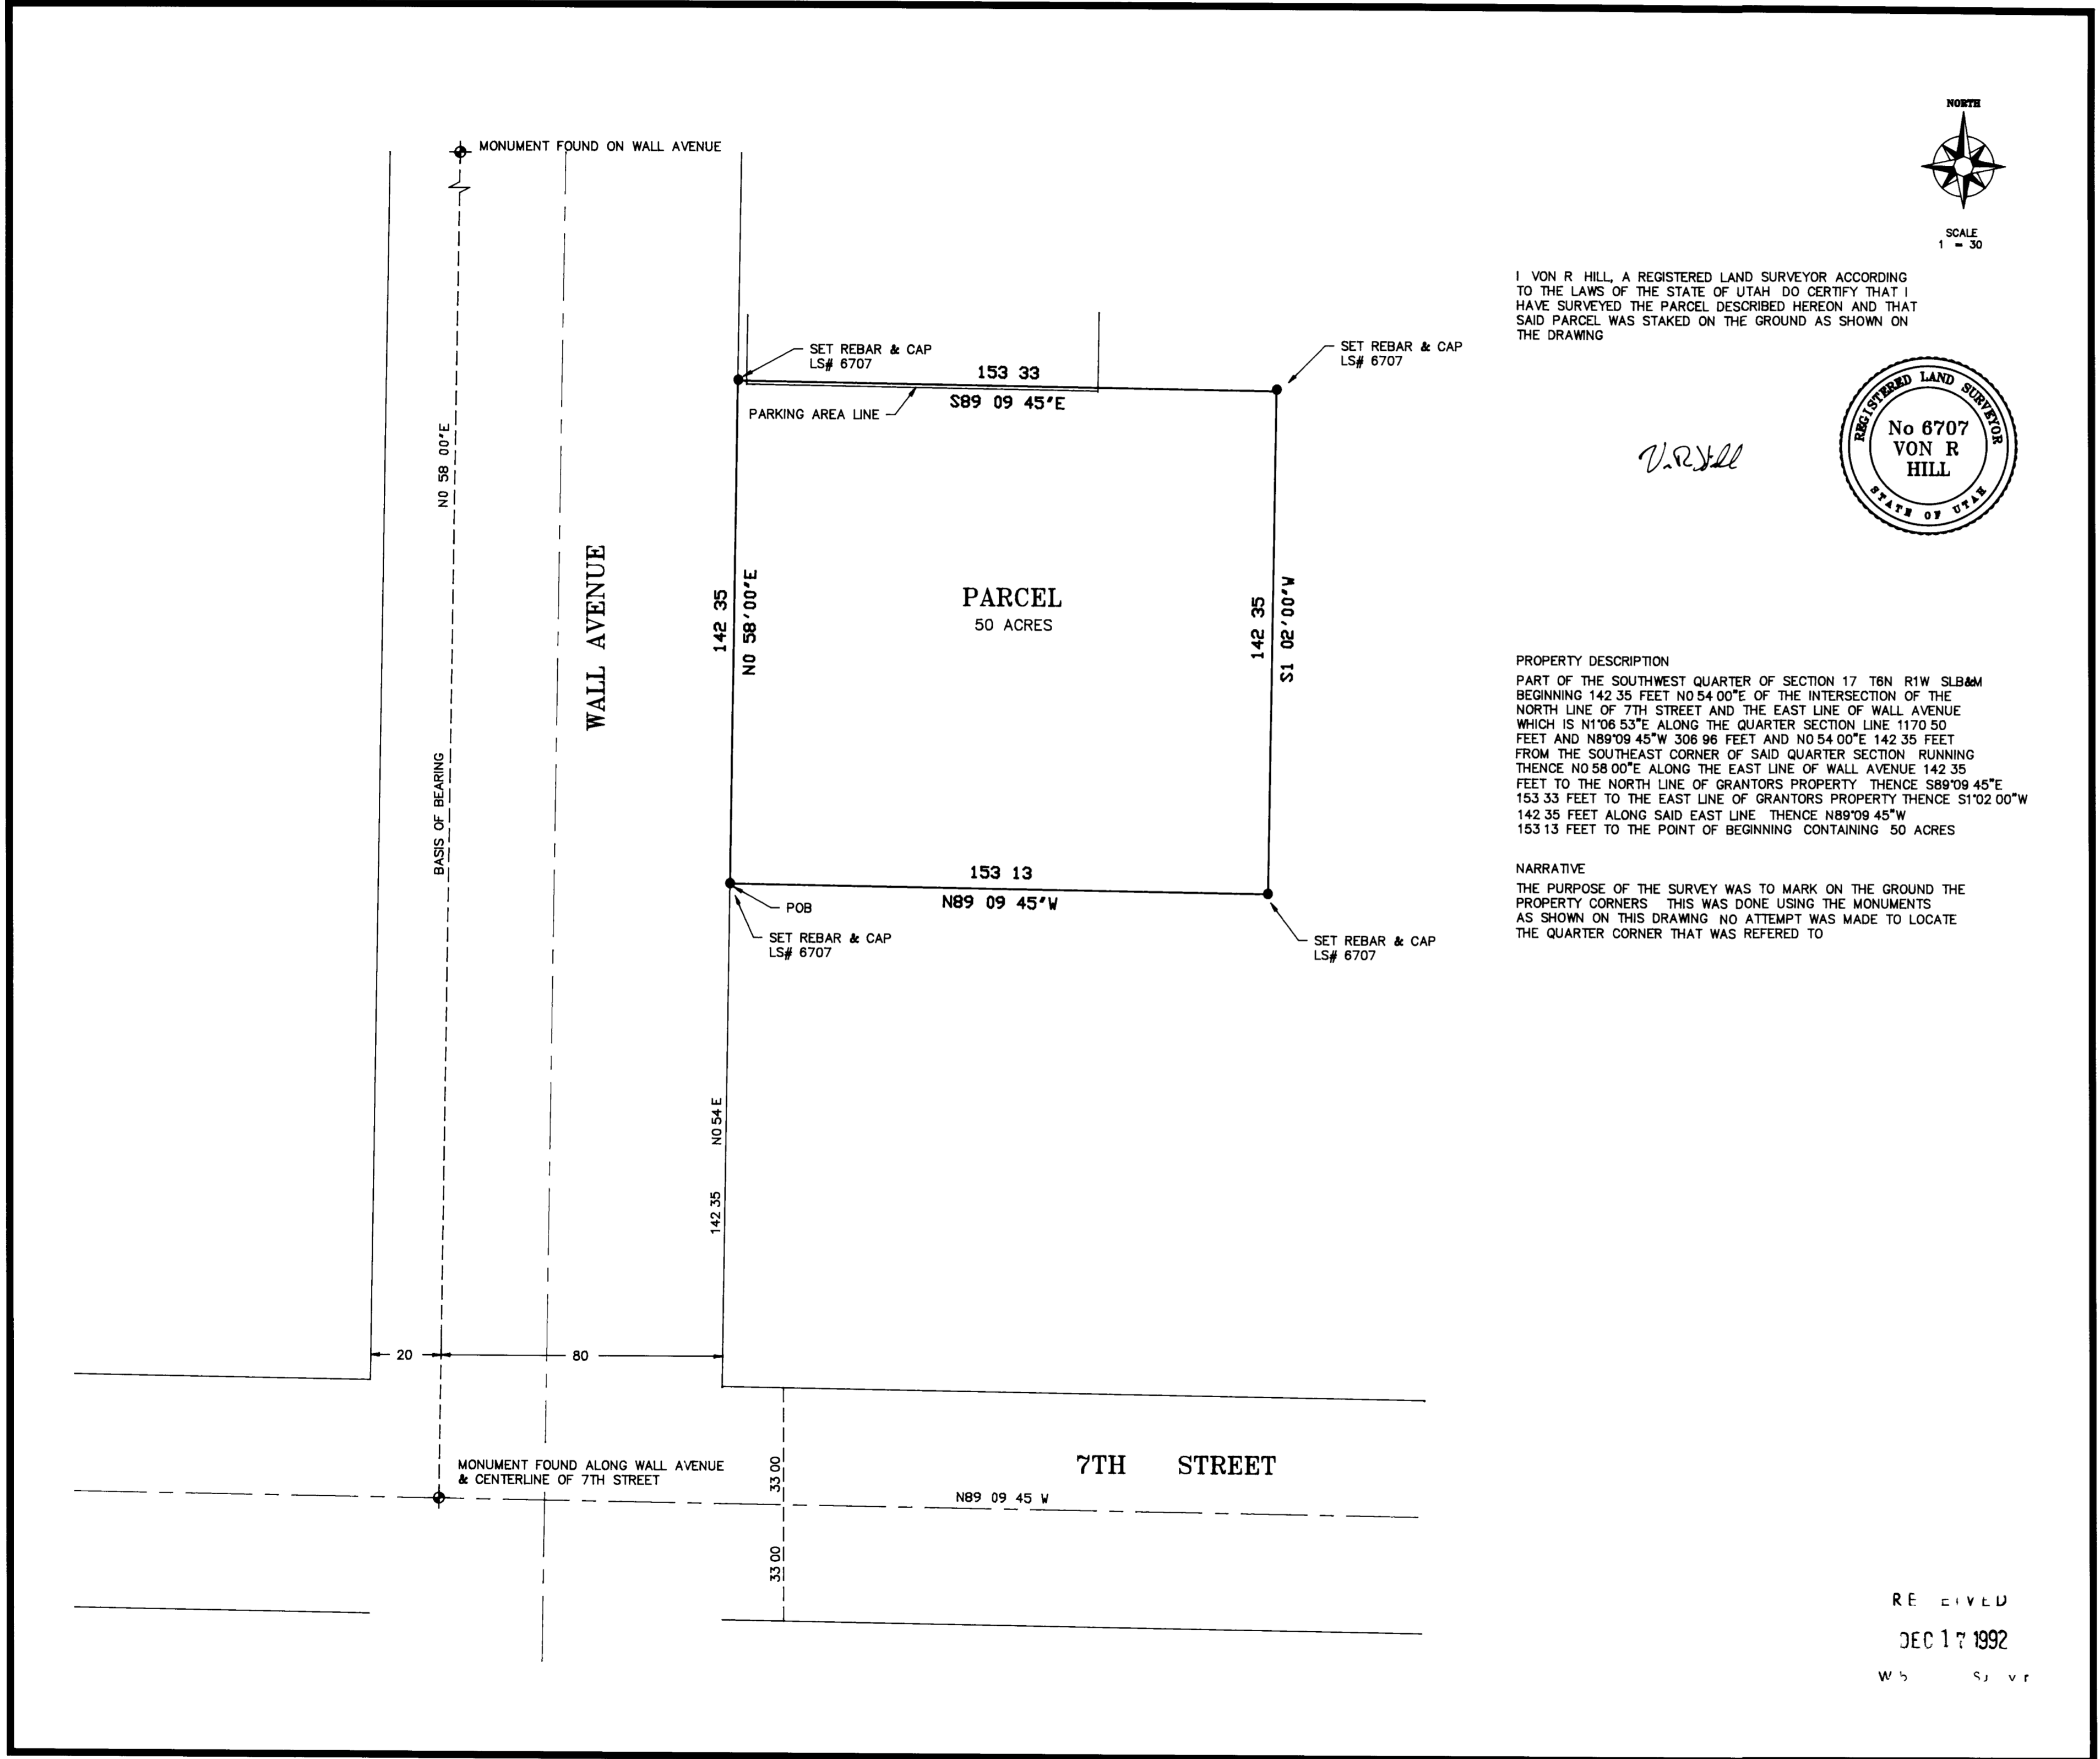

I VON R HILL, A REGISTERED LAND SURVEYOR ACCORDING TO THE LAWS OF THE STATE OF UTAH DO CERTIFY THAT I HAVE SURVEYED THE PARCEL DESCRIBED HEREON AND THAT SAID PARCEL WAS STAKED ON THE GROUND AS SHOWN ON THE DRAWING

V.R. Hill



PROPERTY DESCRIPTION
PART OF THE SOUTHWEST QUARTER OF SECTION 17 T8N R1W SLB&M BEGINNING 142.35 FEET NO 54°00'E OF THE INTERSECTION OF THE NORTH LINE OF 7TH STREET AND THE EAST LINE OF WALL AVENUE WHICH IS N1°06'53"E ALONG THE QUARTER SECTION LINE 1170.50 FEET AND N89°09'45"W 306.96 FEET AND NO 54°00'E 142.35 FEET FROM THE SOUTHEAST CORNER OF SAID QUARTER SECTION RUNNING THENCE NO 58°00'E ALONG THE EAST LINE OF WALL AVENUE 142.35 FEET TO THE NORTH LINE OF GRANTORS PROPERTY THENCE S89°09'45"E 153.33 FEET TO THE EAST LINE OF GRANTORS PROPERTY THENCE S1°02'00"W 142.35 FEET ALONG SAID EAST LINE THENCE N89°09'45"W 153.13 FEET TO THE POINT OF BEGINNING CONTAINING 50 ACRES

NARRATIVE
THE PURPOSE OF THE SURVEY WAS TO MARK ON THE GROUND THE PROPERTY CORNERS THIS WAS DONE USING THE MONUMENTS AS SHOWN ON THIS DRAWING NO ATTEMPT WAS MADE TO LOCATE THE QUARTER CORNER THAT WAS REFERRED TO

RECEIVED
DEC 17 1992
W S S J V R

Hill, Jamison and Associates, Inc.
Engineering and Surveying
146 West 300 South Bountiful Utah 84010 (801)298-2236

SURVEY REQUESTED BY
TIM MAYCOCK
LOCATED IN THE SW 1/4 OF SECTION 17
T8N R1W SLB&M

DATE RNR DATE 4/24/92
APPROVED VRH DATE 4/24/92
REVISED AVE

SHEET
OF
FILE NO