DRAWING NUMBER
000798
PLAN HOLD CORPORATION • IRVINE, CALIFORNIA
RECORDER BY NUMBER 07-SAP

DRAWING NUMBER
000798
PLAN HOLD CORPORATION • IRVINE, CALIFORNIA
RECORDER BY NUMBER 07-SAP

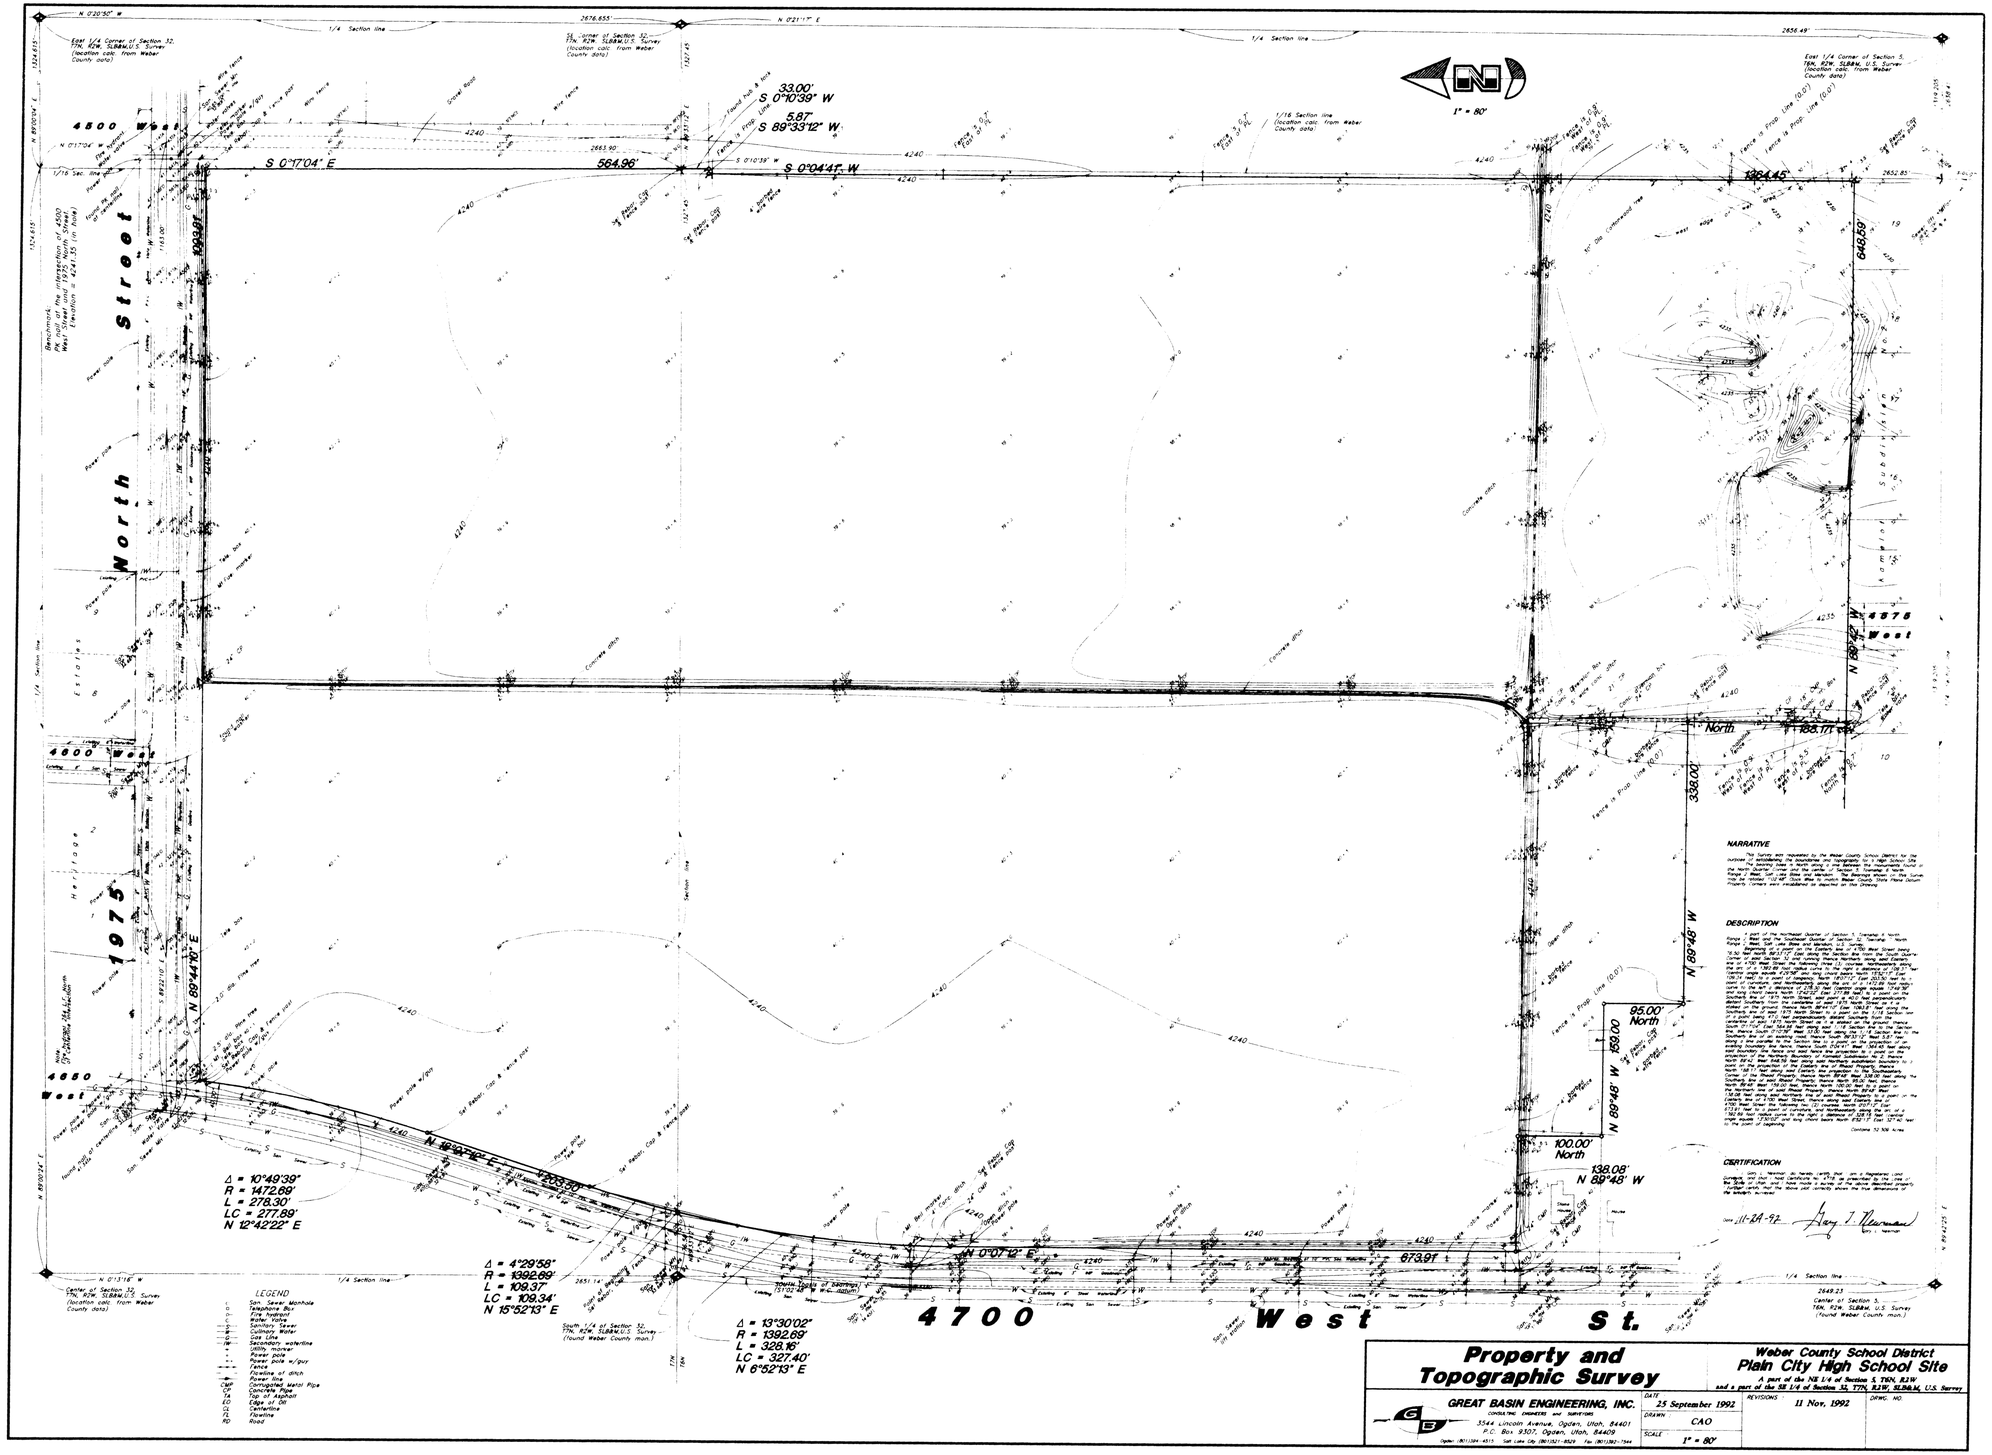

RECEIVED
DEC 22 1992
Weber County Surveyor