


MONUMENTED CENTERLINE DESCRIPTION

A PART OF THE SOUTHWEST QUARTER OF SECTION 6, TOWNSHIP 5 NORTH, RANGE 2 WEST, OF THE SALT LAKE BASE AND MERIDIAN. BEGINNING AT THE CENTERLINE OF 3700 SOUTH STREET BEING LOCATED SOUTH 01°47'17" WEST 841.39 FEET ALONG THE EAST LINE OF SAID SOUTHWEST QUARTER AND NORTH 90°00'00" WEST 469.85 FEET FROM THE CENTER QUARTER CORNER OF SAID SECTION 6; RUNNING THENCE ALONG THE CENTERLINE OF 3700 SOUTH THE FOLLOWING TWO (2) COURSES: (1) NORTH 87°32'07" WEST 214.28 FEET; (2) NORTH 89°09'24" WEST 429.01 FEET TO THE INTERSECTION OF THE CENTERLINE OF 5650 WEST STREET; THENCE ALONG THE CENTERLINE OF SAID 5650 WEST STREET SOUTH 01°10'06" WEST 310.43 FEET TO THE POINT OF TERMINATION.

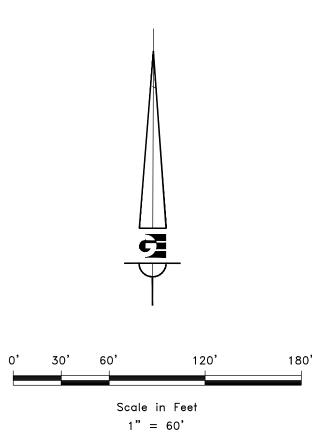

LEGEND

◆ WEBER COUNTY MONUMENT AS NOTED O SET 24" REBAR AND CAP MARKED GARDNER ENGINEERING CENTERLINE MONUMENT SUBJECT PROPERTY BOUNDARY LOT LINE — ADJACENT PARCEL ----- SECTION LINE ---- EASEMENT —X——— EXISTING FENCE LINE SURVEYED CENTERLINE

NARRATIVE

THE PURPOSE OF THIS SURVEY WAS TO ESTABLISH AND SET THE CENTERLINE MONUMENTS WITHIN THE ALEMORA ESTATES SUBDIVISION AS SHOWN AND DESCRIBED HEREON. THE SURVEY WAS ORDERED BY WOODMERE HOMES. THE BASIS OF BEARING IS THE EAST LINE OF THE SOUTHWEST QUARTER OF SECTION 6, TOWNSHIP 5 NORTH, RANGE 1 WEST WHICH BEARS SOUTH 01°47'19" WEST, WEBER COUNTY, UTAH NORTH, NAD 83 STATE PLANE GRID BEARING. THE CENTERLINE WAS DETERMINED THE DEDICATED PLAT OF ALEMORA ESTATES SUBDIVISION ALONG WITH THE FOUND MONUMENTS AS SHOWN AND DESCRIBED HEREON.

SURVEYOR'S CERTIFICATE

I, KLINT H. WHITNEY, DO HEREBY CERTIFY THAT I AM A LICENSED PROFESSIONAL LAND SURVEYOR IN THE STATE OF UTAH AND THAT I HOLD CERTIFICATE NO. 8227228 IN ACCORDANCE WITH TITLE 58, CHAPTER 22, OF THE PROFESSIONAL ENGINEERS AND LAND SURVEYORS ACT; I FURTHER CERTIFY THAT BY AUTHORITY OF THE OWNERS I HAVE COMPLETED A SURVEY OF THE PROPERTY DESCRIBED ON THIS RECORD OF SURVEY PLAT IN ACCORDANCE WITH SECTION 17-23-20 AND HAVE VERIFIED ALL MEASUREMENTS; THAT THE REFERENCE MONUMENTS SHOWN ON THIS RECORD OF SURVEY PLAT ARE LOCATED AS INDICATED AND ARE SUFFICIENT TO RETRACE OR REESTABLISH THIS SURVEY; AND THAT THE INFORMATION SHOWN HEREIN IS SUFFICIENT TO ACCURATELY ESTABLISH THE LATERAL BOUNDARIES OF THE HEREIN DESCRIBED TRACT OF REAL PROPERTY.

SIGNED THIS 17TH DAY OF APRIL

