
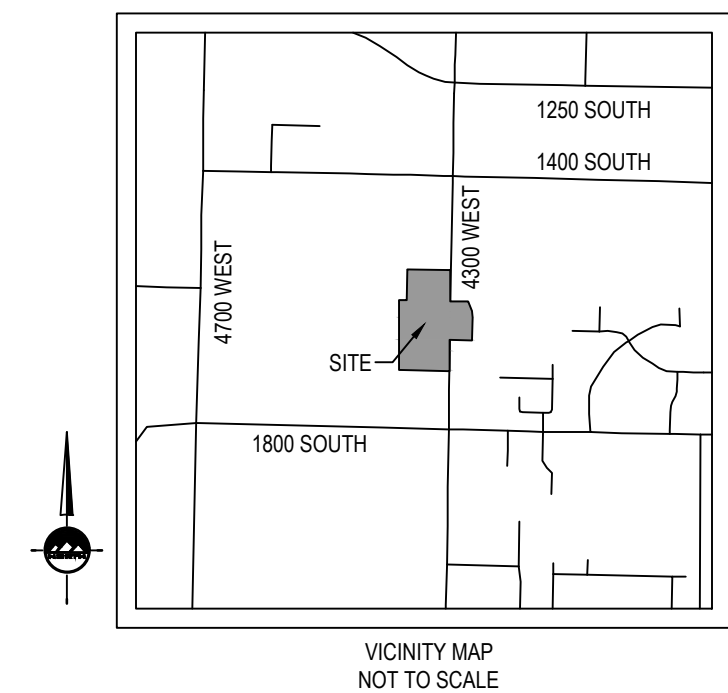


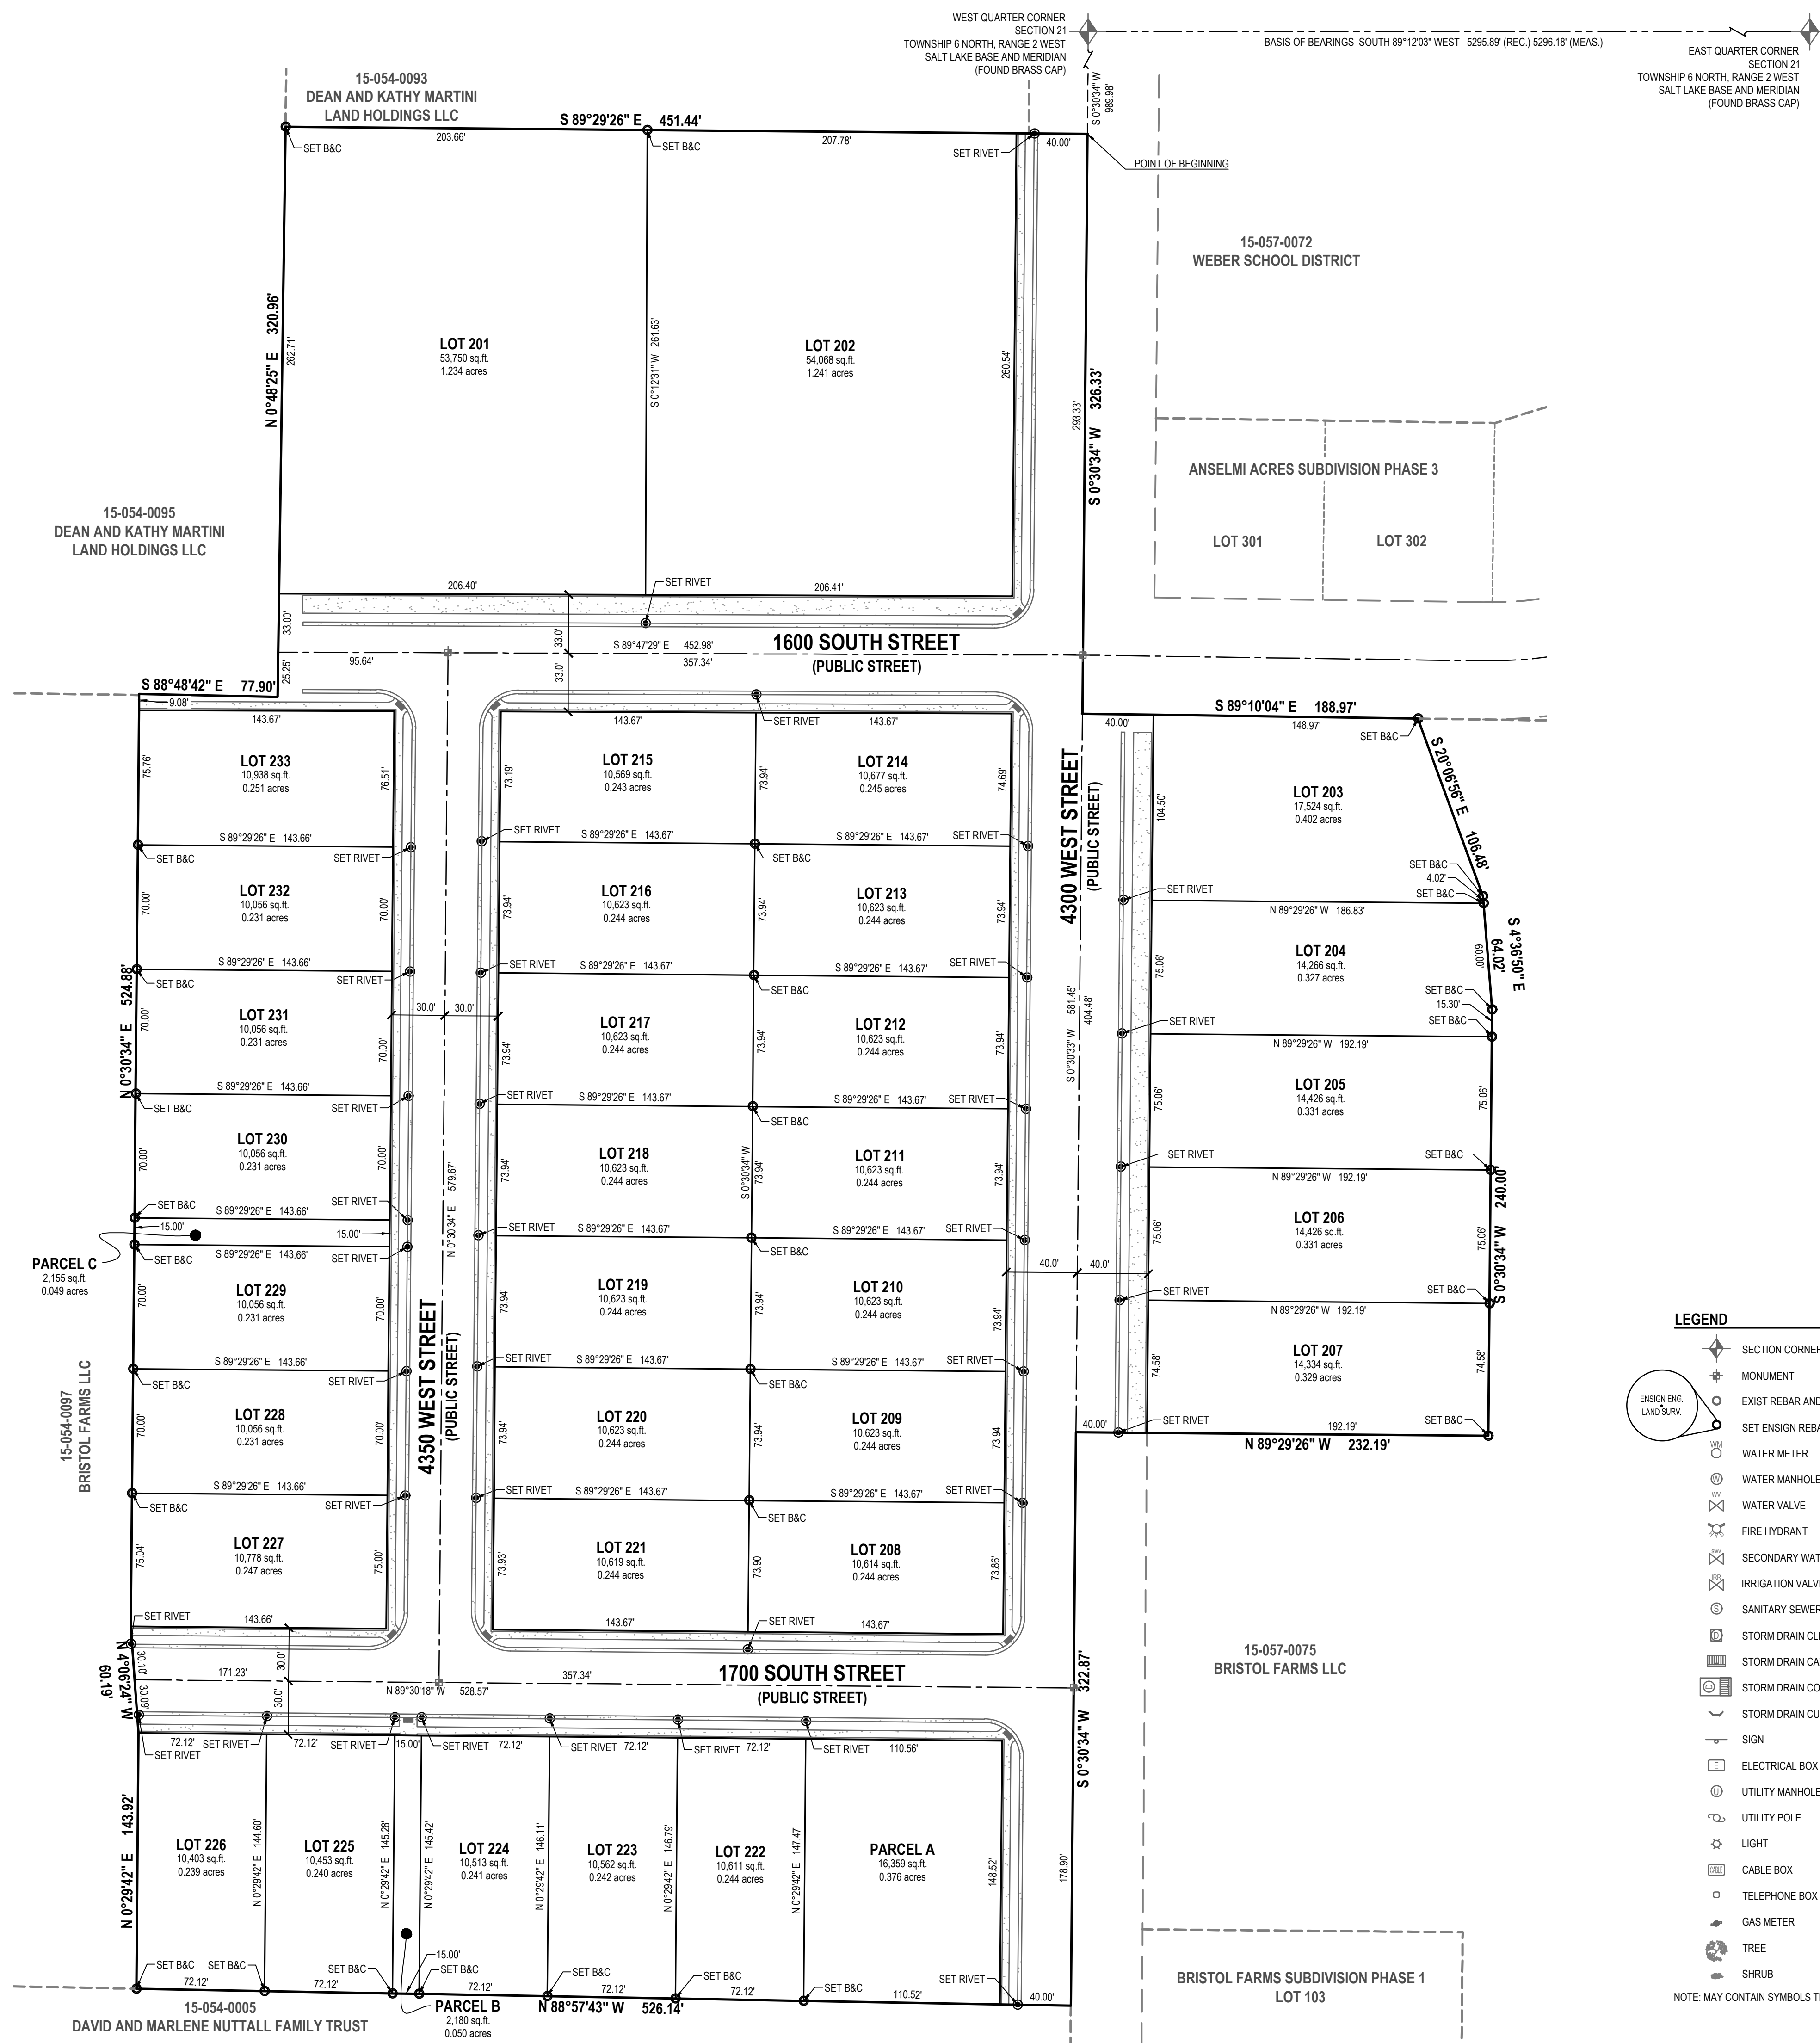

ENSIGN
THE STANDARD IN ENGINEERING

LAYTON
919 North 400 West
Layton, UT 84041
Phone: 801.547.1100

SANDY
Phone: 801.255.0529

TOOELE
Phone: 435.843.3590

CEDAR CITY
Phone: 435.865.1453

RICHFIELD
Phone: 435.896.2983

WWW.ENSIGNENG.COM

FOR:
TRICO CONSTRUCTION
194 WEST 12650 SOUTH
DRAPER, UTAH

CONTACT:
RANDY RIMMER
PHONE: 701-720-4885

BRISTOL FARMS PHASE 2

4300 WEST AND 1600 SOUTH
OGDEN CITY, UTAH

BOUNDARY SURVEY	
PROJECT NUMBER 13421	PRINT DATE 2025-06-17
PROJECT MANAGER T.WILLIAMS	DESIGNED BY A.CASPER
1 OF 1	