

DRAWING NUMBER

000833

PLAN HOLD CORPORATION • IRVINE, CALIFORNIA
REORDER BY NUMBER 075AR

DRAWING NUMBER

000833

PLAN HOLD CORPORATION • IRVINE, CALIFORNIA
REORDER BY NUMBER 075AR

DRAWING NUMBER


000833

PLAN HOLD CORPORATION • IRVINE, CALIFORNIA
REORDER BY NUMBER 075AR

DRAWING NUMBER

000833.

PLAN HOLD CORPORATION • IRVINE, CALIFORNIA
REORDER BY NUMBER 075AR

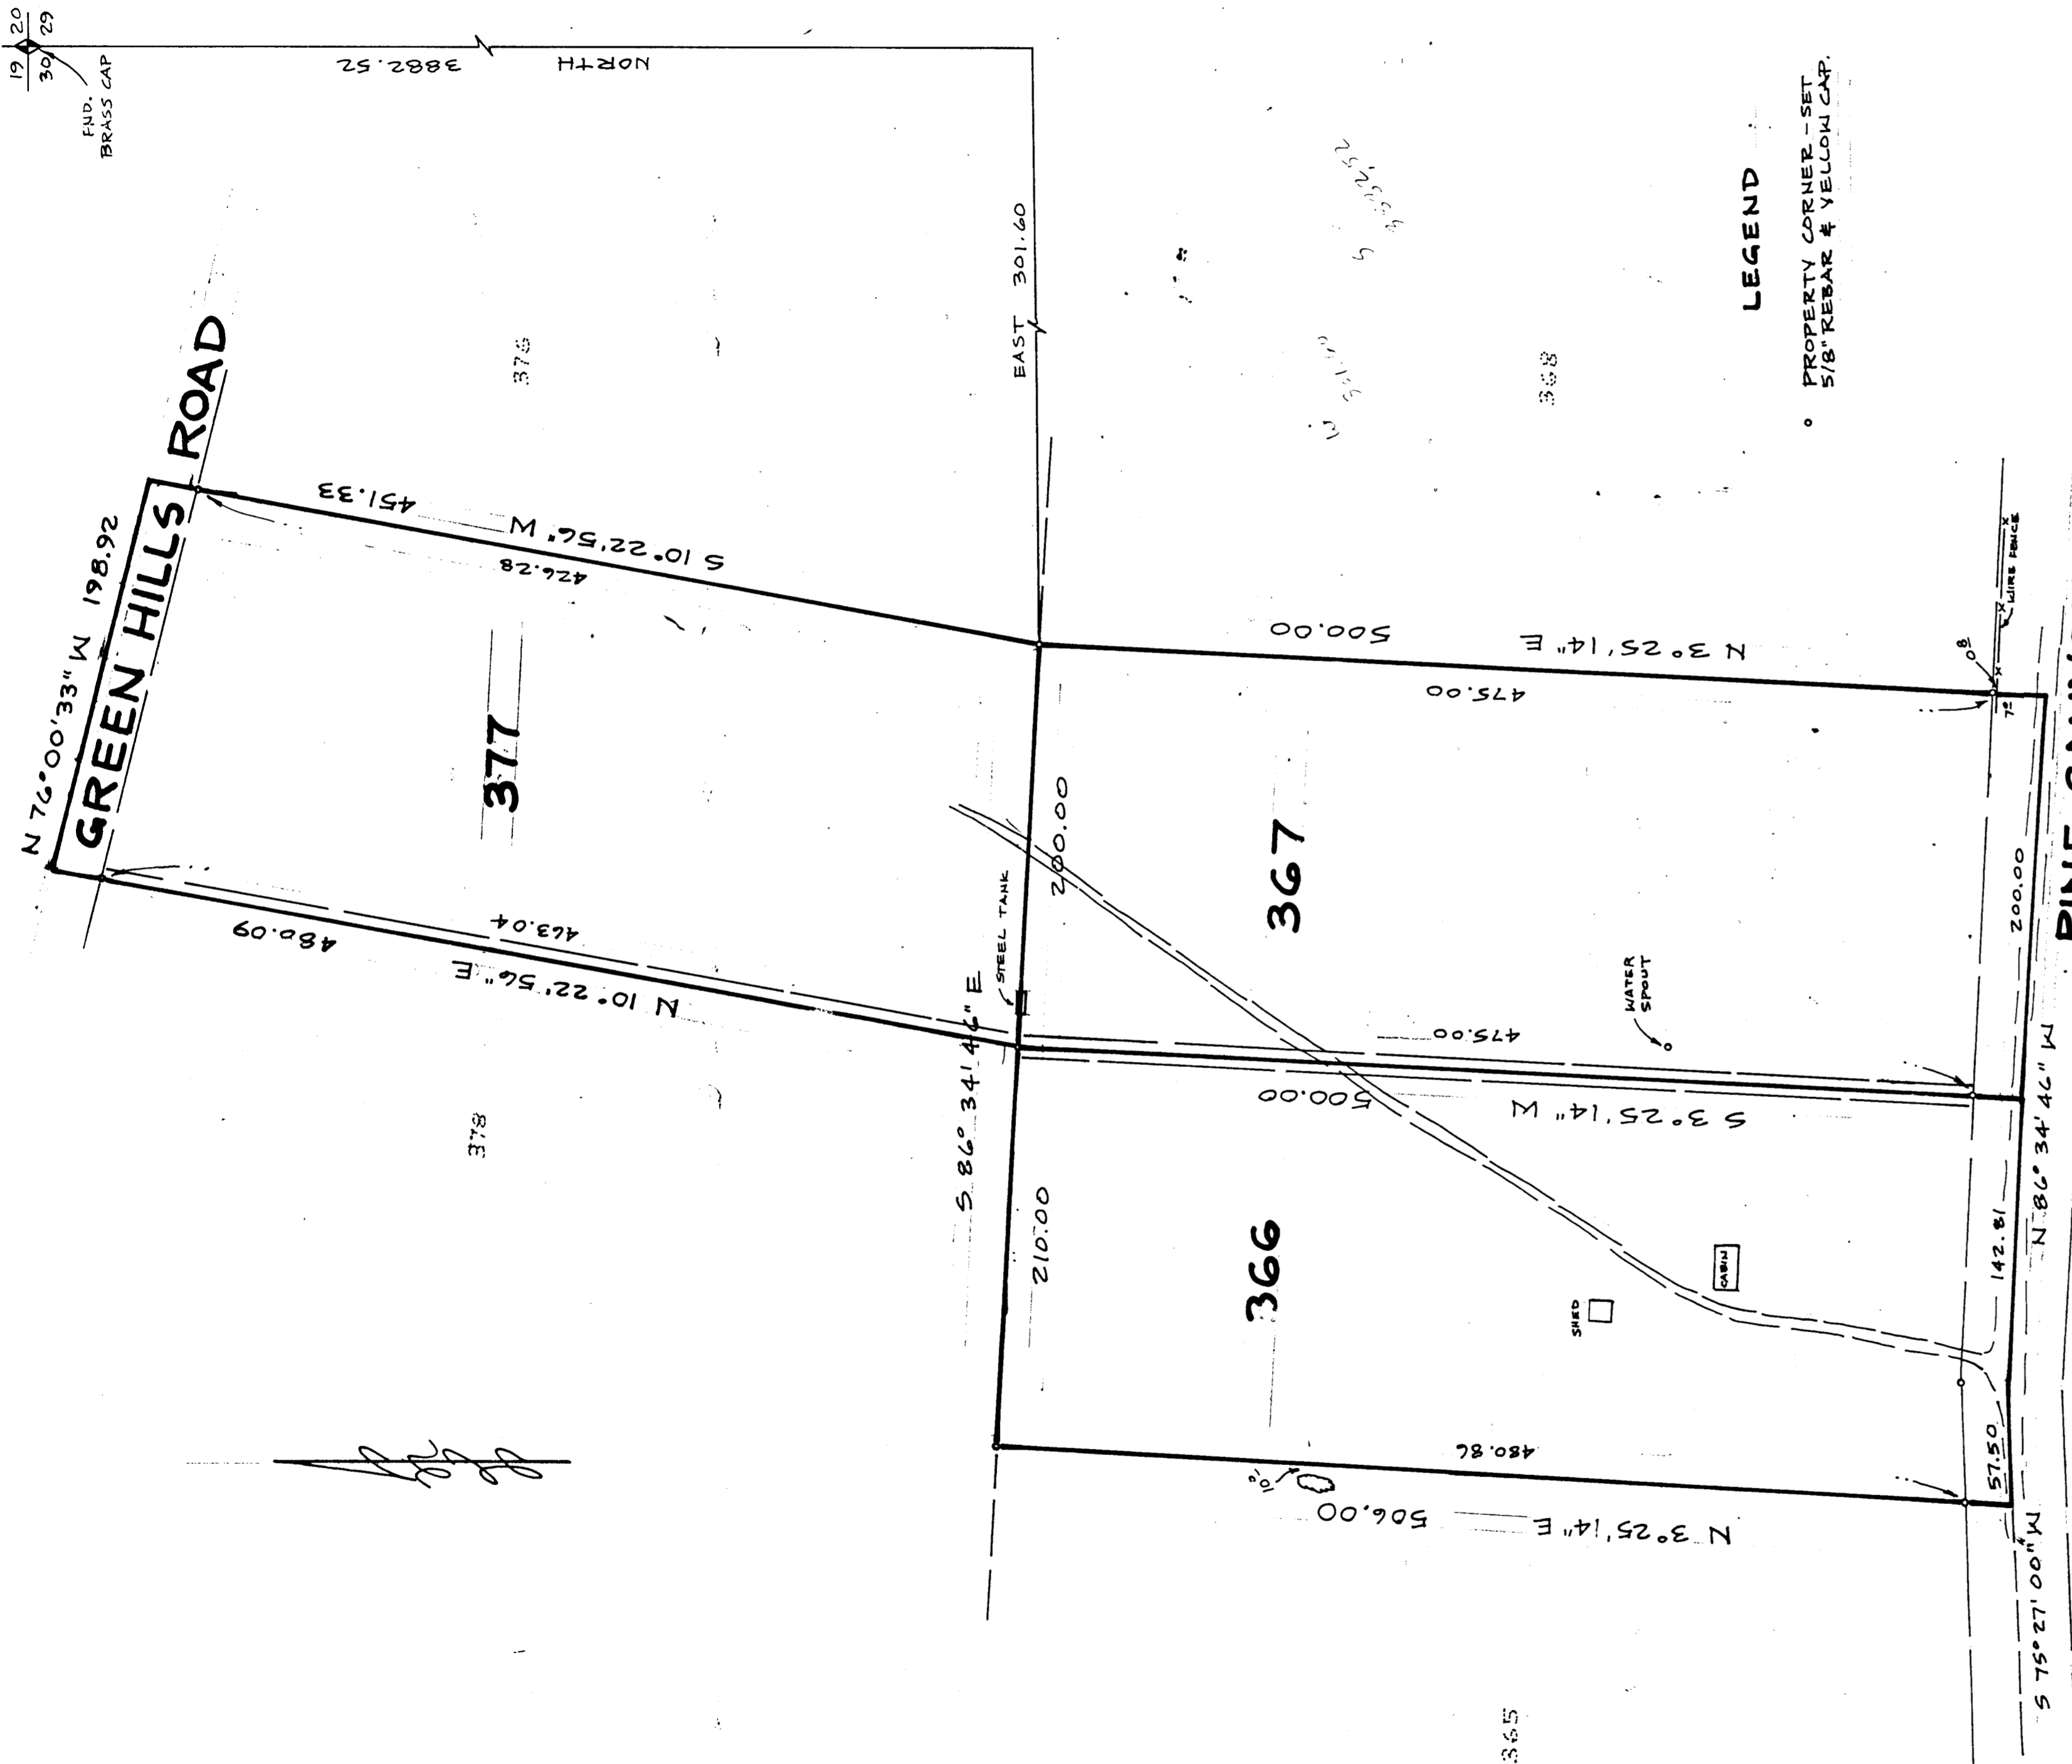

LEGEND

○ PROPERTY CORNER - SET
5/8" REBAR & YELLOW CAP.



NARRATIVE
THE PURPOSE OF THIS SURVEY IS TO DEFINE THE LOT LINES OF THE RECREATIONAL LOTS AT EVERGREEN PARK. TRAVERSE THROUGH THE SECTION AND QUARTER CORNERS CONTROL S FROM THE EXTERIOR BOUNDARY OF THE SUBDIVISION.

LEGAL DESCRIPTION
ALL OF LOTS 366, 367, EVERGREEN PARK SUBDIVISION NO. 1 ACCORDING TO THE OFFICIAL PLAT THEREOF ON FILE AND OF RECORD WITH THE WEBER COUNTY SURVEYORS OFFICE, OGDEN, UTAH.



RECEIVED
MAR 03 1993

Weber County Surveyor

CONTRACT SURVEYORS

REGISTERED LAND SURVEYORS

SANDY, UTAH 84092

328-5883

9740 SO. SITZMARK DR.

SCALE

DATE

RANGE

TOWNSHIP

SECTION

LOT

BLK

PLAT

SURVEY

EVERGREEN PARK SUB'D.

1-20-93

3 E

7 N

SE 1/4 30

36 1/2

34 1/2











SURVEY FOR
MAX PURRINGTON
5070 SO. 300 W.
OGDEN, UTAH 84405

000833