


N.W. CORNER SECTION 31,
TOWNSHIP 7 NORTH, RANGE 2 WEST,
SALT LAKE COUNTY, UTAH
BRASS CAP DATED 1987
AND CAP MARKED AS BELOW.

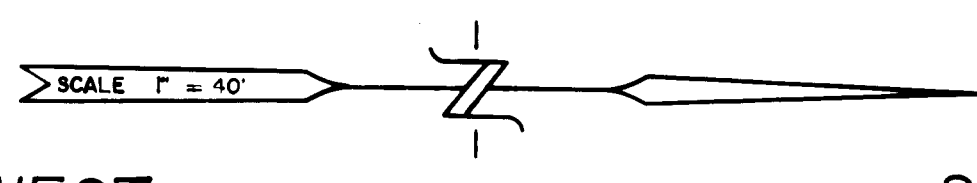

LEGEND

- 1/7 DISTANCE AND OR BEARING PER DEED OR PLAT
- NO. PARALLELS IS MEASURING DISTANCE OR BEARING
- AND ○ C & L.S. 3/4" NEAR W/ CAP
- SET 1/4" NEAR W/ C & L.S. SURVEY CAP.

BOUNDARY DESCRIPTION


A PART OF THE SOUTHWEST QUARTER OF SECTION 31, TOWNSHIP 7 NORTH, RANGE 2 WEST, SALT LAKE BASE AND MERIDIAN, BEGINNING AT A POINT WHICH BEARS S. 01° 00' 00" W. 4355.95 FEET SOUTH 4000 FEET ALONG THE WEST LINE OF SECTION 31, AND RUNNING THENCE N. 02° 20' 22" E. 235.51 FEET TO THE CENTER OF SAID ROAD, 2050 NORTH STREET, THENCE N. 02° 20' 22" E. 249.75 FEET TO THE POINT OF BEGINNING. 2.0 ACRES, MORE OR LESS.

SURVEYOR'S CERTIFICATE

I, CYNTHIA L. ROBINETT DO HEREBY CERTIFY THAT I AM A REGISTERED LAND SURVEYOR AND THAT I HOLD CERTIFICATE NO. 7511 AS PRESCRIBED BY THE LAWS OF THE STATE OF UTAH AND THAT THE FOREGOING IS A TRUE AND CORRECT COPY OF THE RECORDS OF THE WEBER COUNTY RECORDS OFFICE AS DESCRIBED ABOVE AND SHOWN PER THIS PLAT.

15 1993
DATED

CYNTHIA L. ROBINETT, R.L.S.# 7511

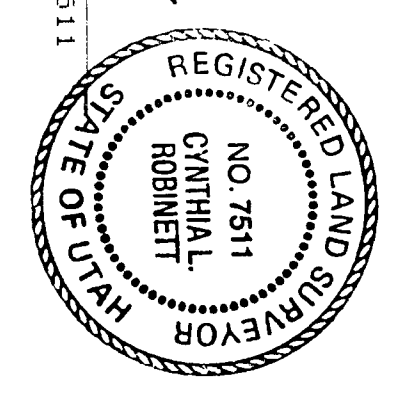

NARRATIVE

THE PURPOSE OF THIS SURVEY WAS TO REOPEN A PORTION OF LAND WHICH HAD A GAP IN THE BOUNDARY LINE AND TO REOPEN THE ADJOINING AND JR. F. A BOUNDARY LINE AGREEMENT HAS BEEN DRAWN UP FOR THE ADJOINERS AND JR. F. STEWART & W.F. DONNA TO FIX THE FENCE LINE BETWEEN THEM AS THEIR RESPECTIVE INTERESTS IN THE LAND. THE PURPOSE OF THIS SURVEY WAS TO REOPEN THE BOUNDARY LINE OF BEARINGS BEING S. 01° 00' 30" W. (DEED = SOUTH) ALONG THE WEST BOUNDARY LINE OF SECTION 31, TOWNSHIP 7 NORTH, RANGE 2 WEST, SALT LAKE BASE AND MERIDIAN WITH WEBER COUNTY SURVEYORS BRASS CAP MARKERS.

RECEIVED
JUN 18 1993
Weber County Surveyor

CONSTRUCTION & LAND SURVEYORS 2761 WASHINGTON BLVD. OGDEN UTAH 84401 (801) 241-4820	CLIENT: JUNIOR STEWART
SURVEY LOCATION: S.W. 1/4 SEC. 31, TOWNSHIP 7 NORTH, RANGE 2 WEST, SALT LAKE BASE & MERIDIAN.	SURVEY DATE: 6-08-93
JOB NO. P 5,93-18	