

DRAWING NUMBER  
000843

DRAWING NUMBER  
000843

DRAWING NUMBER  
000843


DRAWING NUMBER  
000843

PLAN HOLD CORPORATION • IRVINE, CALIFORNIA  
REDEEMED BY NUMBER 0298

PLAN HOLD CORPORATION • IRVINE, CALIFORNIA  
REDEEMED BY NUMBER 0298

PLAN HOLD CORPORATION • IRVINE, CALIFORNIA  
REDEEMED BY NUMBER 0298

PLAN HOLD CORPORATION • IRVINE, CALIFORNIA  
REDEEMED BY NUMBER 0298

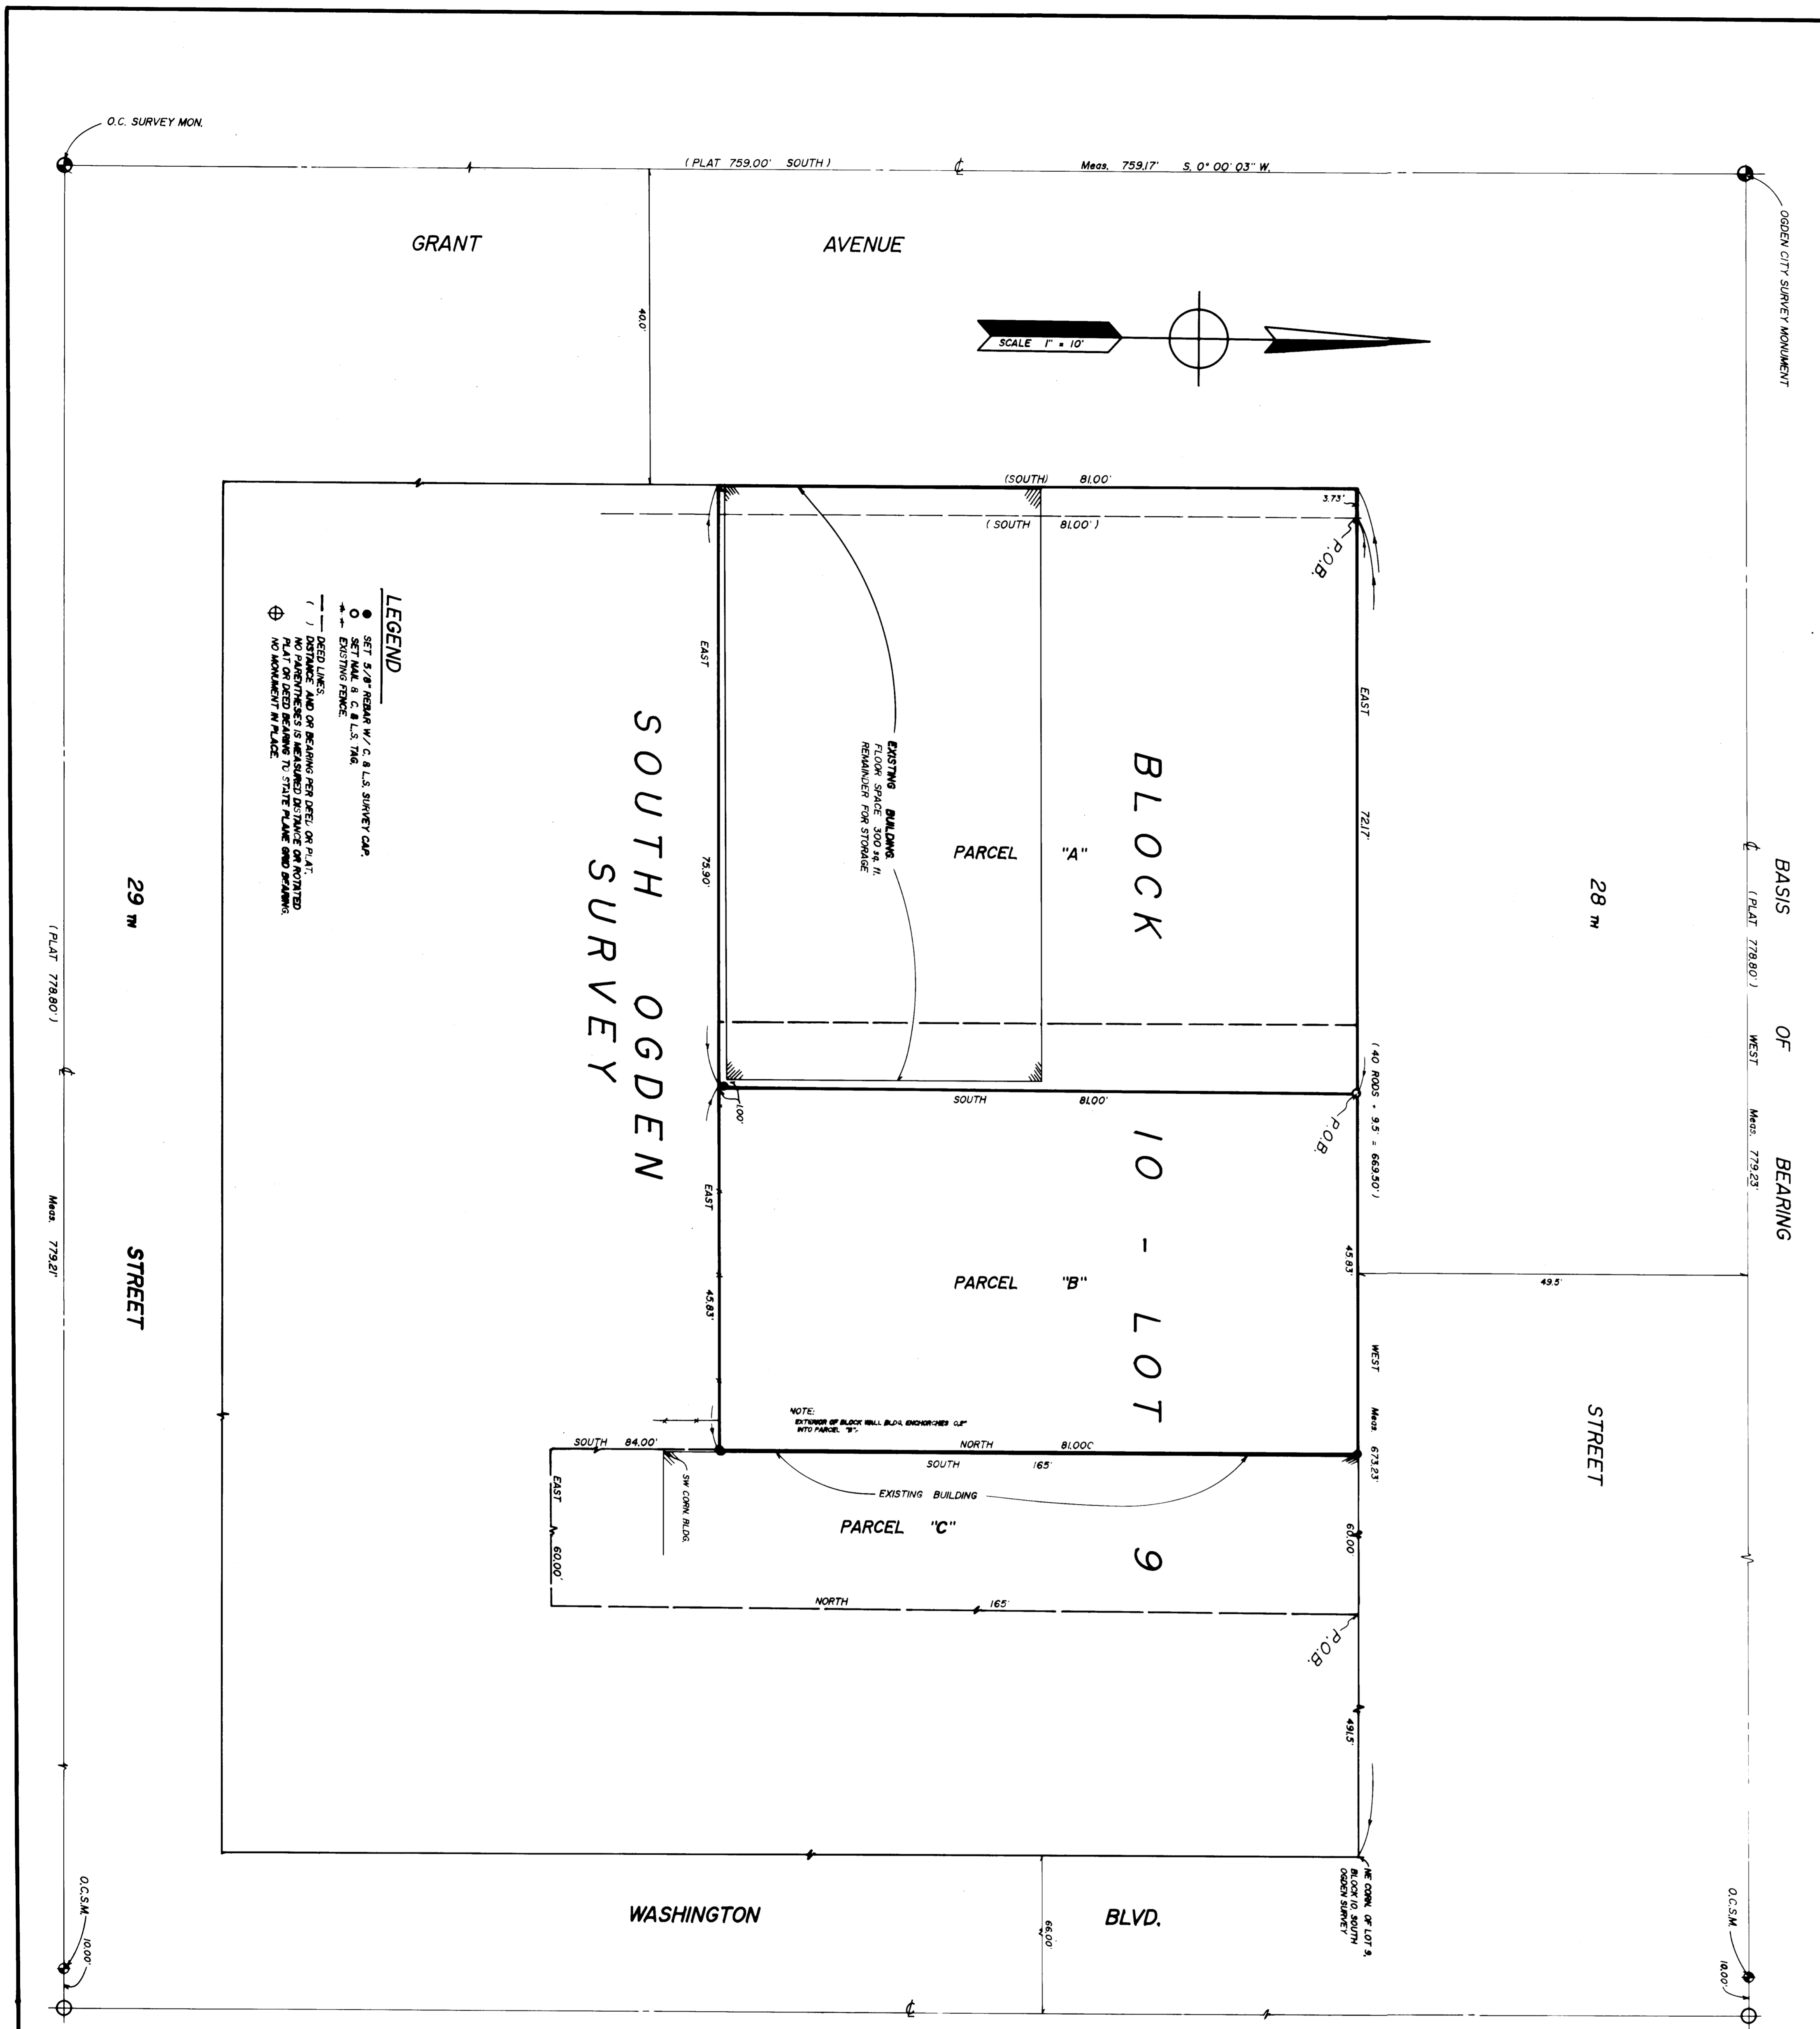

**LEGEND**








**NOTE:**  
EXISTING BUILDING FLOOR SPACE 300 SQ FT REMAINING FOR STORAGE.

**SURVEYOR'S CERTIFICATE**


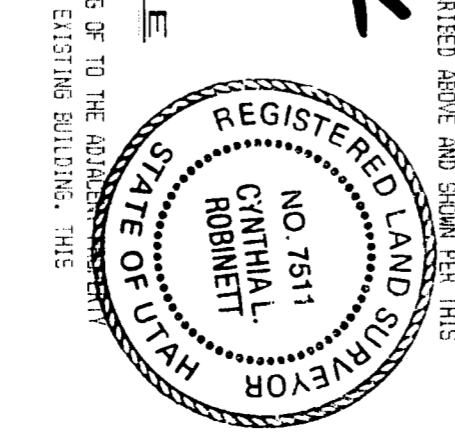

**NARRATIVE**

THE PURPOSE OF THIS SURVEY WAS TO DIVIDE A PORTION OF LAND LOTS BEING PART OF THE ORIGINAL SURVEY OF THE SOUTH 81.00' EAST 72.17' AND SOUTH 84.00' EAST 60.00' PARCELS, BEING ONE FOOT PART OF AN EXISTING BUILDING, THIS PARCEL IS TO BE COMBINED WITH SURVEYOR PARCEL TO THE EAST.

**RECEIVED**  
JUN 18 1993  
Michele County Surveyors

<p>CONSTRUCTION &amp; LAND SURVEYS, INC. 27151 WASHINGTON BLVD. OGDEN, UTAH 84401 (801) 388-4858</p>	<p>CLIENT: JOE PROGAZIER</p>	<p>JOB NO. 9-533-03</p>
<p>PROJECT LOCATION: LOT 9 &amp; 10, BLOCK 19, C.O.S., NORTH 99C, 92 TOWNSHIP 8 NORTH, RANGE 1 WEST, SALT LAKE BASE &amp; MERIDIAN</p>	<p>SURVEY DATE: 02-17-93</p>	

000843