


**SURVEYORS CERTIFICATE**

I, Larry M. Buttars, a registered Land Surveyor as prescribed by the laws of the State of Utah, and holding license No. 2596, do hereby certify that I made a survey of the below described property and the Plat hereon is a true and correct representation of said survey.

Date 6-23-93 Sign: *[Signature]*

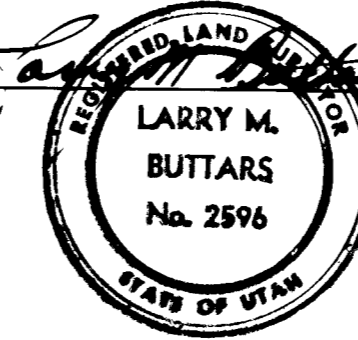

**DESCRIPTION**

Lot 92, Causey Estates Subdivision No. 2, Weber County, Utah according to the official plat thereof.

**NARRATIVE**

The purpose of this survey was to establish property boundaries to make improvements on the lot.  
Basis of Bearings: North line of Sec. 10 from the recorded Subdivision plat.

**LEGEND**

- Set 3/4" x 24" re-bar with plastic cap stamped L Buttars R L S 2596
- Set P.K. nail with ribbon

RECEIVED

JUN 28 1993

Weber County Surveyor

|                                 |                 |
|---------------------------------|-----------------|
| <b>BUTTARS SURVEYING</b>        |                 |
| 1815 26 <sup>TH</sup> STREET    | OGDEN, UT 84401 |
| PHONE 392-5231                  |                 |
| CLIENT                          | JOHN ALLEN      |
| SURVEY LOCATION                 |                 |
| N E 1/4 SEC 10, T6N, R3E, S1B#M |                 |
| CAUSEY EST NO 2, WEBER COUNTY   |                 |
| SURVEY DATE                     | 6-19-93         |