


SURVEYORS CERTIFICATE

I, Larry M. Buttars, a registered Land Surveyor as prescribed by the laws of the State of Utah and holding license No. 2596 do hereby certify that I made a survey of the above described property and the Plat hereon is a true and correct representation of said survey.

Date: 5-8-93 Sign: [Signature]

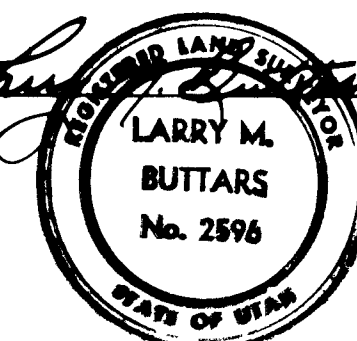

DESCRIPTION

Part of Lots 6, 7 and 8, Block 2, Brinker and Hochstetler's Subdivision of the East 1/2 of Block 27, Plat C, Ogden City Survey Beginning at the Southwest corner of said Lot 6, and running thence N 0° 58' E 44.00 ft, thence S 89° 02' E 132.00 ft to Alley, thence S 0° 58' W 44.00 ft, thence N 89° 02' W along the South line of said lots 6, 7 & 8 in said Block 2 132.00 ft to the place of beginning.

NARRATIVE

The purpose of this Survey was to establish property corners for fencing of lot Ogden City bearings were used for this survey.

LEGEND

- Set 3/4 x 24 re-bar with plastic cap stamped L Buttars R L S. 2596
- [Symbol]

RECEIVED

JUN 28 1993

Weber County Surveyor

BUTTARS SURVEYING  
1815 26TH STREET OGDEN, UT 84401  
PHONE 392-5291

CLIENT LARRY CURTIS

SURVEY LOCATION  
NE 1/4 SEC 33, T 6 N, R 1 W, S 13 M  
BRINKER AND HOCHSTETLER'S SUBDIVISION  
OGDEN CITY, WEBER CO

SURVEY DATE 5-8-93