000864 000864 000864 000864

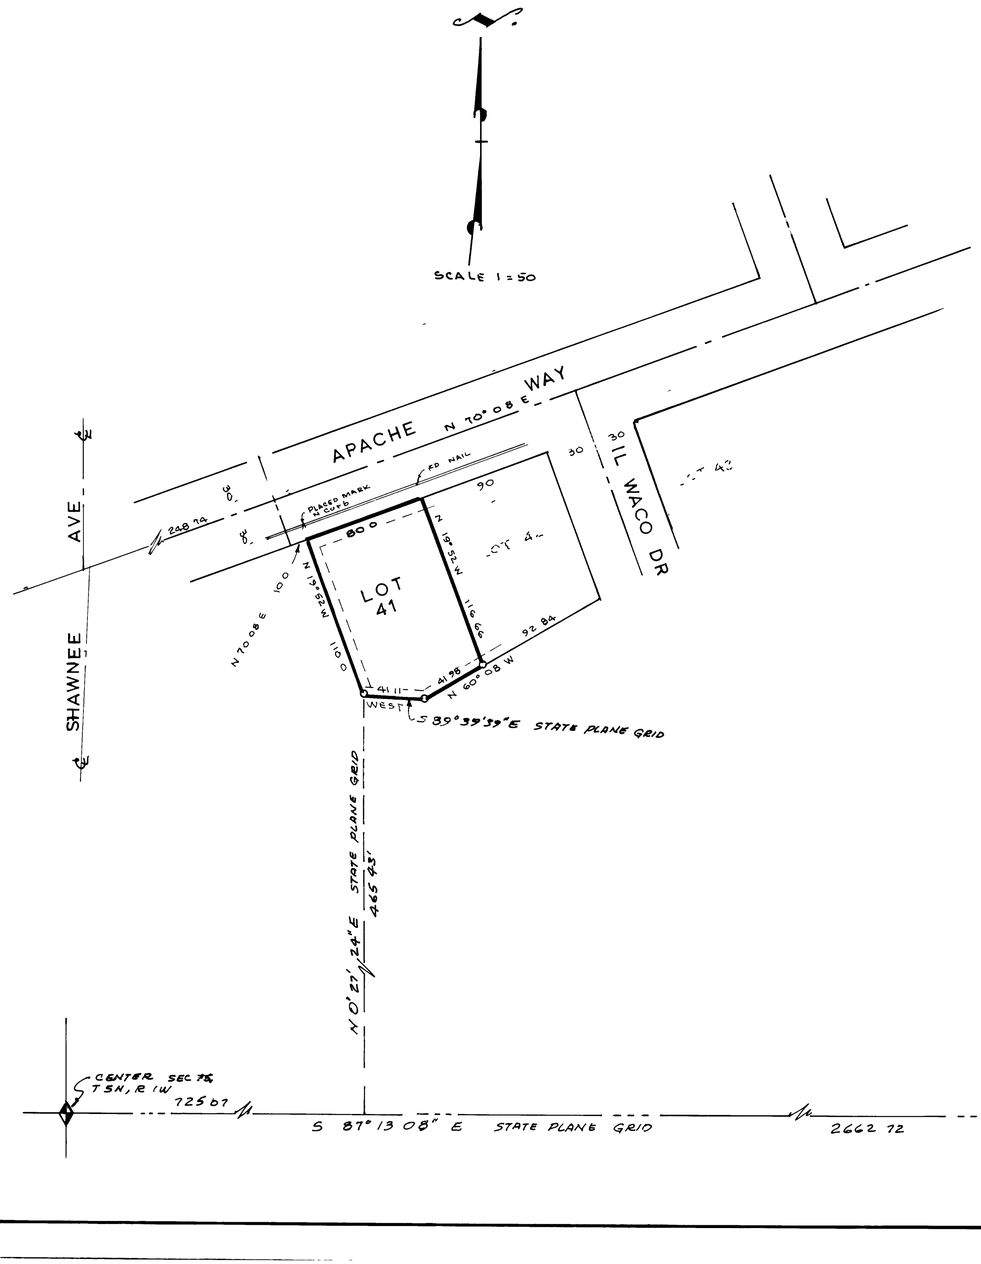

SURVEYORS CERTIFICATE

I, Larry M Buttars, a registered Land Surveyor as prescribed by the laws of the State of Utah, and holding licence No 2596 do hereby certify that I made a survey of the below described property and the Plat hereon is a true and correct representation of said survey

Date 4 5 93 Signed Larry M Buttars

REGISTERED LAND SURVEYOR LARRY M BUTTARS No 2596 STATE OF UTAH

DESCRIPTION

Lot 41, Shadow Valley Estates Subdivision No 7, in Ogden City Weber County, Utah according to the official Plat thereof

NARRATIVE

The purpose of this survey was to establish the property corners for fencing.

Record bearings for Shadow Valley Estates No 4 & No 7 were used for this survey, rotated counter-clockwise 0°20'21" from State Plane Grid bearings

LEGEND

- o Set 1/2 x 24" re bar with plastic cap stamped L Buttars R L S 2596
- • Set P K nail with ribbon

RECEIVED

JUN 28 1993

Weber County Surveyor

BUTTARS SURVEYING 1815 26TH STREET OGDEN, UT 84401 PHONE 392-5291	
CLIENT	STEVE PHILPOT
SURVEY LOCATION N E 1/4 SEC 15, T 5N, R 1W, S L B & M LOT 41, SHADOW VALLEY ESTATES NO 7	
SURVEY DATE	4-3-93

000864