


**SURVEYORS CERTIFICATE**

I, Larry M Buttars, a registered Land Surveyor as prescribed by the laws of the State of Utah and holding licence No 2596, do hereby certify that I made a survey of the below described property and the Plat hereon is a true and correct representation of said survey.

Date 3-27-93 Sign Larry M Buttars

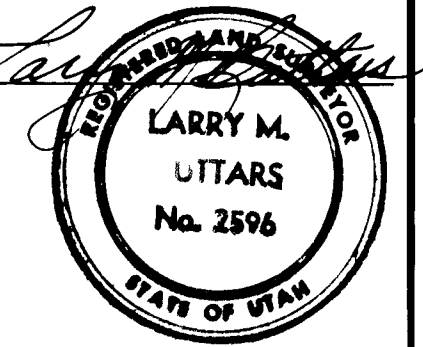

**DESCRIPTION**

All of Lots 1 to 6 inclusive in Block 2, White Addition to Ogden City Weber County Utah together with the vacated alley abutting thereon, according to the official plat and records on file in the Weber County Recorders Office.

**NARRATIVE**

The purpose of this Survey was to establish the North property line because of a dispute. Ogden City bearings and monuments were used for this Survey.

**LEGEND**

- Set 3/4" x 24" re bar with plastic cap stamped L Buttars R L S 2596
- Set P K nail with ribbon

**RECEIVED**

JUN 28 1993

Weber County Surveyor

|  |                 |
|--|-----------------|
| <b>BUTTARS SURVEYING</b>                     |                 |
| 1815 26 <sup>TH</sup> STREET OGDEN, UT 84401 |                 |
| PHONE 392-5291                               |                 |
| CLIENT                                       | CHARLES H SMITH |
| SURVEY LOCATION                              |                 |
| SE 1/4 SEC 17 T 6 N, R 1 W, S L B #M         |                 |
| WHITE ADD'N TO OGDEN CITY                    |                 |
| SURVEY DATE                                  | 3-27-93         |