


SCALE 1" = 100'

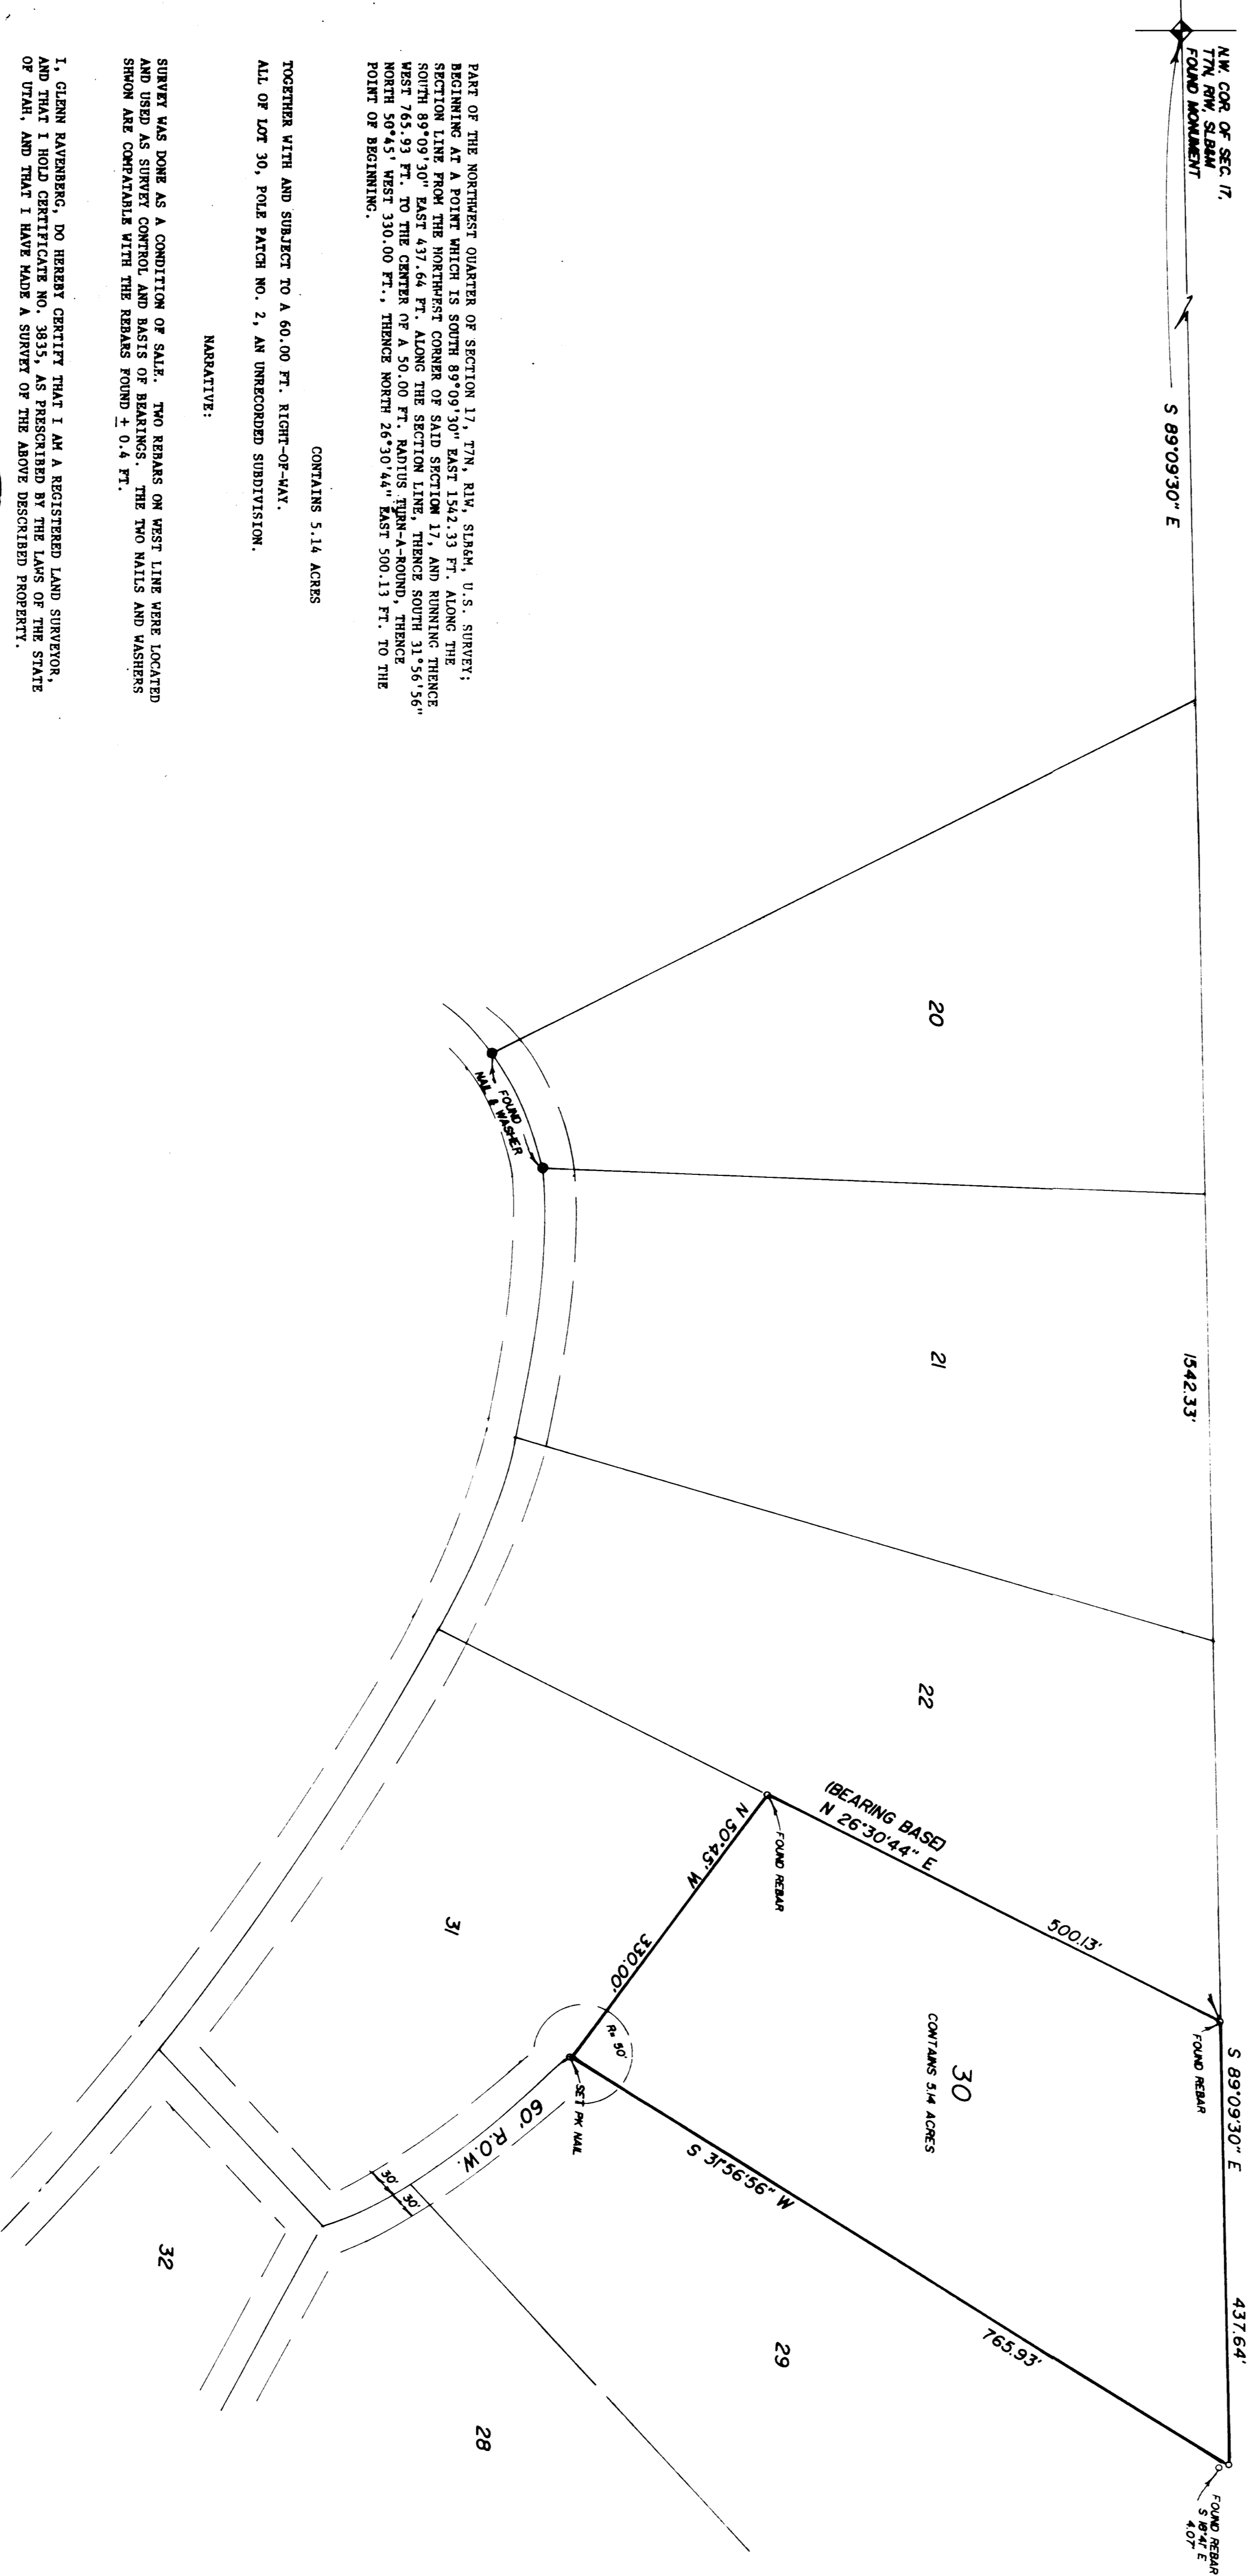


CONTAINS 5.14 ACRES

TOGETHER WITH AND SUBJECT TO A 60.00 FT. RIGHT-OF-WAY.


ALL OF LOT 30, POLE PATCH NO. 2, AN UNRECORDED SUBDIVISION.




MAY 28, 1993

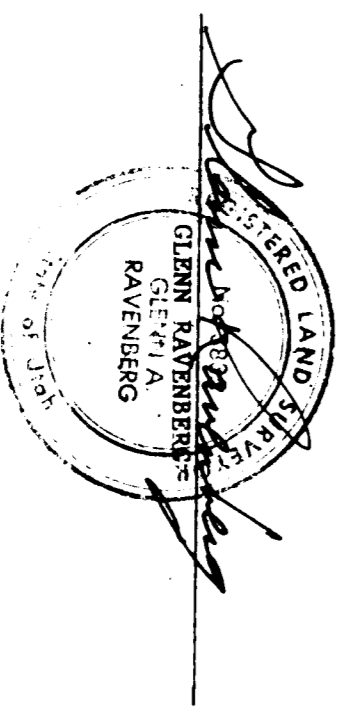

PART OF THE NW 1/4 OF SEC. 17, T7N, R1W, S24M

RECEIVED
JUL 14 1993

Welder County Surveyor

INTERMOUNTAIN SURVEYING
14440
14440

PROPERTY SURVEY

FOR
JOHN LASATER (DON SPATIG)

MAY 27 1993

F = 100'

PS-93-45