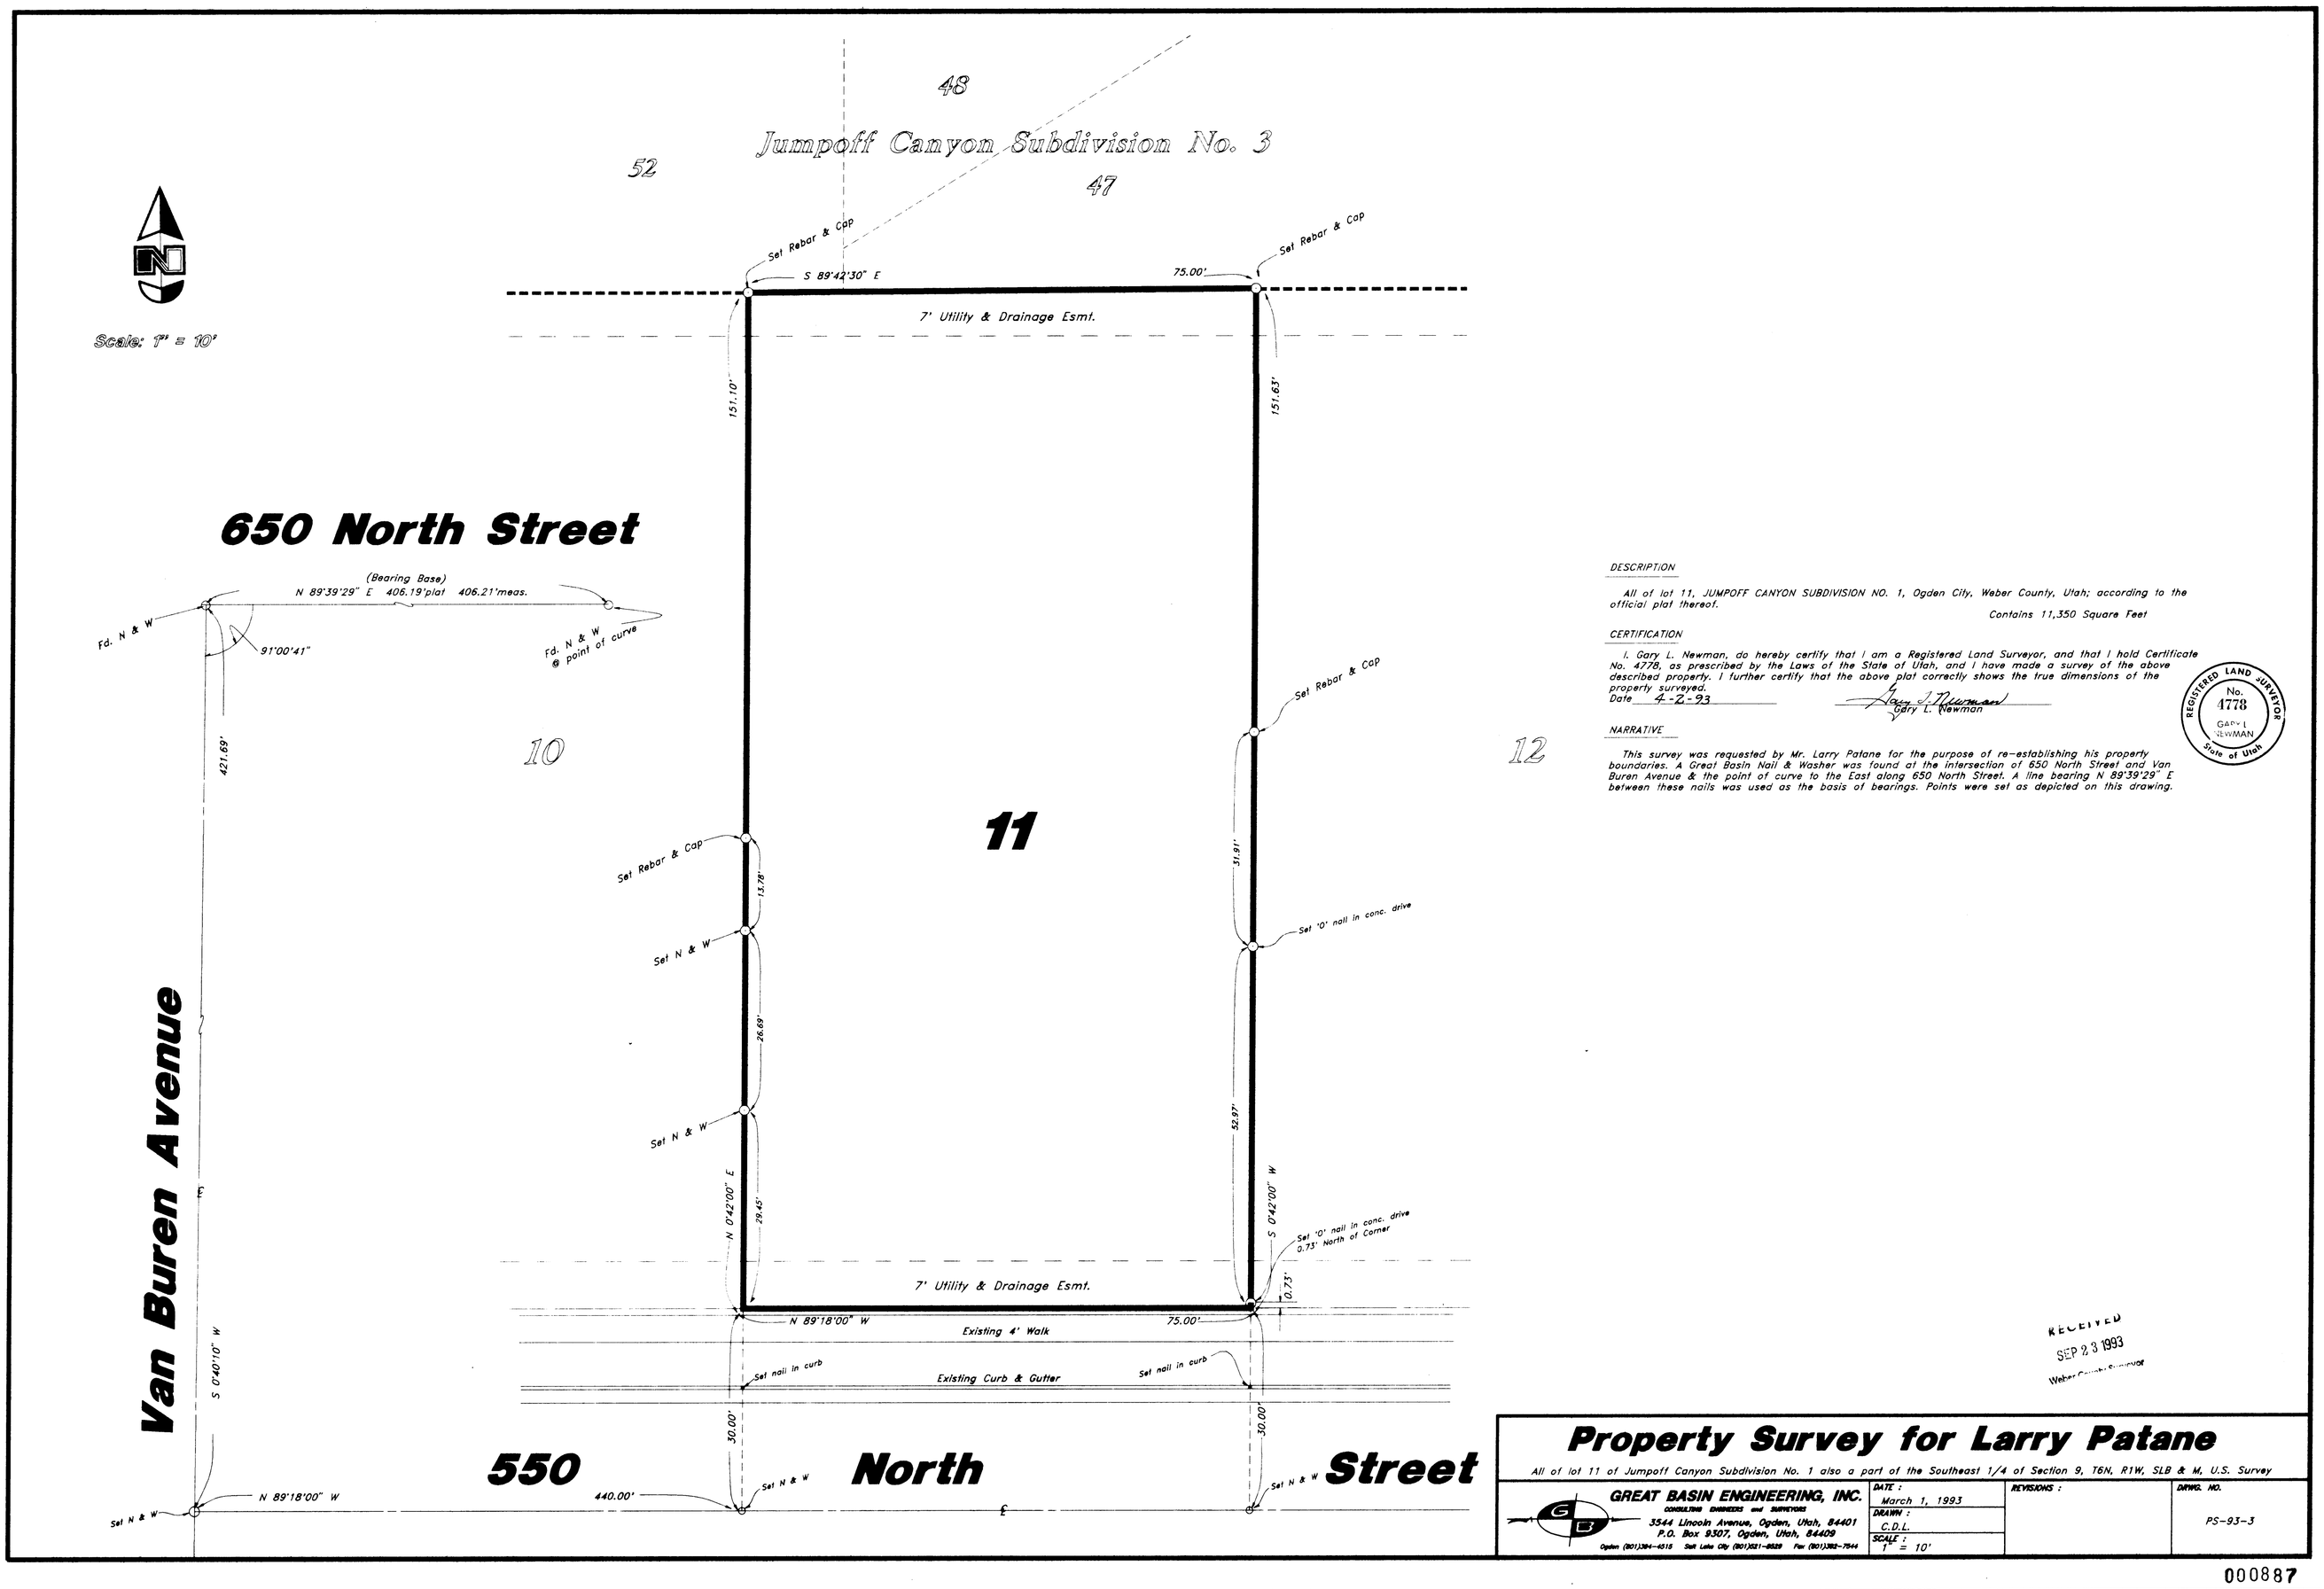

DESCRIPTION

All of lot 11, JUMPOFF CANYON SUBDIVISION NO. 1, Ogden City, Weber County, Utah; according to the official plat thereof.

Contains 11,350 Square Feet

CERTIFICATION

I, Gary L. Newman, do hereby certify that I am a Registered Land Surveyor, and that I hold Certificate No. 4778, as prescribed by the Laws of the State of Utah, and I have made a survey of the above described property. I further certify that the above plat correctly shows the true dimensions of the property surveyed.

Date 4-2-93

Gary L. Newman

REGISTERED LAND SURVEYOR No. 4778 GARY L. NEWMAN State of Utah

NARRATIVE

This survey was requested by Mr. Larry Patane for the purpose of re-establishing his property boundaries. A Great Basin Nail & Washer was found at the intersection of 650 North Street and Van Buren Avenue & the point of curve to the East along 650 North Street. A line bearing N 89°39'29" E between these nails was used as the basis of bearings. Points were set as depicted on this drawing.

RECEIVED SEP 23 1993 Weber County Surveyor

Property Survey for Larry Patane

All of lot 11 of Jumpoff Canyon Subdivision No. 1 also a part of the Southeast 1/4 of Section 9, T6N, R1W, SLB & M, U.S. Survey

GREAT BASIN ENGINEERING, INC.
CONSULTING ENGINEERS and SURVEYORS
3544 Lincoln Avenue, Ogden, Utah, 84401
P.O. Box 9307, Ogden, Utah, 84409
Ogden (801)394-4515 Salt Lake City (801)521-8529 Fax (801)392-7944

DATE :	REVISIONS :	DRWG. NO.
March 1, 1993		PS-93-3
DRAWN : C.D.L.		
SCALE : 1" = 10'		

DRAWING NUMBER 000887

000887