


N. 01° 07' 21" E. Web. Co. 5116.92' Meas. 5117.07'


1900 WEST (HWY. 126)

(N. 0° 44' E. 844.63') N. 01° 11' 15" E. 842.08'

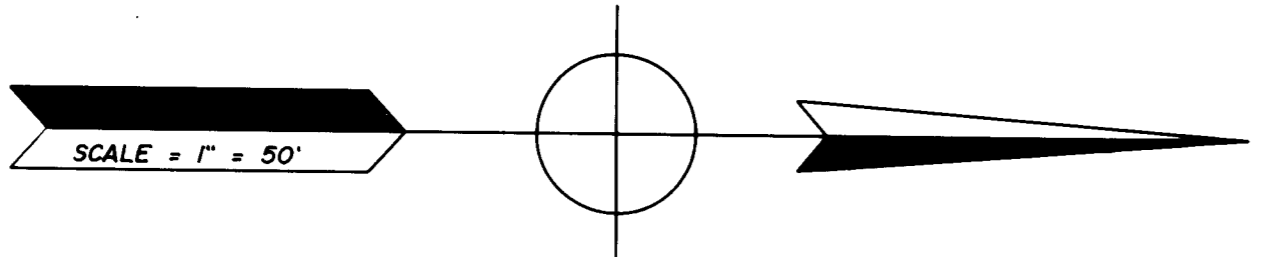

SW CORNER OF SEC. 24,
T. 6 N. R. 2 W., S. 1 B. & M.,
WEBER CO. SURVEYORS BRASS
CAP MONUMENT.

NW CORN. SECTION 24, T. 6 N. R. 2 W.,
W.C.S.B. CAP MON.

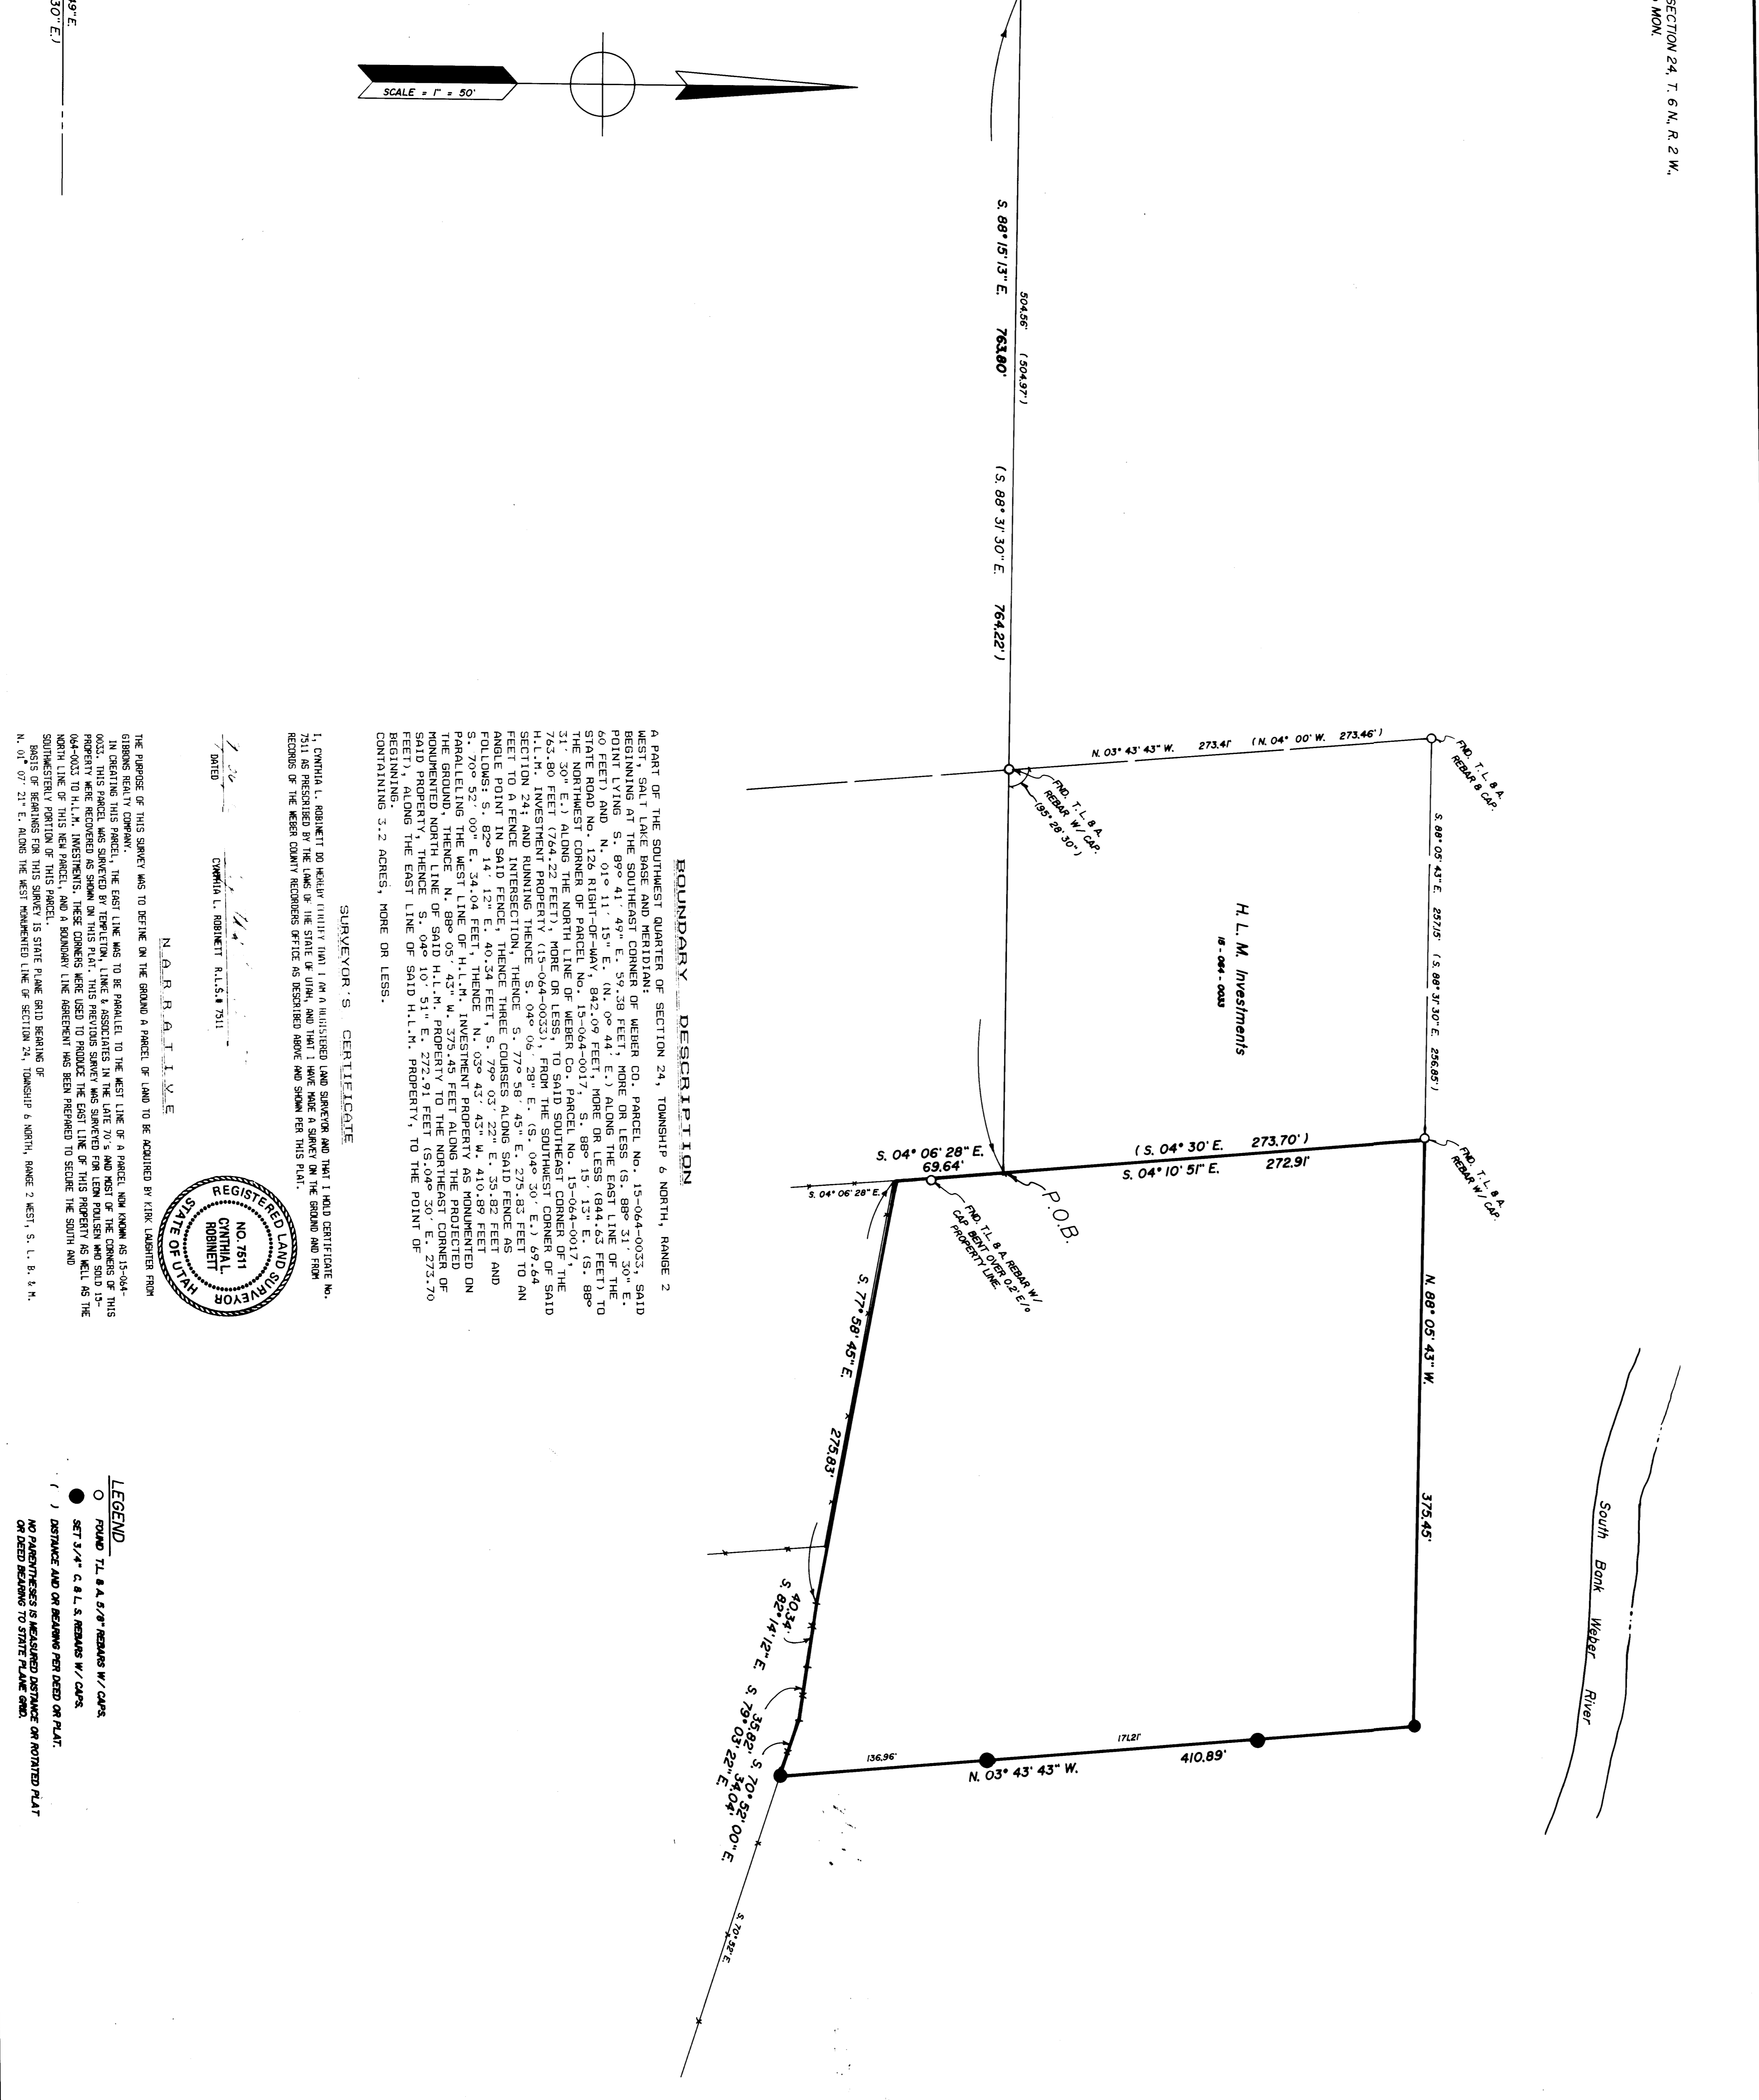


BOUNDARY DESCRIPTION



SURVEYOR'S CERTIFICATE


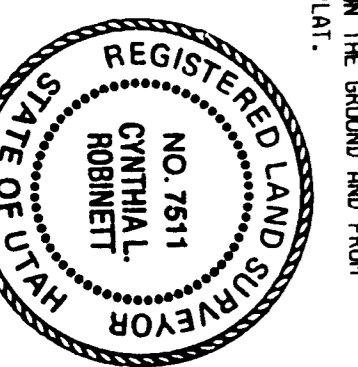

NORTH, RANGE 2 WEST, S. 1 B. & M., N. 01° 07' 21" E. ALONG THE WEST MONUMENTED LINE OF SECTION 24, TOWNSHIP 6 NORTH, RANGE 2 WEST, S. 1 B. & M., CONTAINING 3.22 ACRES, MORE OR LESS.

LEGEND


RECEIVED
OCT 15 1993
Webber County Surveyor

CONSTRUCTION & LAND SURVEYORS
2741 WASHINGTON BLVD.
ORANGE, UTAH 84401
(801) 398-4838

CLIENT:
CENTRA 749

SURVEY LOCATION:
SW 1/4 SECTION 24,
SALT LAKE BASE & MERIDIAN

SURVEY DATE:
8/19/93

JOB NO.:
FS-922-54