

DRAWING NUMBER
000902

PLAN HOLD CORPORATION • IRVINE, CALIFORNIA
REORDER BY NUMBER 01548
POSITION EDGE OF FRAME ON THIS LINE

DRAWING NUMBER
000902


PLAN HOLD CORPORATION • IRVINE, CALIFORNIA
REORDER BY NUMBER 01548
POSITION EDGE OF FRAME ON THIS LINE

DRAWING NUMBER
000902

PLAN HOLD CORPORATION • IRVINE, CALIFORNIA
REORDER BY NUMBER 01548
POSITION EDGE OF FRAME ON THIS LINE

DRAWING NUMBER
000902

PLAN HOLD CORPORATION • IRVINE, CALIFORNIA
REORDER BY NUMBER 01548
POSITION EDGE OF FRAME ON THIS LINE

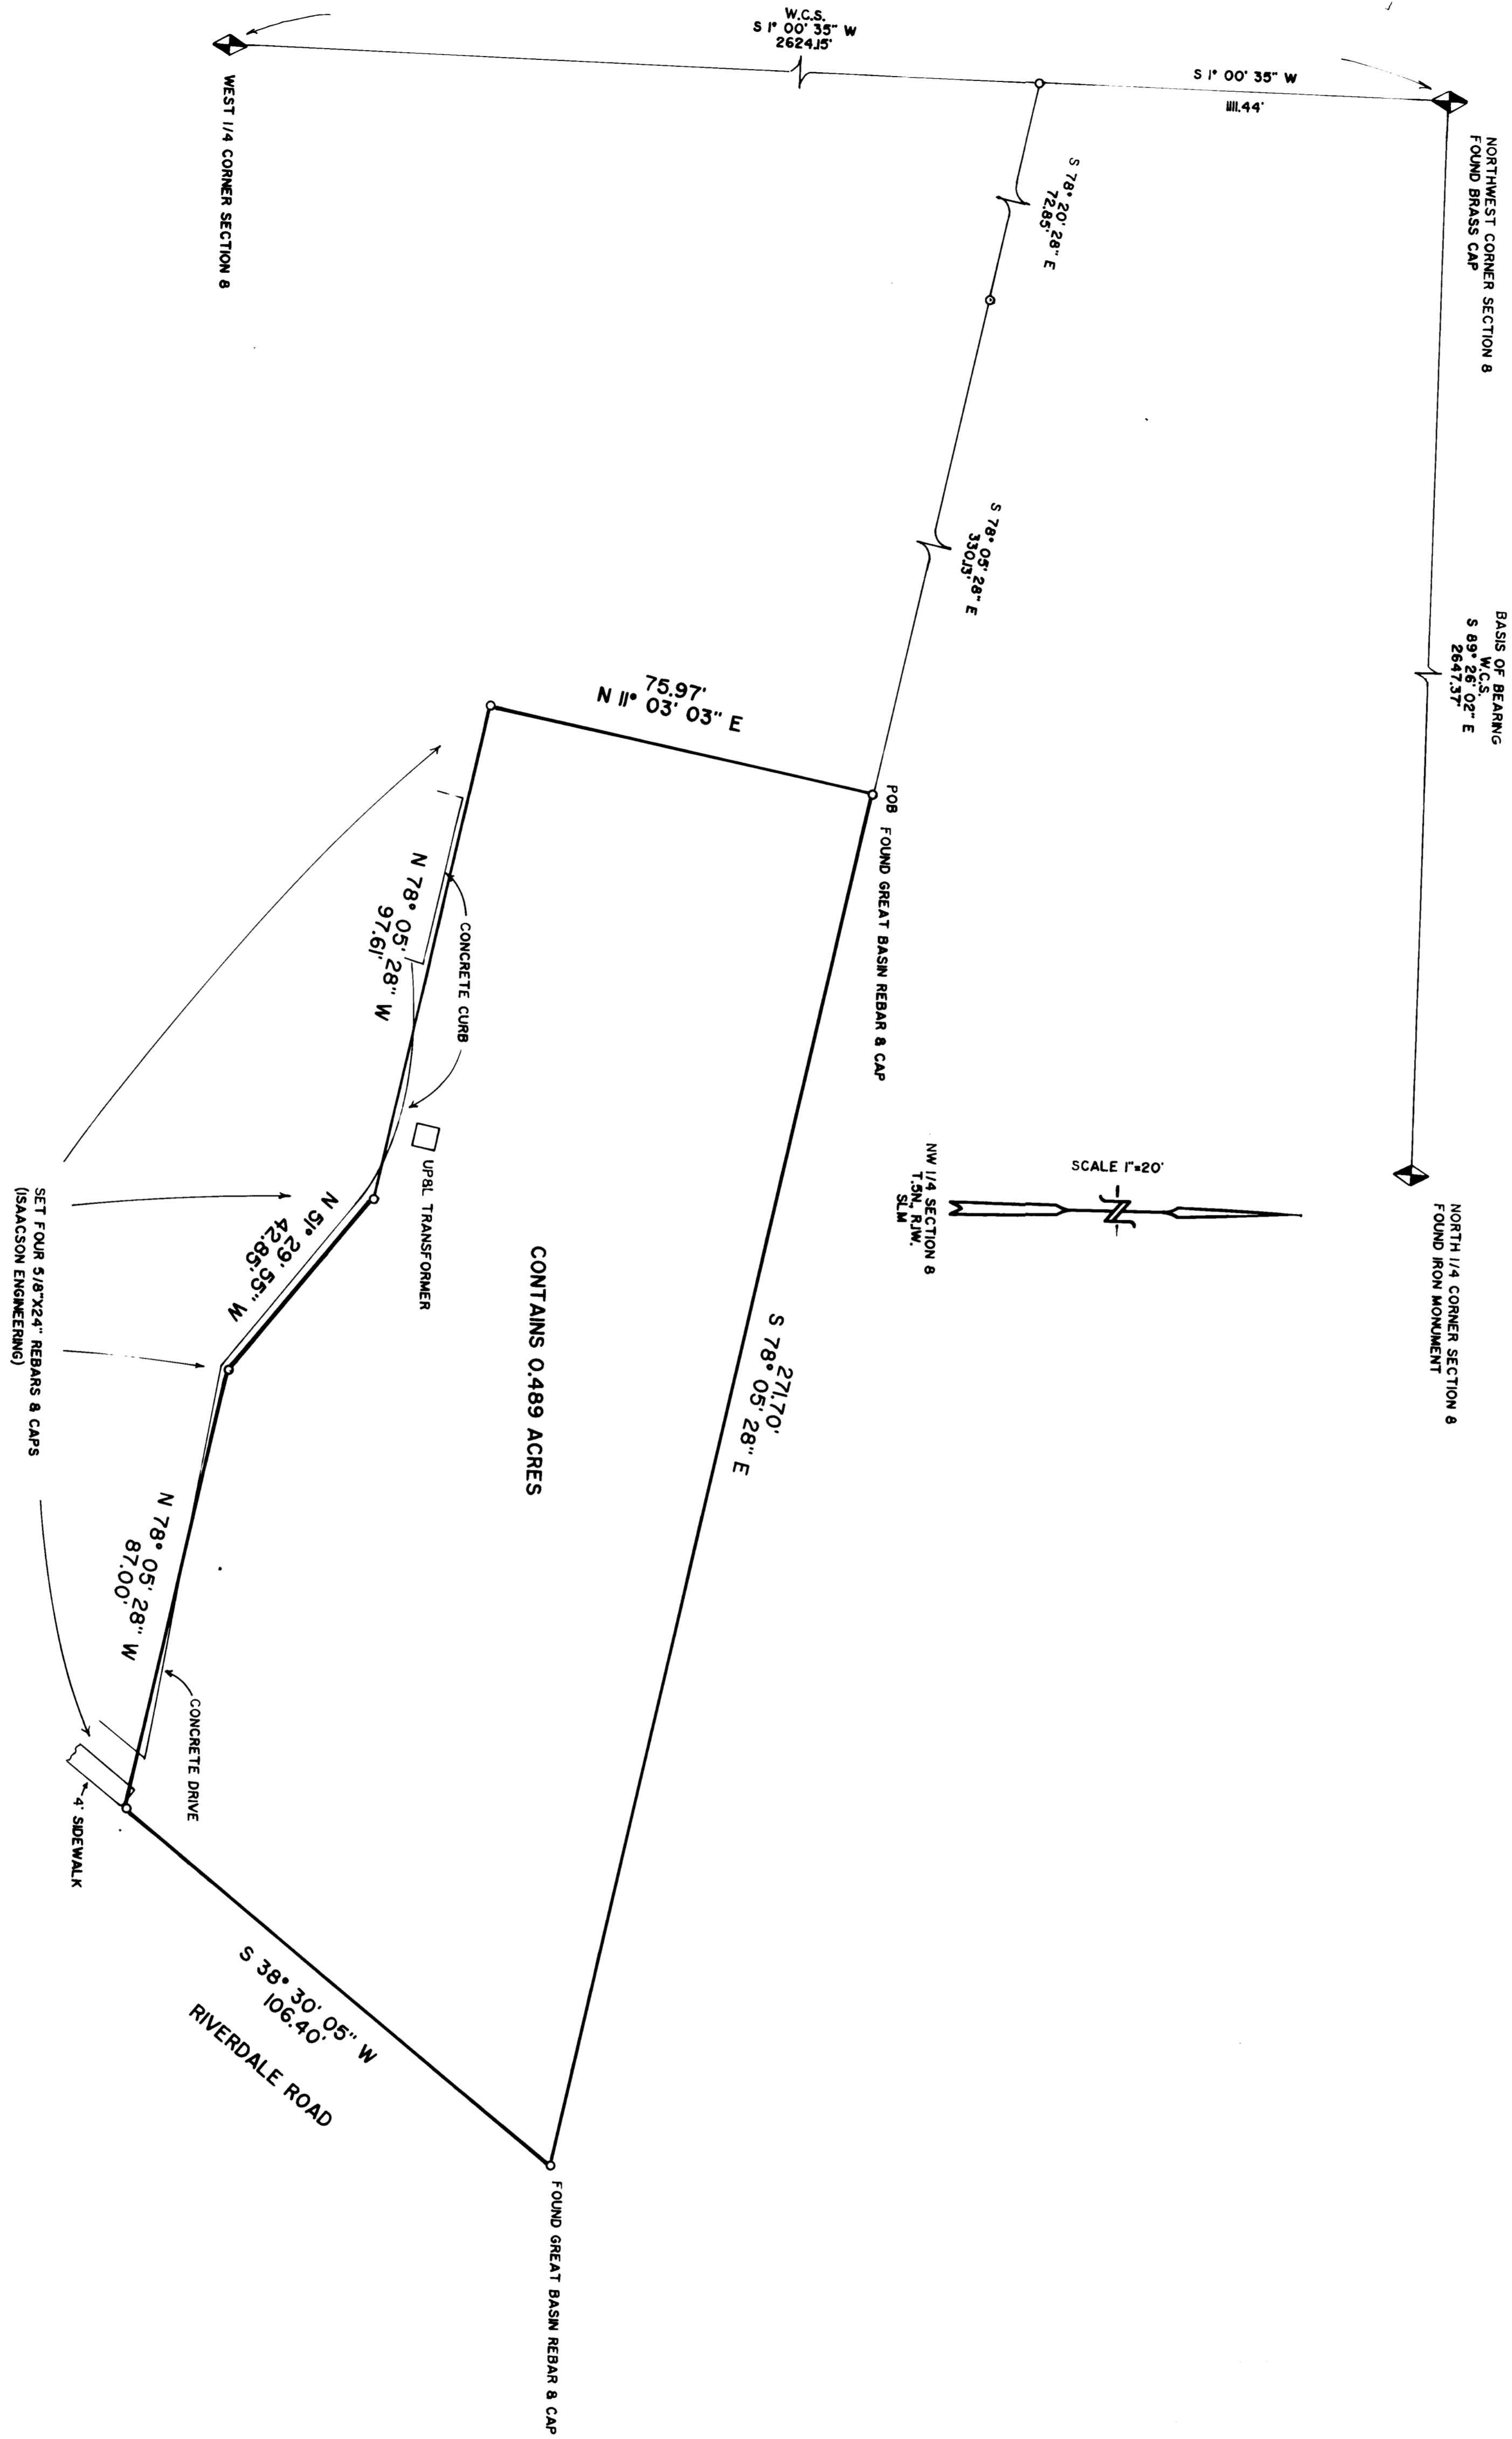

SURVEYOR'S CERTIFICATE
 I, JERRY H. ISAACSON, DO HEREBY CERTIFY THAT I AM A REGISTERED LAND SURVEYOR AND THAT I HOLD LICENSE NO. 4775, AS PRESCRIBED BY THE CONSTITUTION OF UTAH, AND I FURTHER CERTIFY THAT I HAVE MADE A SURVEY OF THE DESCRIBED PROPERTY AND THAT THIS PLAT IS A TRUE AND CORRECT REPRESENTATION OF THE DESCRIBED PROPERTY.

3-18-1991
DATE

Jerry H. Isaacson
JERRY H. ISAACSON

DESCRIPTION



CONTAINS 0.489 ACRES

NARRATIVE

THE PURPOSE OF THIS SURVEY IS TO SEPARATE THIS PARCEL FROM A LARGER PARCEL. THE LARGER PARCEL WAS ORIGINALLY SURVEYED BY GREAT BASIN ENGINEERING, INC. (DRAWING NO. PS-89-97 DATED NOVEMBER 1, 1989). THIS ORIGINAL SURVEY WAS USED AS A REFERENCE FOR THIS SURVEY IN ESTABLISHING THE FOUR NEW PROPERTY CORNERS AS REQUESTED BY THE CLIENT.

RECEIVED
OCT 21 1993

PROPERTY SURVEY

Prepared for
DELL S. NICHOLS REALTY CORP.

ISAACSON ENGINEERING
8 SURVEYING
ARVILLE, UTAH 84004

NO.	DATE	DESCRIPTION
1	10/21/93	PROPERTY SURVEY