


SURVEYORS CERTIFICATE

I, Larry M. Buttars, a registered Land Surveyor as prescribed by the laws of the State of Utah, and holding licence No. 2596, do hereby certify that I made a survey of the below described property and the Plat hereon is a true and correct representation of said survey.

Date: 8-2-93 Sign: *[Signature]*

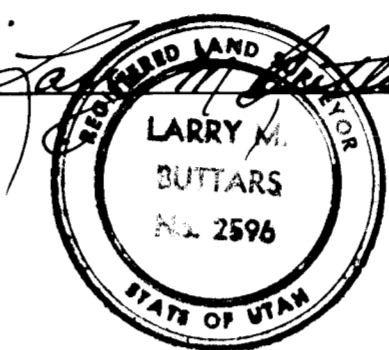

DESCRIPTION

Part of Lot 2, Block 1, Plat C, Huntsville Survey, Weber County, Utah: Beginning at the Northeast corner of said Lot 2 and running thence S. 1° 21' E. (south) 271.60 ft., thence N. 82° 42' W. 111.97 ft. (Deed N. 82° 42' W. 117.75 ft.) thence N. 43° 14' W. 31.91 ft. (Deed N. 41° 53' W. 22.0 ft.) thence N. 1° 21' W. (Deed North) 231.00 ft., thence N. 88° 39' E. 132.00 ft. (Deed East 8 rods) to the point of beginning. Contains 0.188 Acres

NARRATIVE

Huntsville Townsite Survey record Plat Bearings used as Basis of bearings. Described bearings rotated 1° 21' counter-clockwise.

RECEIVED

AUG 20 1993

Weber County Surveyor

LEGEND

- o Set 3/4" x 24" re-bar with plastic cap stamped L. Buttars R.L.S. 2596
- Set P.K. nail with ribbon

BUTTARS SURVEYING
 1815 26TH STREET OGDEN, UT. 84401
 PHONE 392-5291

CLIENT: ROBERT & SUZANNE ELLISON

SURVEY LOCATION:
 N. W. 1/4 SEC. 18, T. 6 N, R. 2 E., S. 1. B. 1 M.
 PT. LOT 2, BLK. 1, PLAT C, HUNTSVILLE SURVEY

SURVEY DATE: 7-10-93