DRAWING NUMBER
000914
PLAN HOLD CORPORATION • IRVINE, CALIFORNIA
REORDER BY NUMBER D-75AP
POSITION EDGE OF PRINT ON THIS LINE

DRAWING NUMBER
000914
PLAN HOLD CORPORATION • IRVINE, CALIFORNIA
REORDER BY NUMBER D-75AP
POSITION EDGE OF PRINT ON THIS LINE

DRAWING NUMBER
000914
PLAN HOLD CORPORATION • IRVINE, CALIFORNIA
REORDER BY NUMBER D-75AP
POSITION EDGE OF PRINT ON THIS LINE

DRAWING NUMBER
000914
PLAN HOLD CORPORATION • IRVINE, CALIFORNIA
REORDER BY NUMBER D-75AP
POSITION EDGE OF PRINT ON THIS LINE

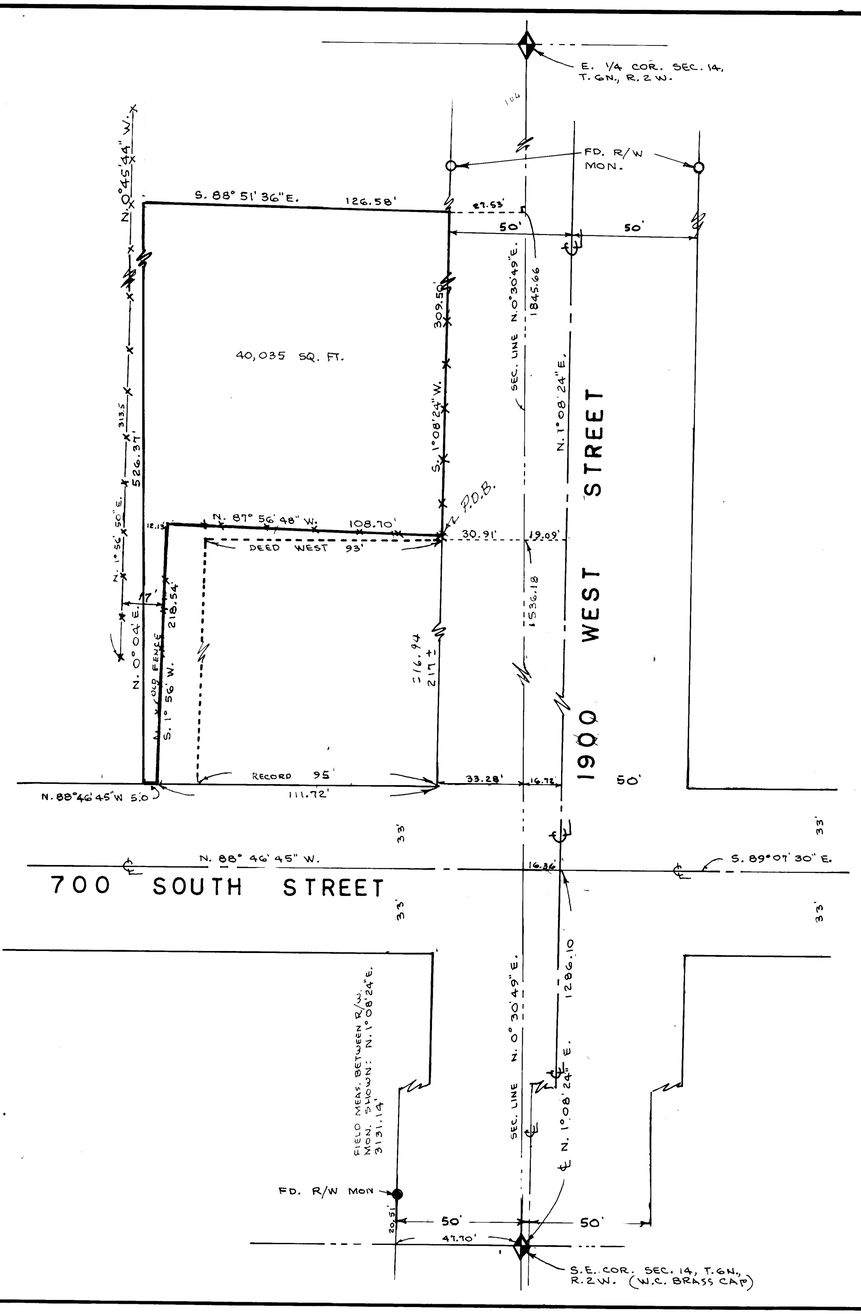

SCALE 1" = 30'

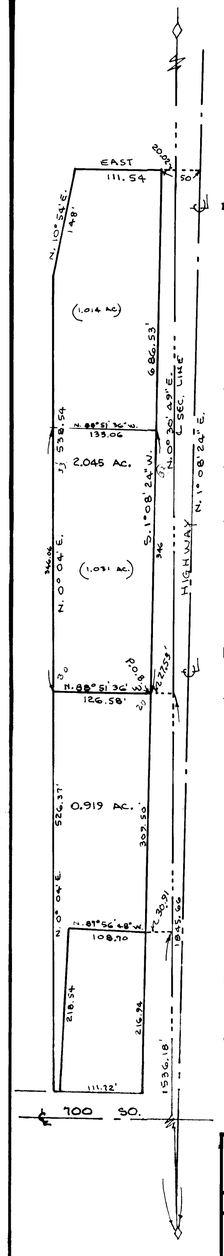

SURVEYORS CERTIFICATE

I, Larry M. Buttars, a registered Land Surveyor as prescribed by the laws of the State of Utah, and holding licence No. 2596 do hereby certify that I made a survey of the below described property and the Plat hereon is a true and correct representation of said survey.

Date: 6-18-93 Sign: [signature]

REGISTERED LAND SURVEYOR LARRY M. BUTTARS No. 2596 STATE OF UTAH

DESCRIPTION

Part of the S.E. Quarter of Section 14, T. 6N., R. 2 W., S.L.B.&M., U.S. Survey: Beginning at a point on the West line of 1900 West St. (State Road) N. 0° 30' 49" E. along the section line 1536.18 ft. and N. 89° 29' 11" W. 30.91 ft. from the S.E. corner of said Sec. 14, and running thence N. 87° 56' 48" W. along an existing fence and fence line extended 108.70 ft., thence S. 1° 56' W. along an old fence line extended 218.54 ft. to the North line of 700 South St. at a point 111.72 ft. from the West line of 1900 West St., thence N. 88° 46' 45" W. along North line of 700 South St. 5.0 ft., thence N. 0° 04' E. 526.37 ft., thence S. 88° 51' 36" E. 126.58 ft. to the West line of 1900 West St., thence S. 1° 08' 24" W. along said West line of 1900 West St. 309.50 ft. to the point of beginning.

Contains 40,035 Sq. ft.

NARRATIVE

The purpose of this Survey was to divide out a parcel from the parent tract for the sale of an existing home.

Basis of bearings is the East line of the S.E. 1/4 of Sec. 14, N. 0° 30' 49" E. State plane grid.

LEGEND

o Set 3/8" x 24" re-bar with plastic cap stamped L. Buttars R.L.S. 2596

• Set P.K. nail with ribbon

BUTTARS SURVEYING 1815 26TH STREET OGDEN, UT. 84401 PHONE 392-5291	
CLIENT: JERRY STANGER	
SURVEY LOCATION: S.E. 1/4 OF SEC. 14, T. 6N., R. 2W., S.L.B.&M. WEBER COUNTY, UTAH	
SURVEY DATE: 6-11-93	