


SURVEYORS CERTIFICATE

I, Larry M. Buttars, a registered Land Surveyor as prescribed by the laws of the State of Utah, and holding licence No. 2596, do hereby certify that I made a survey of the below described property and the Plat hereon is a true and correct representation of said survey.

Date: 5-4-93 Sign: *Larry M. Buttars*

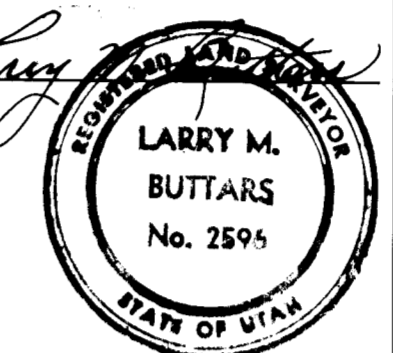

DESCRIPTION

All of Lot 4, Block 15, Nob Hill Annex to Ogden City, Weber County, Utah.

NARRATIVE

The purpose of this Survey was to establish the location of the rock retaining wall on the East line of property. Ogden City Platted bearings were used for this Survey.

LEGEND

- Set 3/4" x 24" re-bar with plastic cap stamped L. Buttars R.L.S. 2596
- Set P.K. nail with ribbon

RECEIVED

05/20/1993

Weber County Surveyor

BUTTARS SURVEYING
 1815 26th STREET OGDEN, UT. 84401
 PHONE 392-5291

CLIENT: THERESA BIRD

SURVEY LOCATION:
 N.E. 1/4, SEC. 34, T.6N, R.1W, S.L.B.#M.
 BLOCK 15, NOB HILL ANNEX TO
 OGDEN CITY, WEBER COUNTY, UTAH

SURVEY DATE: 5-3-93