


SURVEYOR'S CERTIFICATE

I, Larry M. Buttars, a registered Land Surveyor as prescribed by the laws of the State of Utah, and holding licence No. 2596, do hereby certify that I made a survey of the below described property and the plat hereon is a true and correct representation of said survey.

Date 7-18-88 Sign. *Larry M. Buttars*

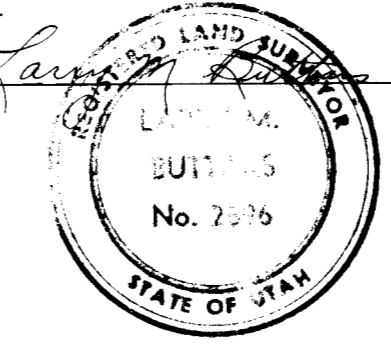

DESCRIPTION

A part of the N.E. Quarter of Section 29, T. 7N, R. 1E, S.L.B.#M, U.S. Survey: Beginning at a point S. 0°05'22" W. 1138.5 ft. along the 1/4 Section line, S. 89°54'38" E. 246.20 ft., and S. 0°05'22" W. 313.46 ft. from the N.W. corner of the N.E. Quarter of said section 29, and running thence S. 0°05'22" W. 261.86 ft., thence S. 88°00' E. 364.30 ft., thence N. 0°05'22" E. 261.86 ft. to the Point of Beginning. contains 2.19 ACRES

NARRATIVE

THE PURPOSE OF THIS SURVEY WAS TO SPLIT A TRACT OF LAND BETWEEN THREE OWNERS.
 Basis of bearings: North line of 1/4 Sec. S. 89°21'57" E. and West line of N.E. 1/4 Section S. 0°05'22" W. (Weber Co. records)

LEGEND

- Set 1/2" x 24" re-bar with plastic cap stamped L. Buttars R.L.S. 2596
- Set P.K. nail with ribbon
- x— Existing fence RECEIVED

BUTTARS SURVEYING
 1815 26th STREET OGDEN, UT. 84401
 PHONE 592-5291

CLIENT: JOHN A. MONTGOMERY

SURVEY LOCATION:
 N.E. 1/4 SEC. 29, T. 7N, R. 1E.
 WEBER COUNTY, UT.

SURVEY DATE: 6-26-88 **000919**