


NOTE:  

I, MARTIN R. MOORE JR., UTAH REGISTERED LAND SURVEYOR NO. 3364 DO HEREBY CERTIFY THAT THIS PLAT AND THE SURVEY FROM WHICH IT WAS DERIVED WERE MADE IN ACCORDANCE WITH THE REQUIREMENTS OF THE UTAH PROFESSIONAL LAND SURVEYORS ACT AND IN BEHALF OF THE MOUNTAIN WEST PROFESSIONAL LAND SURVEYORS P.C. AND IS TRUE AND CORRECT TO THE BEST OF MY KNOWLEDGE AND BELIEF.

MARTIN R. MOORE JR., P. L. S.

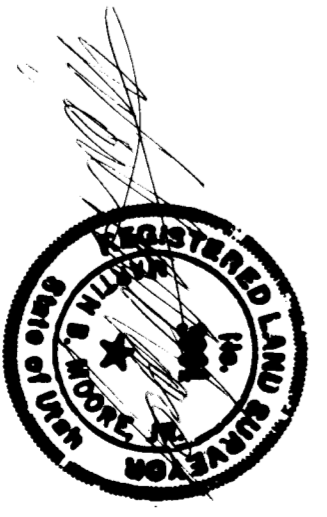

DESCRIPTION OF SURVEY  
(SEE NARRATIVE)

THE PURPOSE OF THIS SURVEY TO MONUMENT THE BEUS HILLS AREA IN POSITIONS WHICH ARE HARMONIOUS WITH THE MAJORITY OF EXISTING POSITIONS, AS WELL AS BEING IN RELATIONSHIP WITH THE DESIGNATED STREETS, THIS VERTICAL NIGHTMARE WAS NOT A SIMPLE TASK. OUR INITIAL CONTROL NETWORK FOR THE MOST PART THEY WOULD FIT A PATTERN WHICH WAS GENERALLY WITHIN A RADIAL AREA OF ABOUT 0.4 FEET. THERE WERE A FEW CURB WALLS HOWEVER WHICH HAD OBVIOUSLY BEEN SET IN PLACE BY AN EARLIER SURVEYOR. THESE WALLS WHICH TO BE AND THERE WERE A COUPLE OF WALLS AND ONE FENCE LINE WHICH WERE IN OBVIOUS BLUNDER AND WERE COMPLETELY IGNORED. WHERE GENERALLY PAIRS SHOWN ON THE PLAT THESE STAMPEDESTONES OF THE BEUS HILLS AREA, AND WERE PROVIDED BY WEBER COUNTY SURVEYORS OFFICE. IN A CONVERSION FACTOR OF 1.000265987 MULTIPLIED TO THE ENTIRE PROJECT SUITABLE FOR PROPERTY SUBDIVISION, THERE WILL BE VERY LITTLE CORRECTION NEEDED FOR THE MAJORITY OF THE AREA FROM THE ORIGINAL PLATS. IN AREAS WHERE THIS CONTROL HAS ALREADY BEEN OCCUPATIONS. THERE IS A HARMONIOUS RELATIONSHIP WITH EXISTING

**RECORD OF SURVEY**

for  
**OGDEN CITY**  
(BEUS HILLS MONUMENTS)

Located in the Northeast One-Quarter of Section 10,  
Township 5 North, Range 1 West, Salt Lake Meridian

MOUNTAIN WEST PROFESSIONAL LAND SURVEYORS P.C.  

RECEIVED  
DEC 28 1993  
