


DAN WRIGHT SUBDIVISION


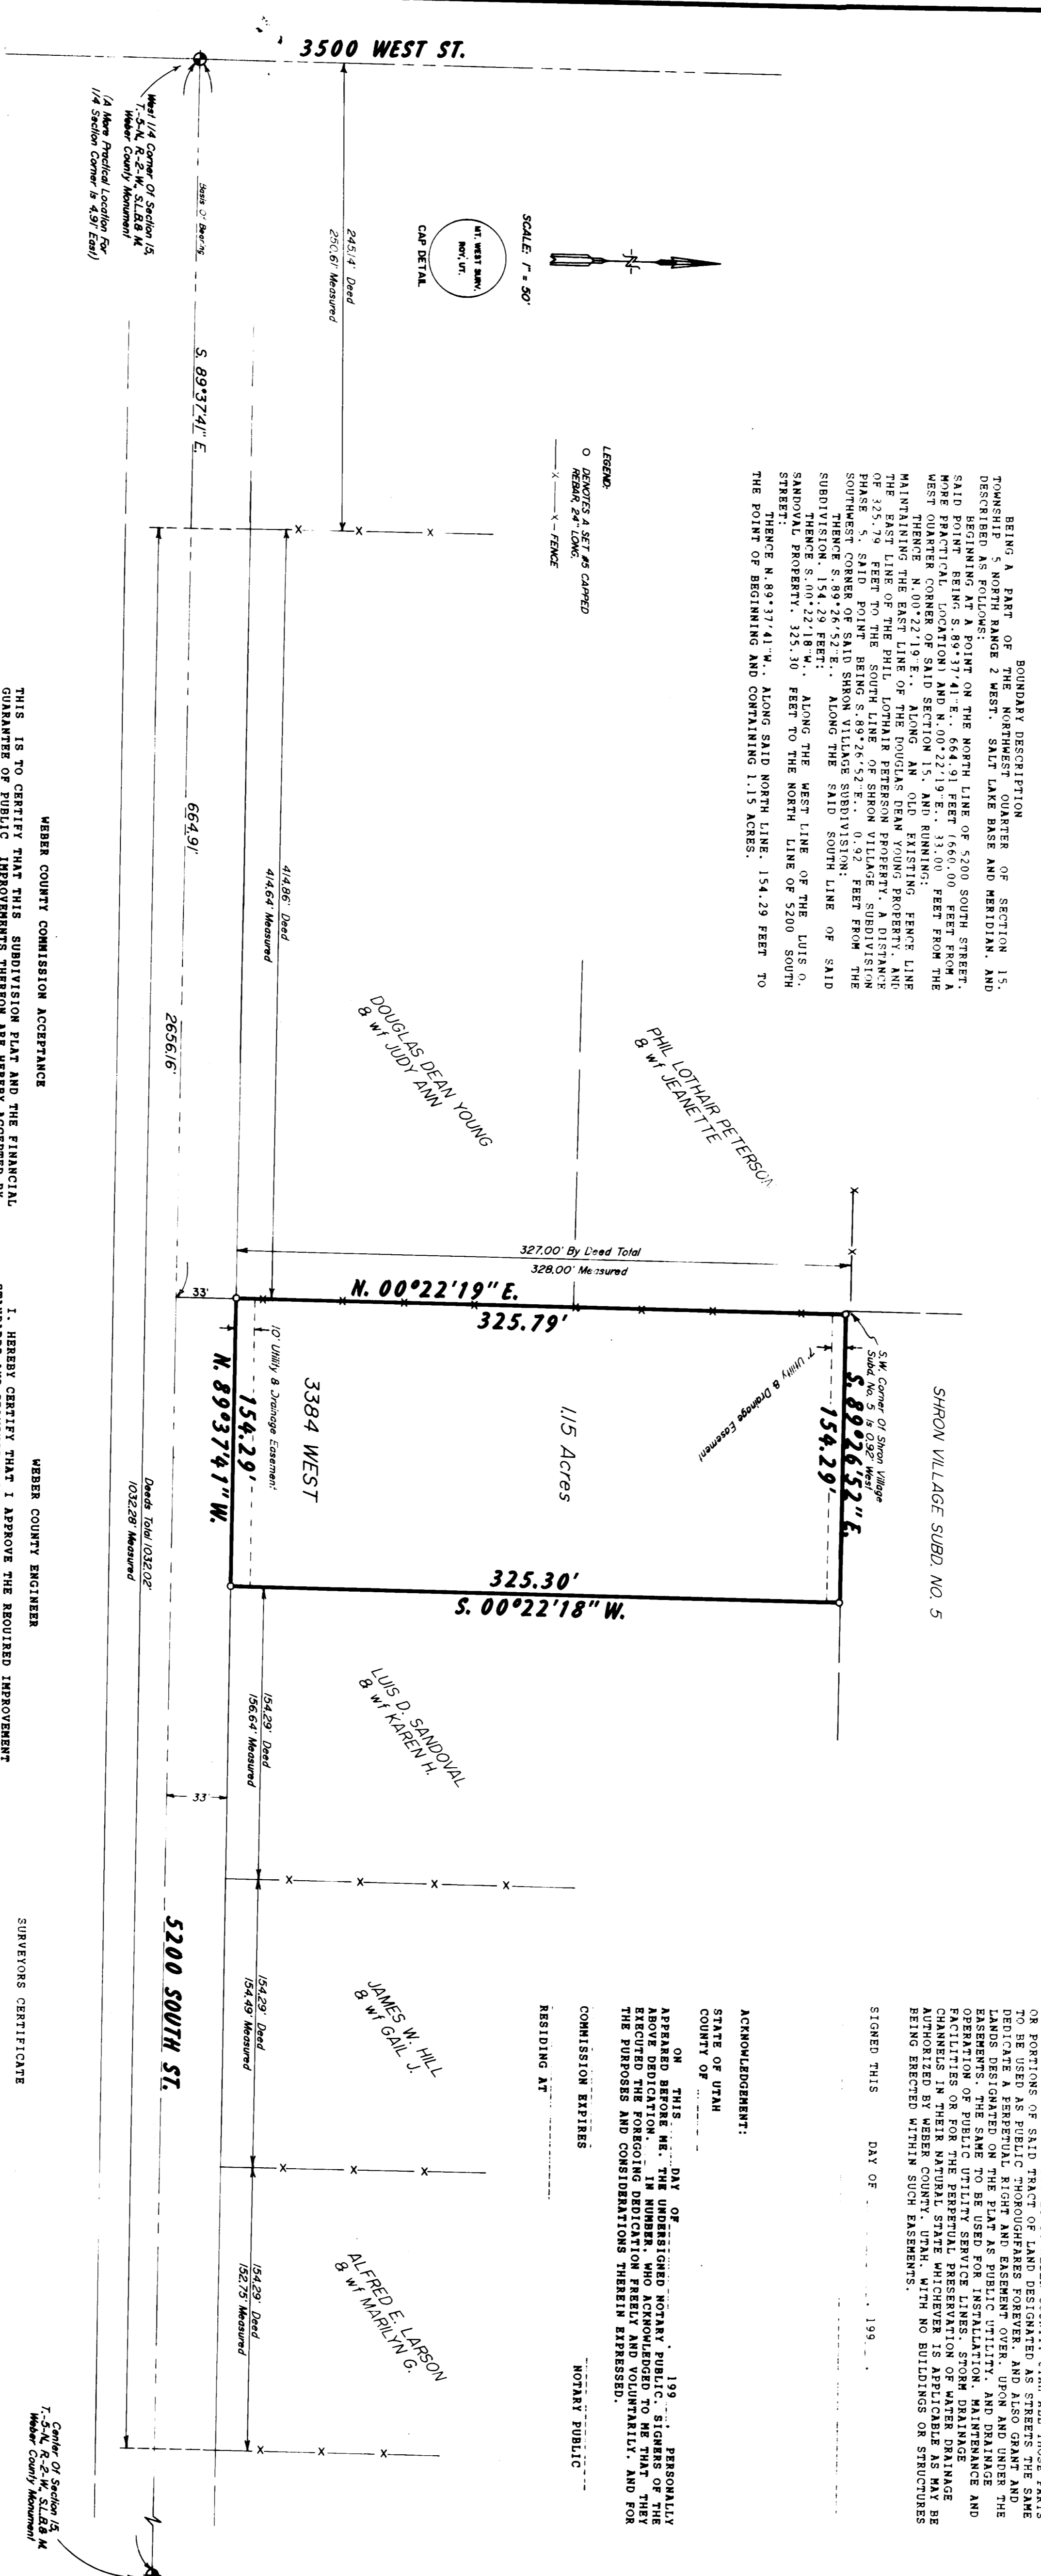


WE, THE UNDERSIGNED OWNERS OF THE HEREON DESCRIBED TRACT OF LAND, DO HEREBY SET ASIDE OUR INTERESTS IN SAID TRACT OF LAND TO BE USED AS PUBLIC THROUGHFARE FOREVER, AND ALSO GRANT AND CONVEY TO THE PUBLIC THE RIGHT OF WAY FOR THE INSTALLATION, MAINTENANCE AND OPERATION OF PUBLIC UTILITIES FOR THE PERPETUAL PRESERVATION OF WATER DRAINAGE FACILITIES FOR THE PERPETUAL PRESERVATION OF WATER DRAINAGE AUTHORIZED BY WEBER COUNTY, UTAH, WITH NO BUILDINGS OR STRUCTURES BEING ERRECTED WITHIN SAID EASEMENTS.


WEBER COUNTY PLANNING COMMISSION APPROVAL


WEBER COUNTY ENGINEER
 I, HEREBY CERTIFY THAT I APPROVE THE REQUIRED IMPROVEMENT FINANCING AND CLAIMS FOR THIS SUBDIVISION AND THE AMOUNT OF THE COMMISSIONS FOR THESE IMPROVEMENTS.

SURVEYOR'S CERTIFICATE
 I, MARTIN B. MOORE JR., UTAH REGISTERED LAND SURVEYOR NO. 3964, HAVE EXAMINED THE ORIGINAL SURVEY RECORDS AND THE SUBDIVISION WAS PREPARED FROM A SURVEY OF LAND WHICH WAS MADE BY ME OR UNDER MY CLOSE PERSONAL SUPERVISION AND IS TRUE AND CORRECT TO THE BEST OF MY KNOWLEDGE AND BELIEF.


CHAIRMAN, WEBER COUNTY PLANNING COMMISSION



MARTIN B. MOORE JR., NO. 3964
 REGISTERED LAND SURVEYOR

COUNTY RECORDER
 Entry no. _____ Fee paid _____
 recorded _____
 in book _____ of official records, page _____
 County Recorder
 By _____ Deputy

RECORD OF SURVEY
 for
BOB TAYLOR
 Date: 3/20/92 No. 32-2044
 REC'D
 DEC 8 1993
 WEBER COUNTY SURVEYOR