


OWNERSHIP OF DOCUMENTS: This document and the ideas and designs incorporated herein, as a instrument of professional service, is the property of Ensign Engineering and Land Surveying, Inc. and is not to be used, in whole or in part, for any other project without the written authorization of Ensign Engineering and Land Surveying, Inc.

This drawing is the property of Ensign Engineering and Land Surveying, Inc. All rights to the design shown in the drawing, including the right to protection thereof by patent or otherwise, are reserved by Ensign Engineering and Land Surveying, Inc. The drawing must not be copied or its contents made known or available to third parties without the prior written consent of Ensign Engineering and Land Surveying, Inc. It must be promptly returned to Ensign Engineering and Land Surveying, Inc. on request.

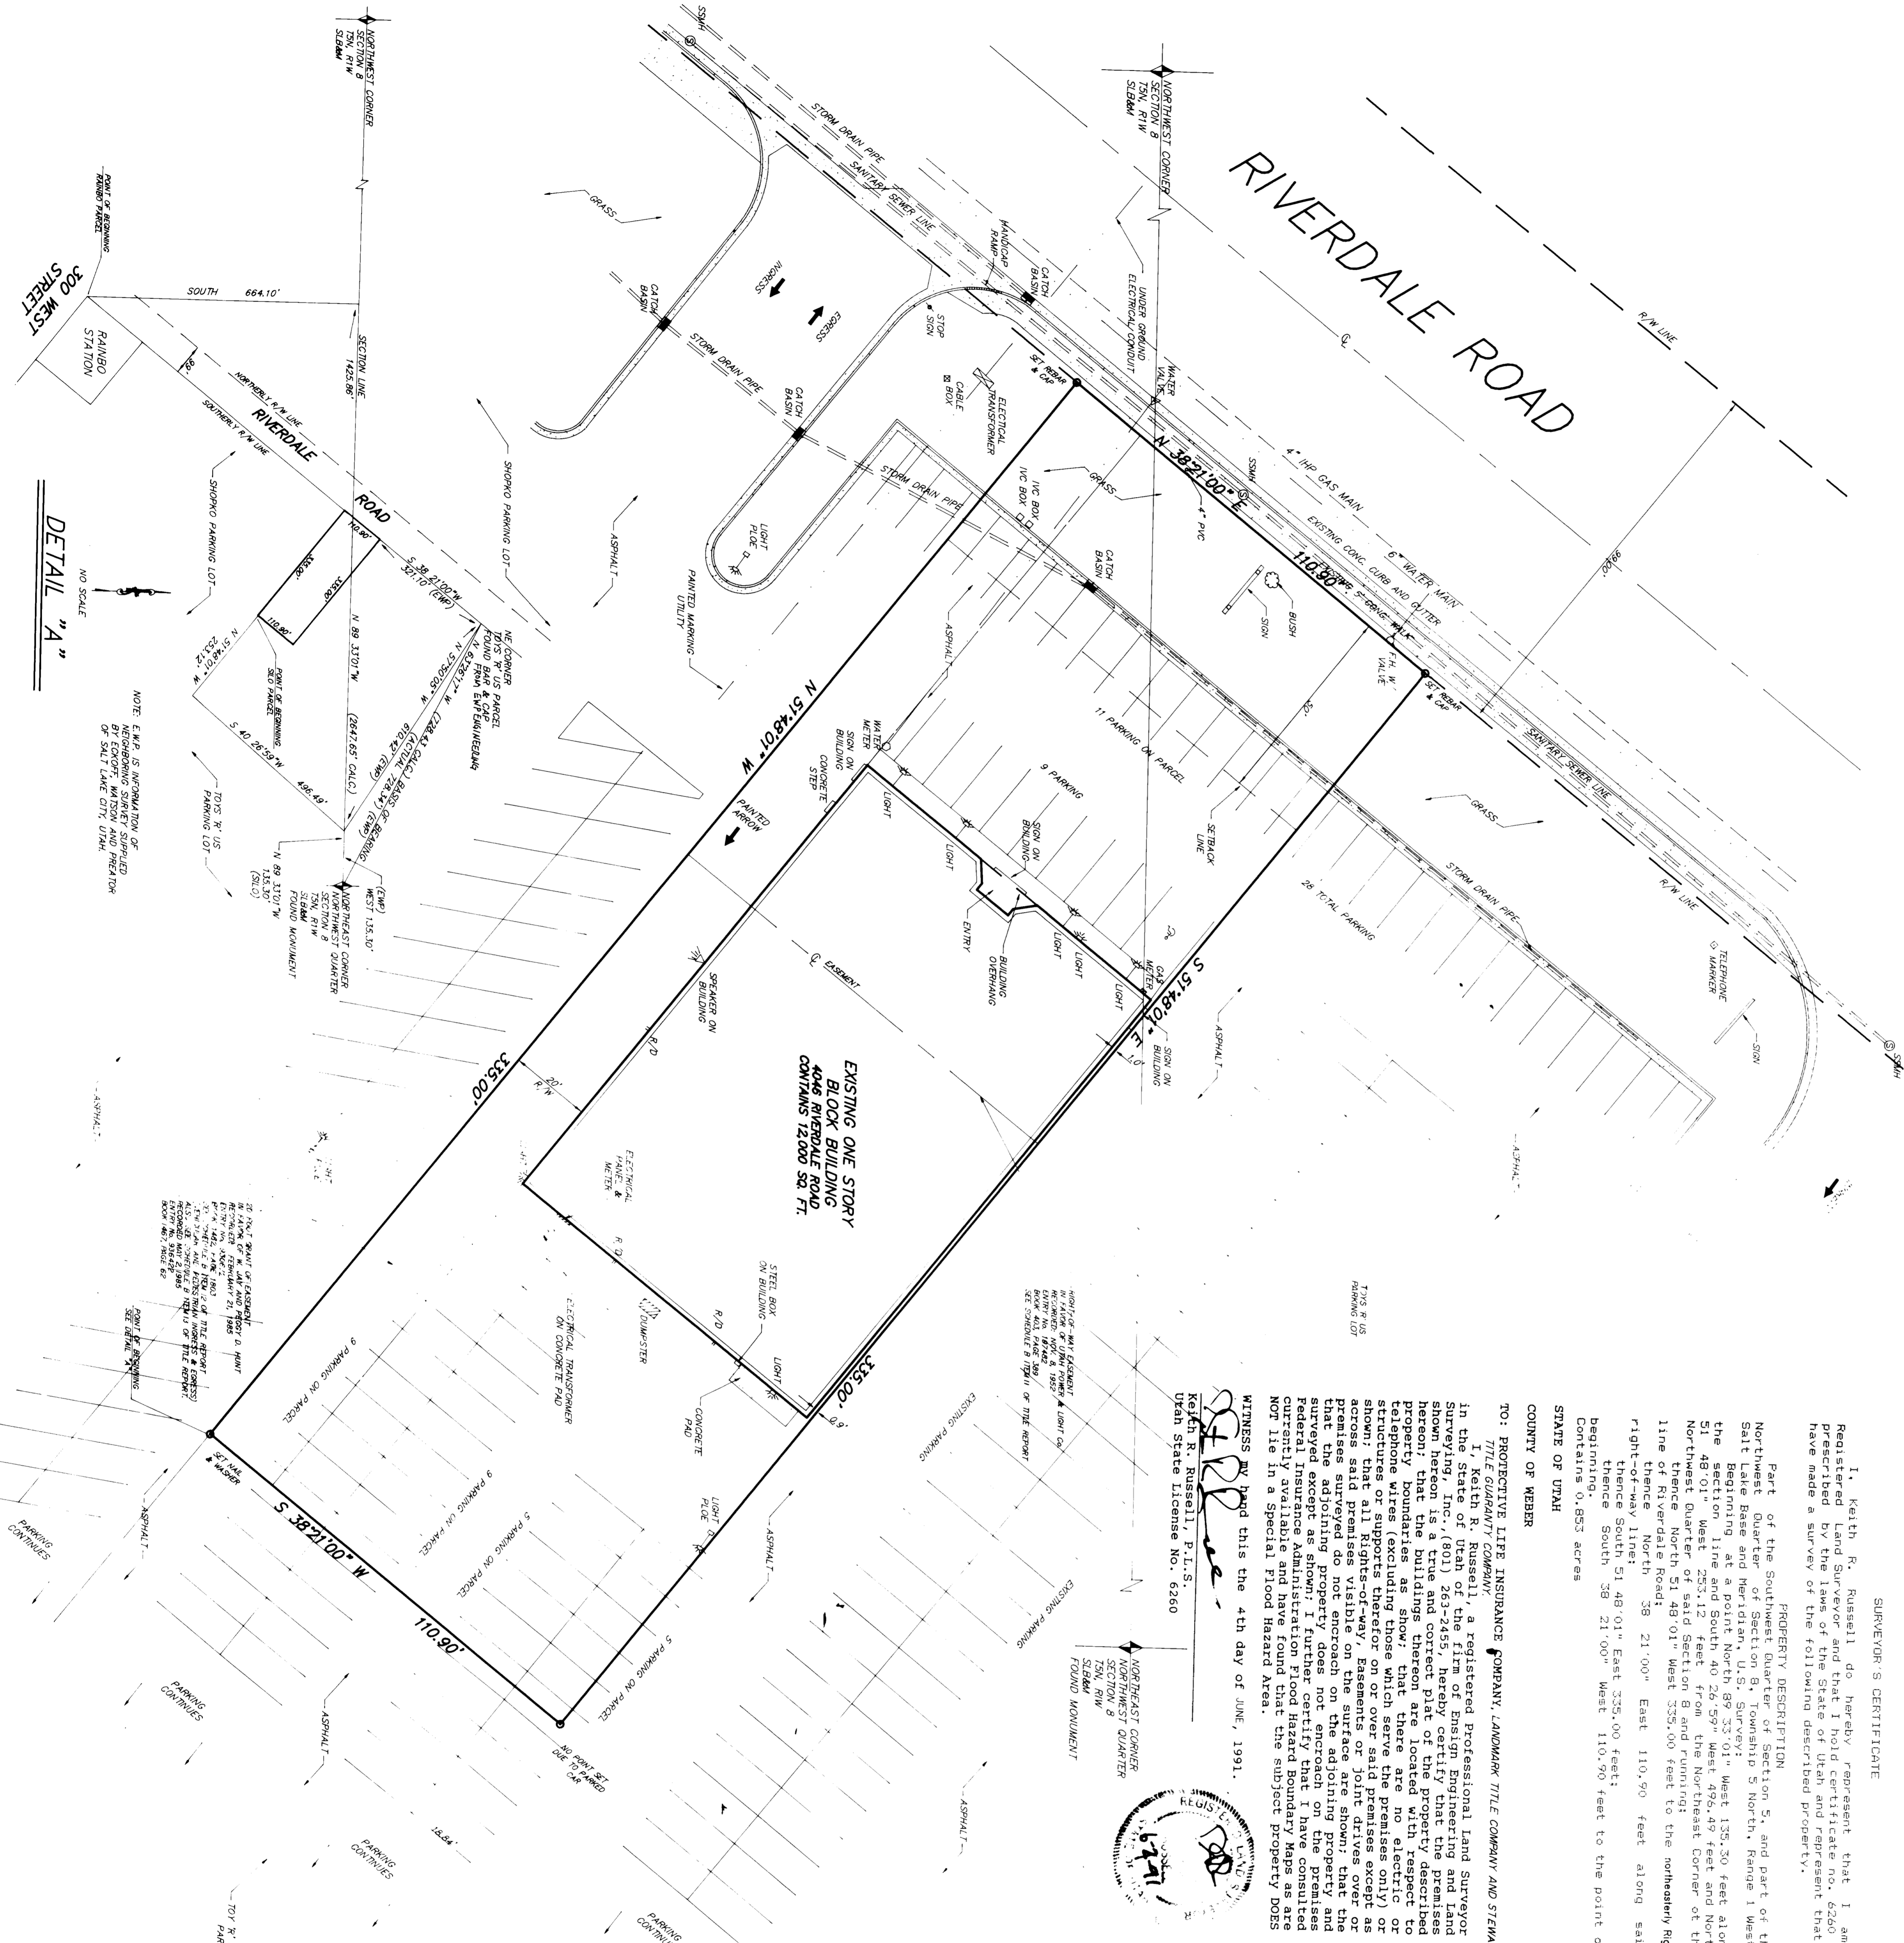

DETAIL "A"
NO SCALE

TO: PROTECTIVE LIFE INSURANCE COMPANY, LANDMARK TILE COMPANY AND STEWART TILE COMPANY
In the State of Utah, I, a Registered Professional Land Surveyor, Keith F. Russell, (No. 6260) hereby certify that the above described parcel is a true and correct plat of the property described hereon as shown thereon and located with respect to property boundaries as shown thereon and located with respect to telephone wires (excluding those which serve the premises or shown) that supports thereon or over said premises except as across said premises visible on the plats or joint drives over or across said premises do not encroach on the adjoining property and the survey was made on the ground and that the plat has been filed with the Federal Insurance Administration Flood Hazard Map and is not shown in a Special Flood Hazard Area.



PROPERTY DESCRIPTION


RECEIVED
JUN 12 1994
THIS SURVEY IS LOCATED IN THE SOUTHWEST QUARTER OF SECTION 5 AND THE NORTHWEST QUARTER OF SECTION 8 TOWNSHIP 5 NORTH, RANGE 1 WEST SALT LAKE BASE AND MERIDIAN

NOTES:
1) SCHEDULE B ITEM 4 REFERS TO A COPIES EASEMENT AGREEMENT. THE AGREEMENT ADDRESSES A NUMBER OF CONDITIONS AND EASEMENTS WHICH AFFECT THIS SPECIFICALLY DESCRIBED PARCEL.
2) ALL ACCESS FOR VEHICULAR TRAFFIC (WALKERS AND GESS) IS FROM EXISTING CURB RIVERDALE ROAD. THE VEHICLES MUST CROSS OVERHEAD REFERRED TO IN NOTE 1 ALONG WITH THE REVERSE SIDE CROSS OVERHEAD REFERRED TO IN NOTE 2.
3) REMOVALS WERE TAKEN FROM A PREVIOUS SURVEY WHICH MATTERS THE RIVERDALE CROWN BASIN ENGINEERING, INC. OF OGDEN, UTAH DRAWING NO. 79-50-44.
4) THE PARCEL IS LOCATED IN A ZONE "C" OF THE FIRM MAPS. PARCEL NO. 08019000000.
5) UNDERGROUND UTILITIES ARE SHOWN FROM RELATED MAPS AND HAVE NOT BE INDEPENDENTLY VERIFIED.
6) THE ZONE IS A C-3 WITH A 50 FOOT FRONT SETBACK AND ALL OTHER REQUIREMENTS OR ORDINANCE.
7) ITEM B-10 OF THE TITLE REPORT REFERS TO A RIGHT-OF-WAY EASEMENT (NOTH) NOT WITH ORIGINAL KNOW AND DESCRIBED BY INSPECTION.

LEGEND
SANTARY SEWER MANHOLE
SANTARY SEWER LINE
STORM DRAIN LINE
CATCH BASIN
WATER METER
WATER VALVE
LIGHT POLE
LIGHT ON BUILDING
IMMEDIATION CONTROL VALVE BOX
SPRINKLER BUILDING
SPRINKLER

GRAPHIC SCALE
1 inch = 20 ft

ENSIGN ENGINEERING AND LAND SURVEYING
4455 SOUTH 700 EAST SUITE 202 (801) 263-2455
MURRAY, UTAH 84107

TITLE
ALTA/ACSM LAND TITLE SURVEY
SILO SHOWROOM
4046 RIVERDALE ROAD
OGDEN, UTAH
FOR S-DEVICORP

DESIGN	CHECK
DRAWN CO MCKINNEY	CHECK KIR RUSSELL
SCALE NOTED	DATE 91-30
NO. DATE	REVISION
6.4.91	UPDATE PER NEW TITLE REPORT

SHEET 1 OF 1