

NORTHWEST CORNER OF SLAVAN WEBER COUNTY UTAH
 EAST - DEED (S 89° 05' 00\"/>

SCALE
 1\"/>


- ABSTRACT
1. The client needed a survey certificate for a pending sale of the property.
 2. The basis for the survey was Weber County Surveyors Datum.

SURVEYORS' CERTIFICATE

I, ROBERT B. JONES, DO HEREBY CERTIFY THAT I AM A REGISTERED LAND SURVEYOR AND THAT I HOLD LICENSE NO. 1529, AS DESCRIBED BY THE SECTION LINE (S 89° 05' 00\"/>

DATE: 9/24/88
 ROBERT B. JONES
 LICENSE NO. 1529

NOTE: AT THE TIME OF THIS SURVEY, THERE WAS APPROXIMATELY 20' OF THE VISIBLE IMPROVEMENTS ON THE ABOVE DESCRIBED PREMISES ENDOACH UPON ADJOINING PROPERTIES AND THAT NO VISIBLE IMPROVEMENTS, FENCES OR EAVES OF ADJOINING PROPERTIES ENDOACH UPON THE ABOVE DESCRIBED PROPERTY, EXCEPT AS SHOWN.

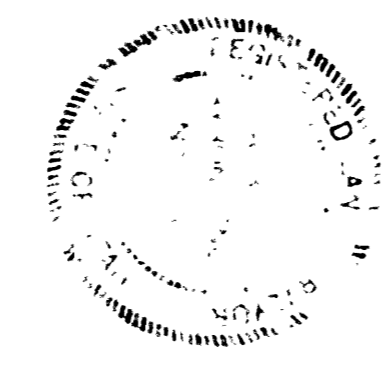

RECEIVED
 1-3-82

PROPERTY SURVEY
 LOCATION-NW 1/4 SECTION 28, T7N, R1E, S.L.B.B.M.
 PREPARED FOR
 COLDWELL BANKER

Drawn ERJ Date JAN. 1988
 Designer _____
 Checked _____
 Approved _____
 Scale 1\"/>

BUSH & GUDGELL, INC.
 Engineers - Planners - Surveyors
 555 South 300 East, Salt Lake City, Utah 84111
 (801) 364-1212 Offices St. George, Utah

DATE	BY	REVISION