

NORTH QUARTER CORNER OF SEC. 36,  
 TOWNSHIP 6 NORTH, RANGE 2 WEST,  
 WEBER COUNTY SURVEYORS BRASS CAP.

**2550**

N. 89° 28' 30" W. (264602') Meas. 2645.95'  
 1797.93'

**SOUTH**


NE CORNER SEC. 36, T. 6 N.,  
 R. 2 W., W.C. BRASS CAP.

**LEGEND**

PREPARED BY:  
**CONSTRUCTION & LAND SURVEYORS LLC**  
 OGDEN, UTAH

"ALTA / ACSM LAND TITLE SURVEY"

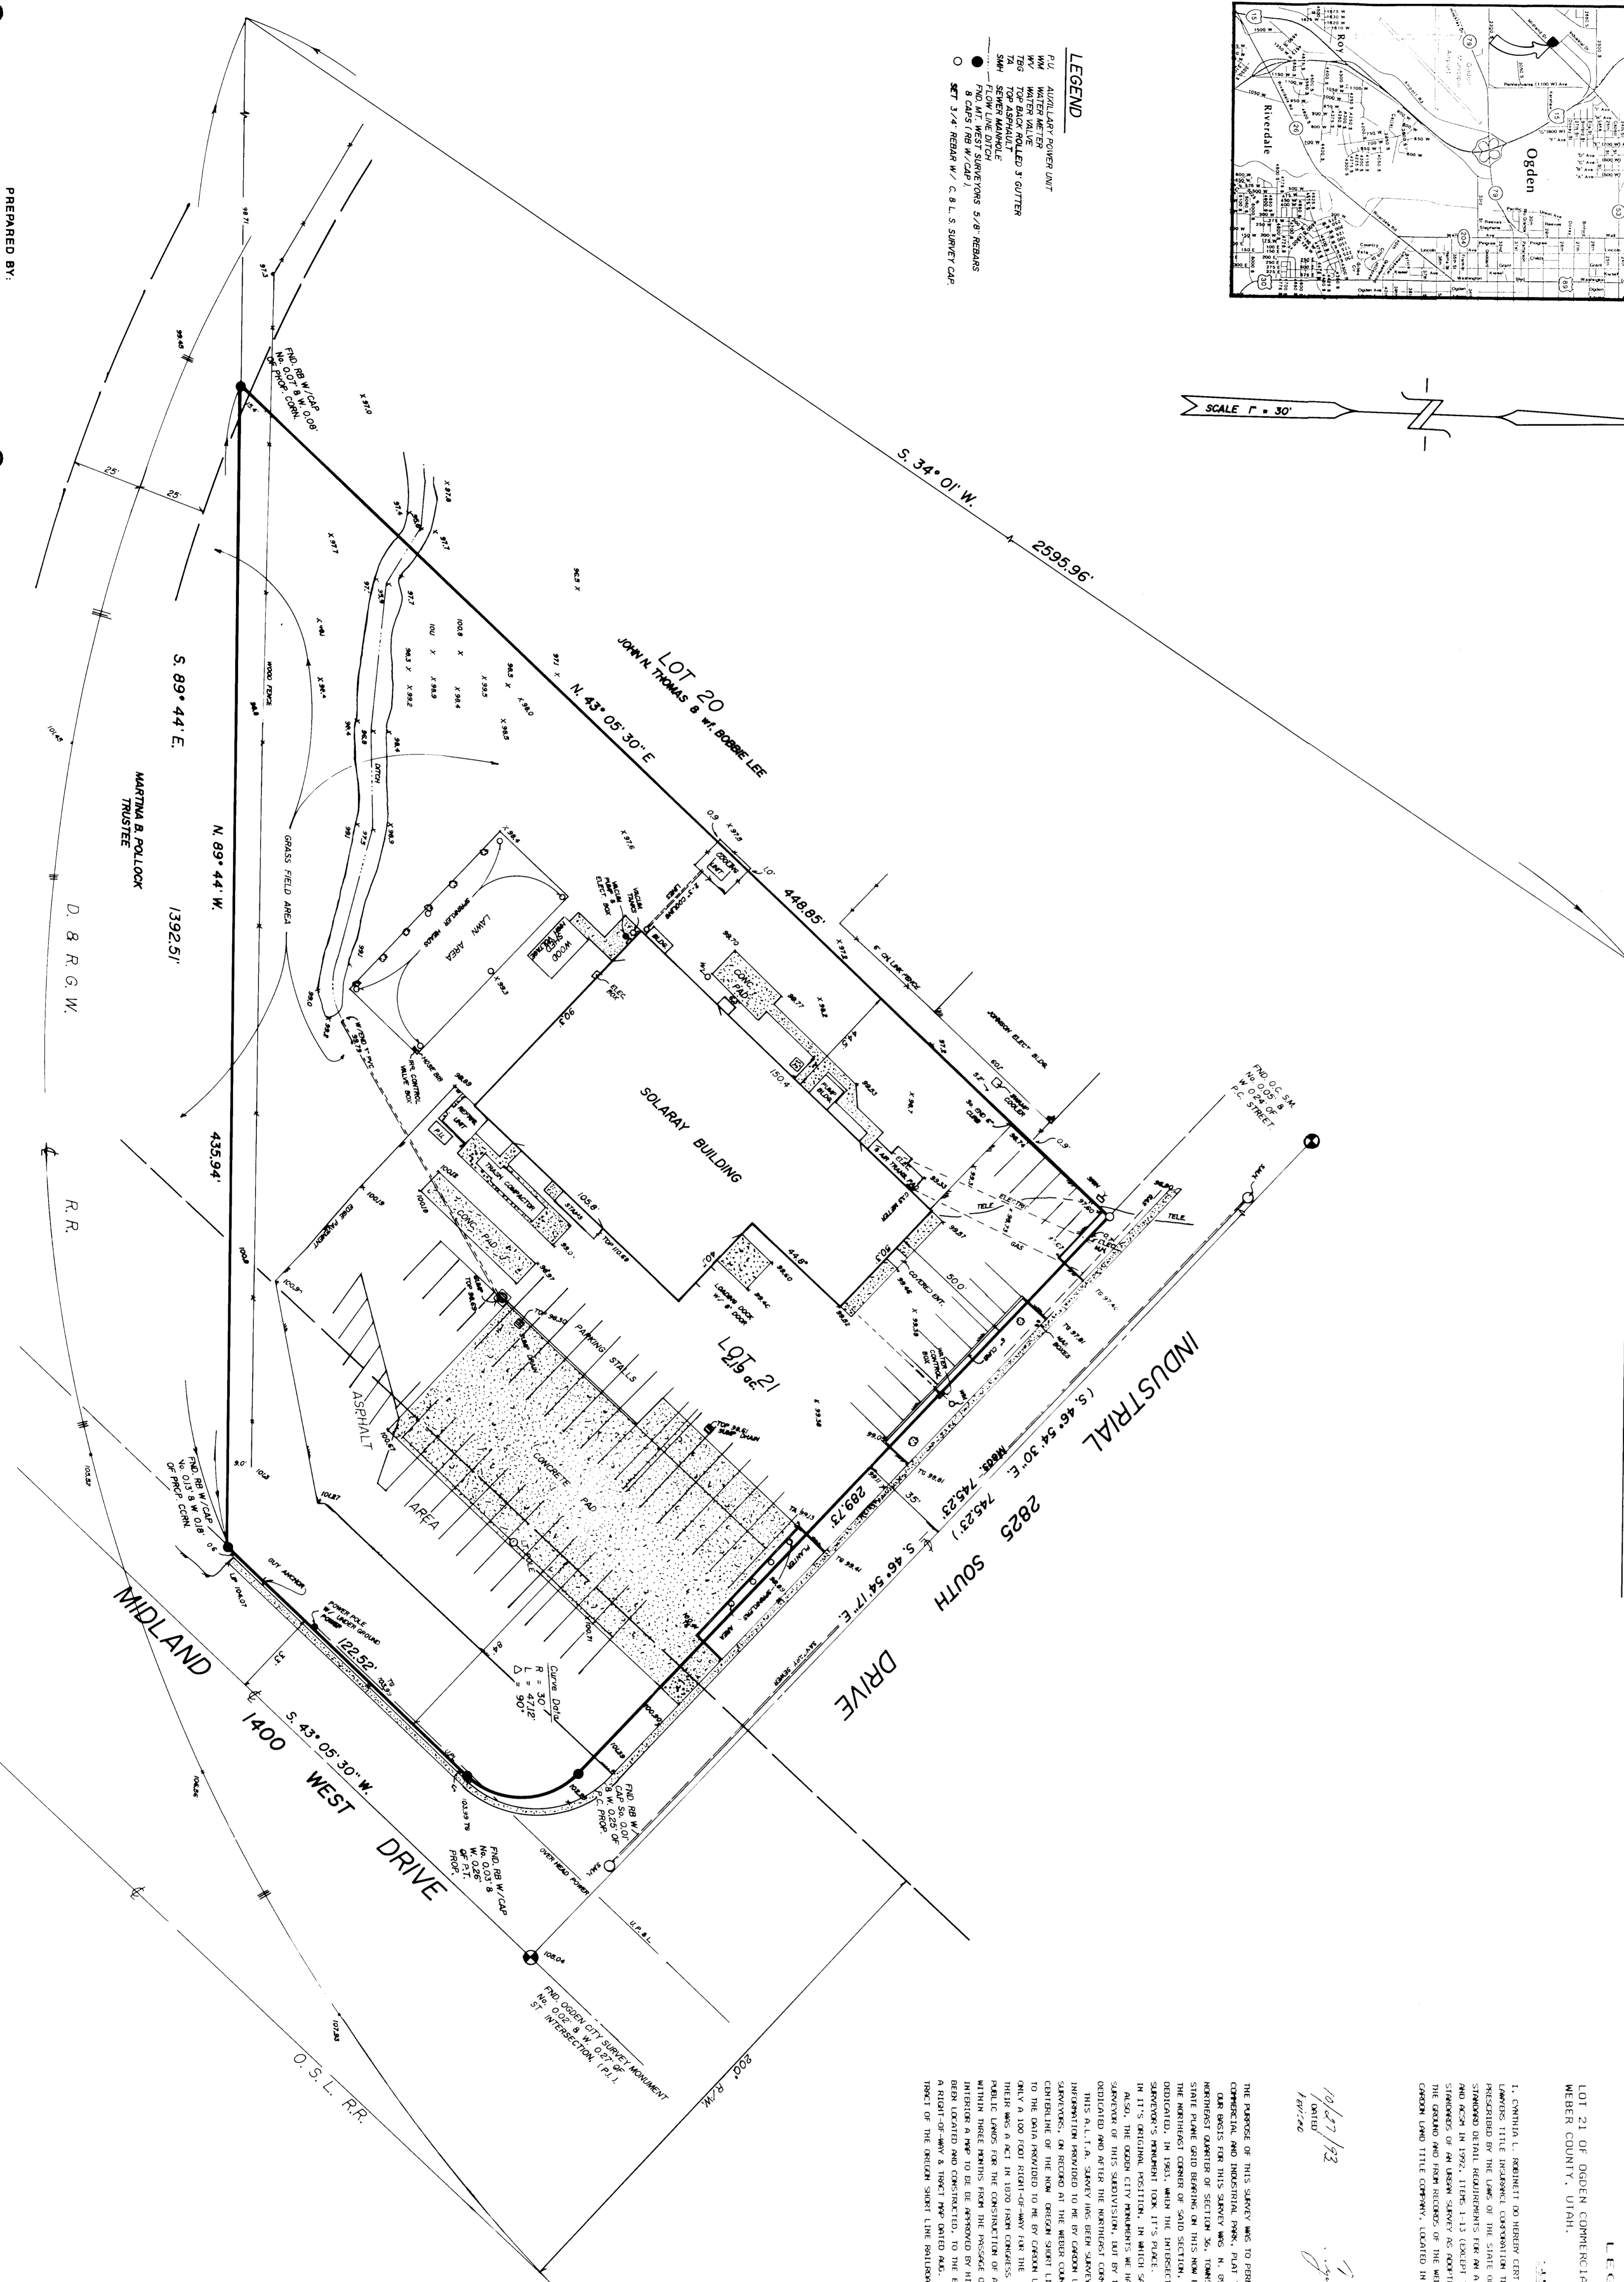

**LEGAL DESCRIPTION**

LOT 21 OF OGDEN COMMERCIAL AND INDUSTRIAL PARK, PLAT "A", IN OGDEN CITY,  
 WEBER COUNTY, UTAH.






CLIENT: SOLARAY  
 JAMES L. BECK

SURVEY LOCATION:  
 NE 1/4, SEC. 36, T. 6 N., R. 2 W.,  
 OGDEN COMMERCIAL & INDUSTRIAL PARK  
 OGDEN, UTAH 84401  

CONSTRUCTION & LAND SURVEYORS  
 2751 WASHINGTON BLVD  
 OGDEN, UTAH 84401  
 (801) 399-8000

JOB NO. P-38-140

**000970**

FEB 17 1924