


WEST QUARTER CORNER OF SEC. 30,
T. 6 N., R. 1 W., 1/4 SEC. 30,
S. 50.00' NORTH OF W. 1/4
CORNER MON. W. C.S.C. (NO. DATED)

MEMORIAL WITNESS MON.
50.00' NORTH OF W. 1/4
CORNER MON. W. C.S.C. (NO. DATED)

NORTHWEST CORNER OF SECTION 30,
T. 6 N., R. 1 W., 1/4 SEC. 30,
S. 50.00' NORTH OF W. 1/4
CORNER MON. W. C.S.C. (NO. DATED 1981)

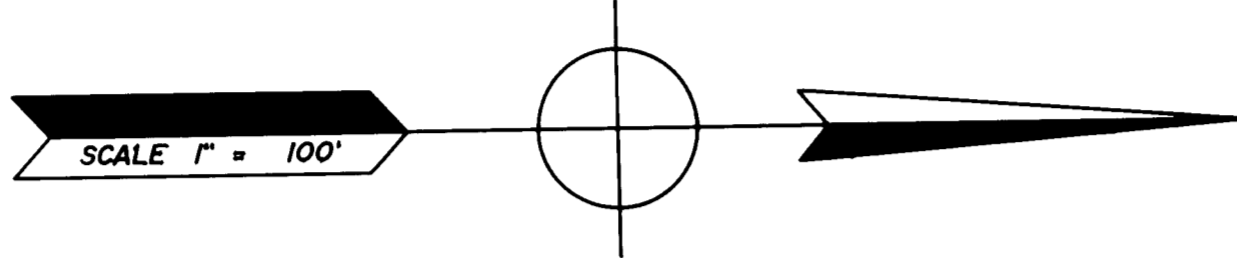


LEGEND

● P.M. 3/4\"/>

() EXISTING MONUMENTS AND POINTS
NO PAYMENT IS TO BE MADE FOR PLAT
OR RECORD BEARING TO STATE PLANE AND BEARING
POINTS SET

BOUNDARY DESCRIPTION

A PART OF THE NORTHWEST QUARTER OF SECTION 30, TOWNSHIP 6 NORTH, RANGE 1 WEST, SALT LAKE BASE AND MERIDIAN, BASIS OF BURNHAM WEST QUARTER OF SECTION 30, AS MONUMENTED, BEGINNING AT A POINT THAT BEARS S. 01° 28' 19\"/>

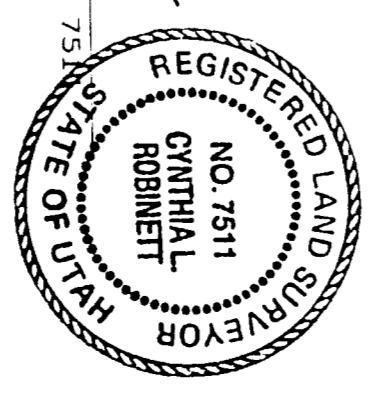

CERTIFICATE



FEB 17 1994

CLIENT:	BOYD PARKE
DATE:	MARCH 1994
SURVEY DATE:	10 / 02 / 93
JOB NO.:	P393-36