


LOT 14
5.493 Acres

LOT 15
5.492 Acres


DESCRIPTION
All of Lots 14 and 15 of South Fork Ranchettes Subdivision, according to the Official Plat thereof on file in the office of the Weber County Recorder.

CERTIFICATION
I, Jay R. Anderson, do hereby certify that I am a Registered Land Surveyor, and that I hold Certificate No. 2430, as prescribed by the Laws of the State of Utah and I have made a survey of the above described property. I further certify that this plat correctly shows the true dimensions of the property surveyed.

DATE 2-25-94
Jay R. Anderson

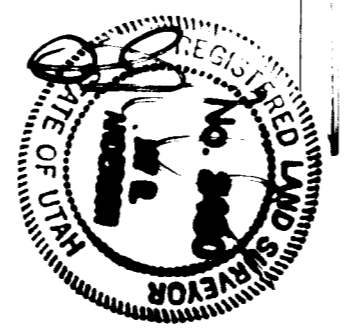

NARRATIVE
In September of 1992, Curt Williams, Owner of Lot 15 and Joe Henry, the Realtor selling Lot 14, asked for the lot corners to be relocated. No drawing was requested. Later, the new owner of Lot 14, Ben Womack, requested a drawing.

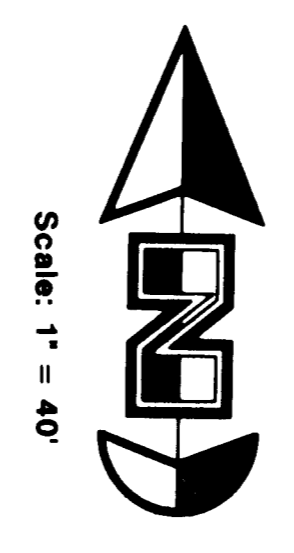

RECEIVED
MAR 01 1994
Weber County Surveyor

GREAT BASIN ENGINEERING, INC.
CONSULTING ENGINEERS
ODDEN & SALT LAKE CITY, UTAH

Property Survey
for
Bon Womack and Curt Williams
A PART OF THE NORTH 1/2 OF SEC. 15, T6N, R2E, S14W

DATE: 11/8/92
SCALE: 1" = 40'
JOB NO: PS-92-87