


NOTE:


LEGEND
● SET 3/4" BEARS W/ C.L.S. SURVEY CAP
--- EXISTING FENCES
+--- DISTANCE AND OR BEARING PER DEED OR PLAT
--- NO BEARINGS IS MEASURED DISTANCE OR POINTED PLAT OR DEED BEARING TO STATE PLANE GRID BEARING

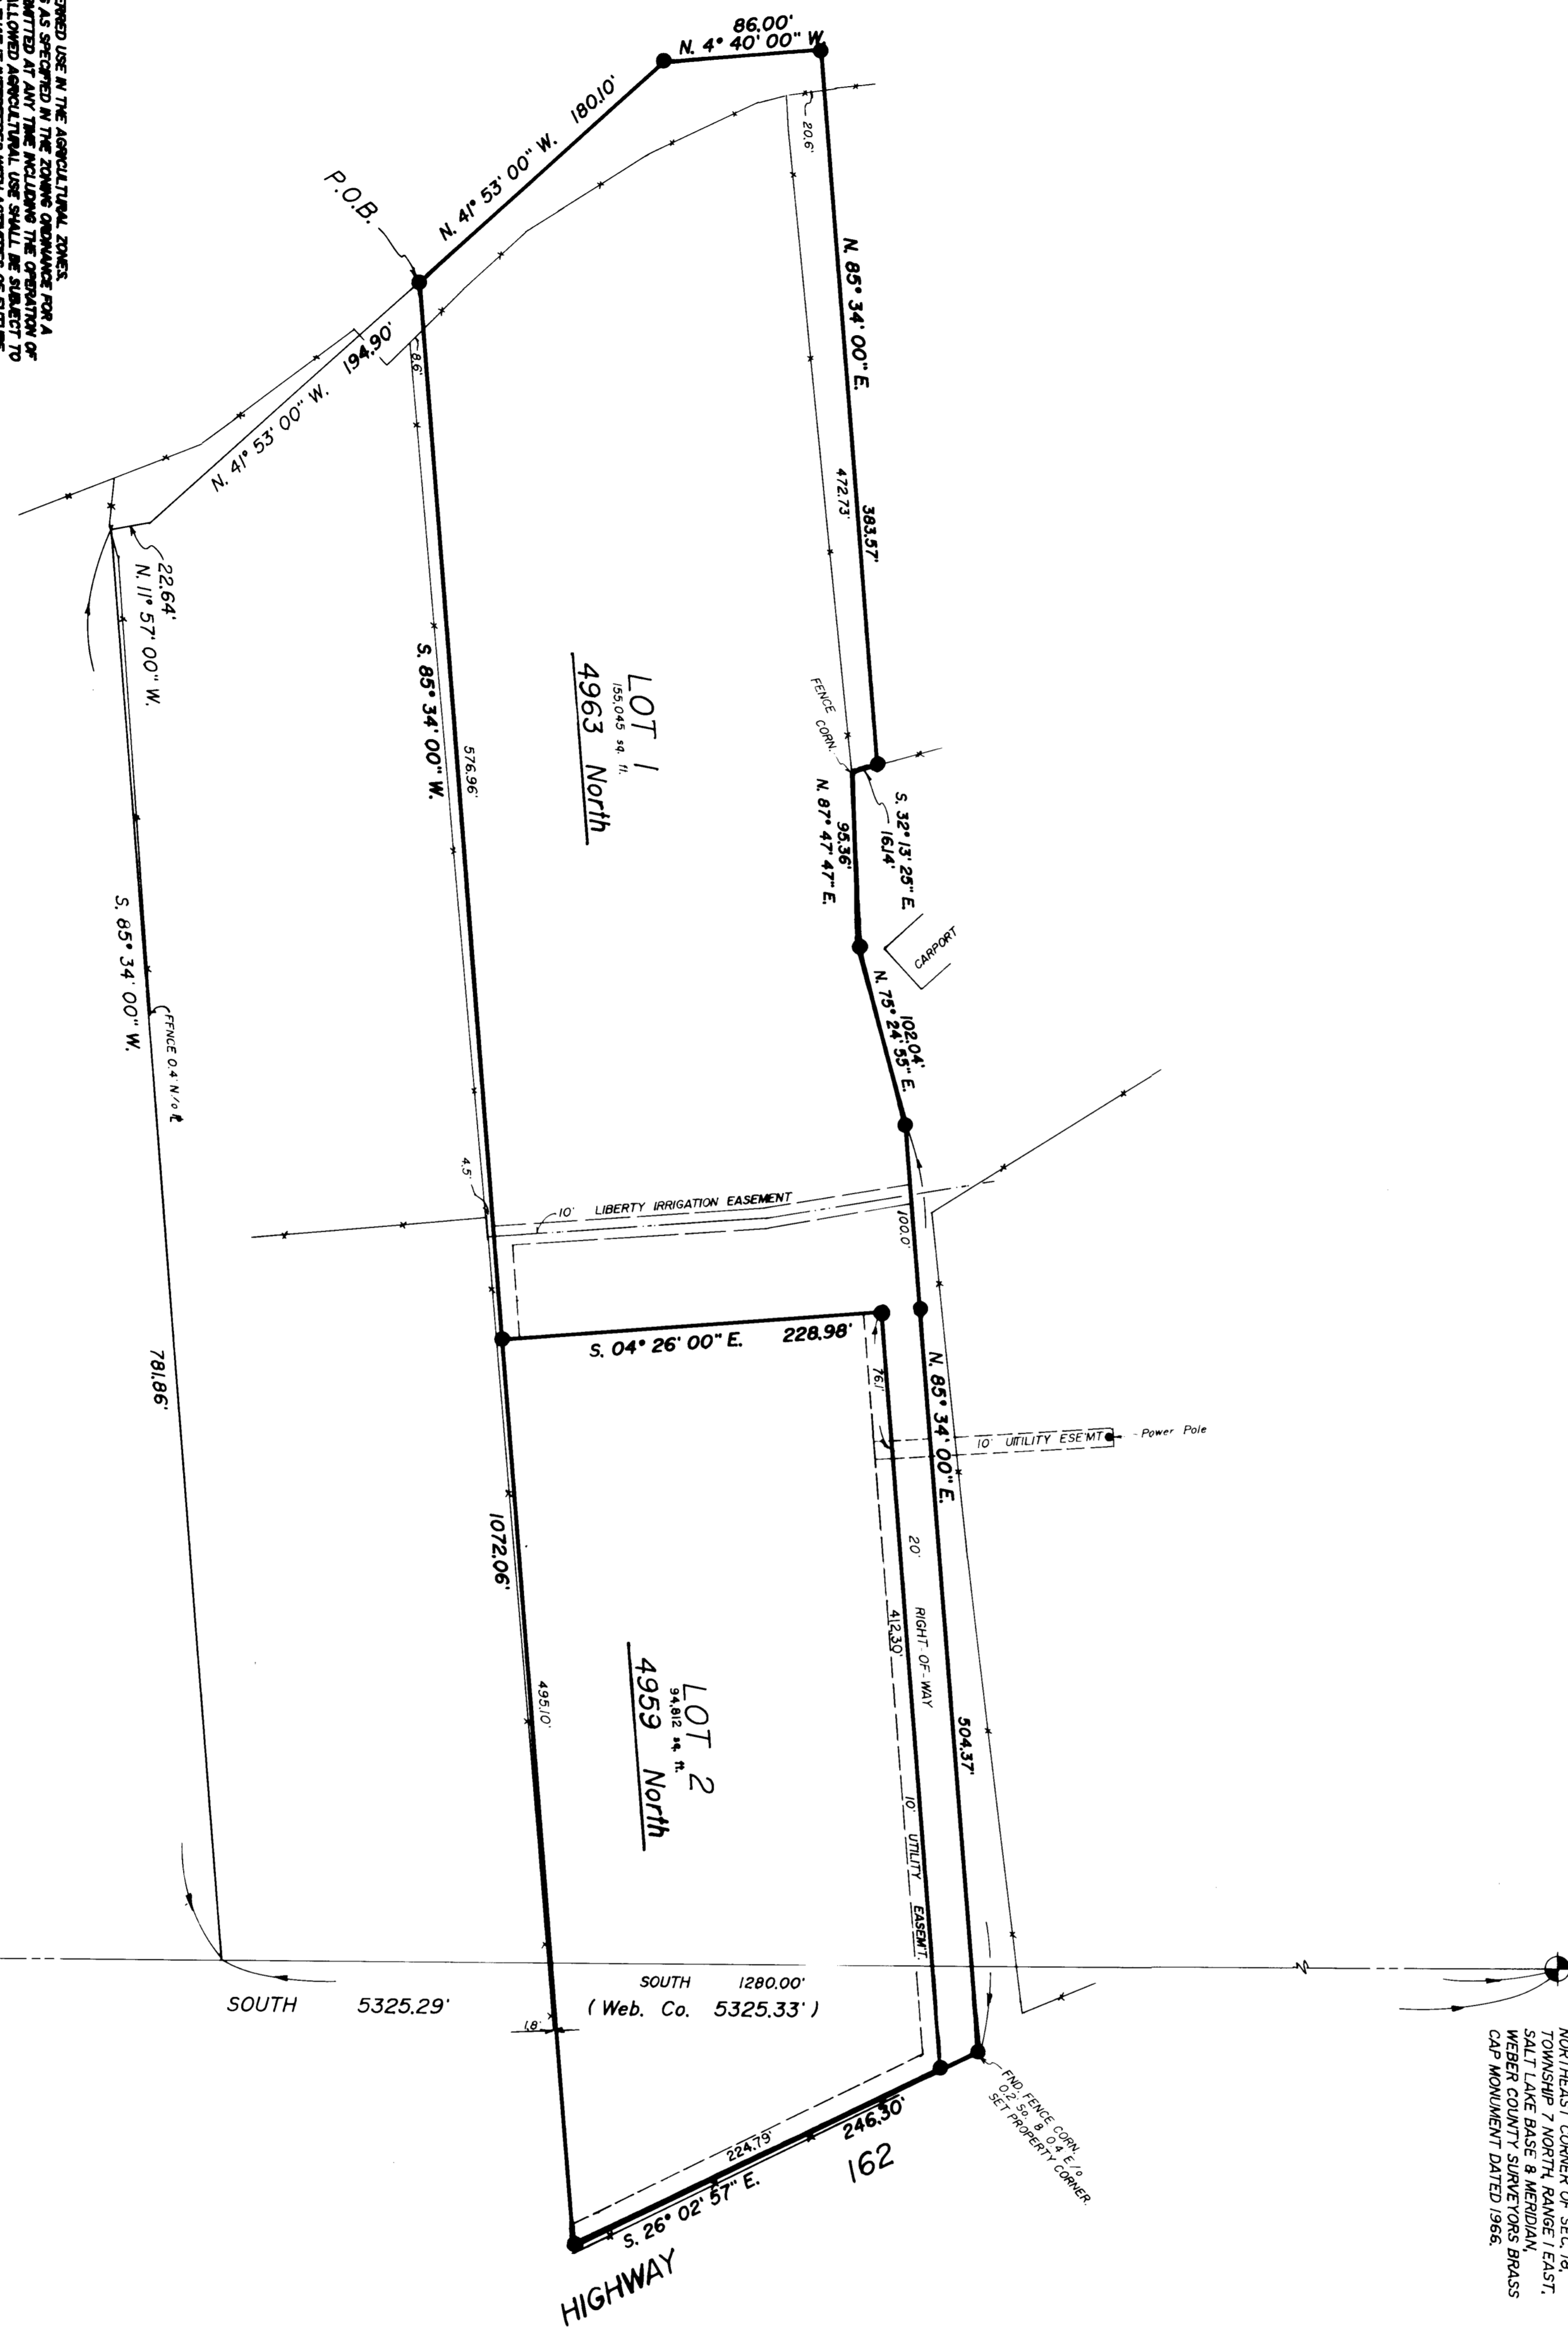

BOUNDARY DESCRIPTION
A PART OF THE NORTHEAST QUARTER OF SECTION 18, AND PART OF THE NORTHEAST QUARTER OF SECTION 19, TOWNSHIP 7 NORTH, RANGE 1 EAST, SALT LAKE BASE AND MERIDIAN, BEGINS AT A POINT WHICH BEARS SOUTH 1280.00 FEET ALONG THE EAST LINE OF SAID NORTHEAST QUARTER SECTION, S. 

SURVEYOR'S CERTIFICATE
I, CYNTHIA L. ROBINETT DO HEREBY CERTIFY THAT I AM A REGISTERED LAND SURVEYOR IN THE STATE OF UTAH, AND THAT I HAVE MADE A SURVEY OF THE GROUND AND FROM RECORDS OF THE WEBER COUNTY RECORDERS OFFICE AS DESCRIBED ABOVE AND AS SHOWN PER THIS PLAN.

Prepared by:
CYNTHIA L. ROBINETT
REGISTERED LAND SURVEYOR
CENTRAL UTAH
REGISTERED
DATED 7/14/20

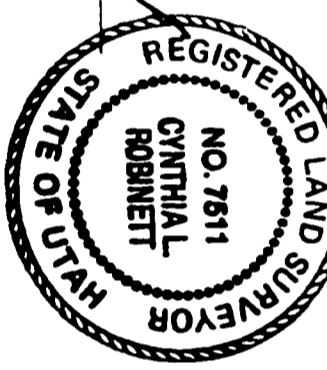

CONSTRUCTION & LAND SURVEYORS INC.
OGDEN, UTAH

NORTHEAST CORNER OF SEC. 18, TOWNSHIP 7 NORTH, RANGE 1 EAST, SALT LAKE BASE & MERIDIAN, BEARS CAP MONUMENT DATED 1986

RECEIVED
APR 28 1994
KENT PITTS
2701 WASHINGTON BLVD.
OGDEN, UTAH 84401
(801) 399-4935

CONSTRUCTION & LAND SURVEYORS
2701 WASHINGTON BLVD.
OGDEN, UTAH 84401
(801) 399-4935
KENT PITTS
SURVEY LOCATION:
NE 1/4 SEC. 18, & NW 1/4 SEC. 17,
SALT LAKE BASE & MERIDIAN
SURVEY DATE: 7/14/20
JOB NO. 23.33-14